DISTRICT	COUNTY	ROUTE	PROJECT	SHEET
8-0	DAUPHIN	PA 283		
LONDONDERRY TOWNSHIP				
REVISIONS				

TABULATION OF QUANTITIES		
ITEM	UNIT	QUANTITY
POST MOUNTED SIGNS, TYPE A, LOGO	SQ.FT.	
POST MOUNTED SIGNS, TYPE B, LOGO	SQ.FT.	
POST MOUNTED SIGNS, TYPE C, LOGO	SQ.FT.	–
BREAKAWAY SYSTEMS	EACH	
* STEEL S OR W BEAM POSTS	LBS.	
LOGO SIGN MOUNTING	EACH	
REMOVAL OF POST MOUNTED MOTORIST SERVICE SIGNS, TYPES B, C & F	L.S.	

* APPROXIMATE QUANTITY FOR INFORMATION ONLY

SYMBOLS

- ○ *Existing Sign to Remain*
- △ *Existing Sign to be Removed*
- □ *Existing Sign Reset as Shown*
- ● NEW SIGN
- × FUTURE SIGN
- Ø *Existing Utility Pole*

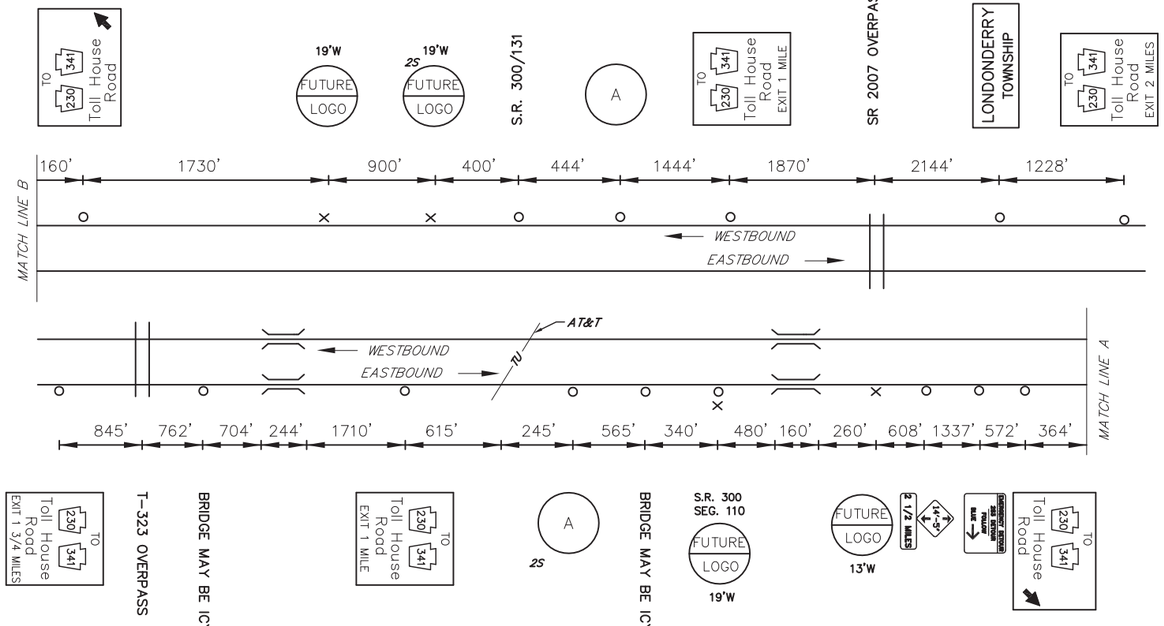

MAINLINE SCHEMATIC
NOT TO SCALE

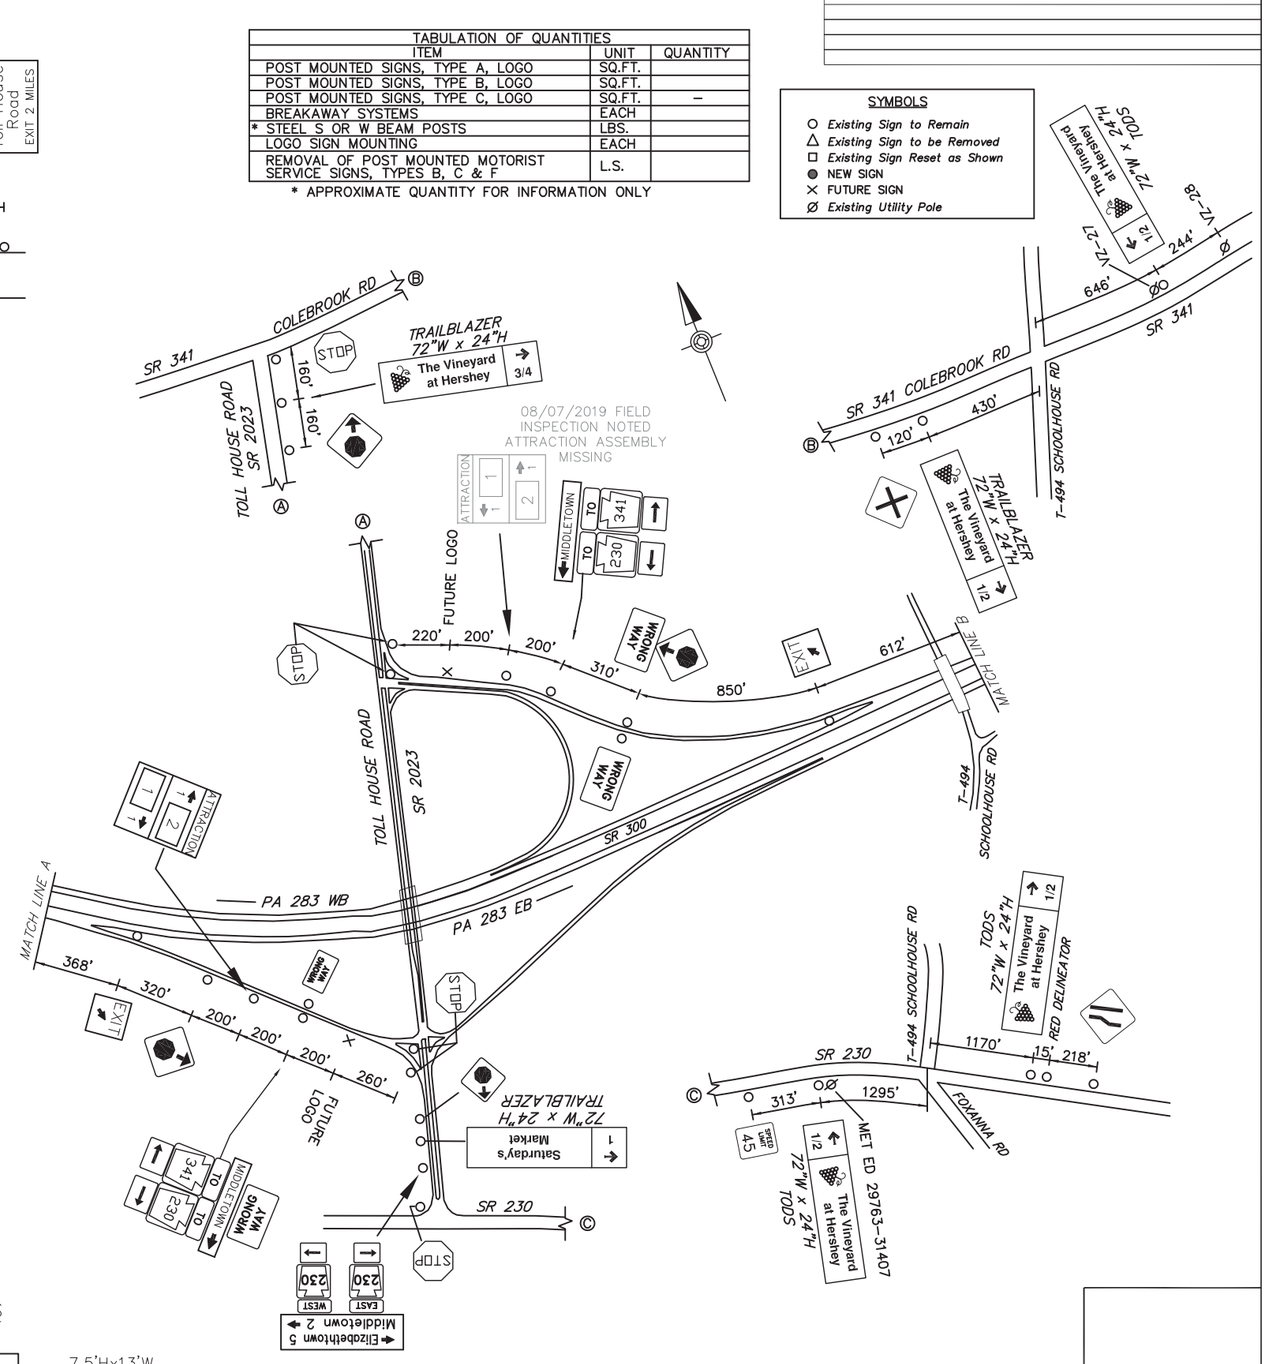

SCHEMATIC PLAN
NOT TO SCALE

LEGEND

2S – GUIDE RAIL

FREEWAY LANE CLOSURES & RESTRICTIONS
ONLY PERMITTED BETWEEN 9:00 PM AND
6:00 AM MONDAY THRU FRIDAY.
DO NOT WORK DURING HOLIDAY PERIODS.

TOLL HOUSE ROAD SPECIFIC INFORMATION PANEL			
LEGEND	DIRECTION	BUSINESS	LOGO. NO.
ATTRACTION	EB/WB	SATURDAY'S MARKET	1
		VINEYARD AT HERSHEY	2

EB SIGNS

7.5'Hx13'W
FUTURE 14'H
W14x30 A572
B650 – #2, #2

ATTRACTION NEXT RIGHT 1 2

WB SIGNS

ATTRACTION NEXT RIGHT 1 2

7.5'Hx13'W
FUTURE 14'H
W14x30 A572
B650 – #2, #2

283
SR 2023
TOLL HOUSE ROAD

D:\2015_ED\87-215976-01\MW\PSE\AS-BUILT DRAWINGS\PENNDOT DISTRICT 8\DAUPHIN - 22\10-XX SHTXX-PA283_TOLLHOUSE PLAN
August 26, 2019 12:09 PM