DISTRICT	COUNTY	ROUTE	PROJECT	SHEET
9-0	FULTON	I-70		
BUSH CREEK TOWNSHIP				
REVISIONS				

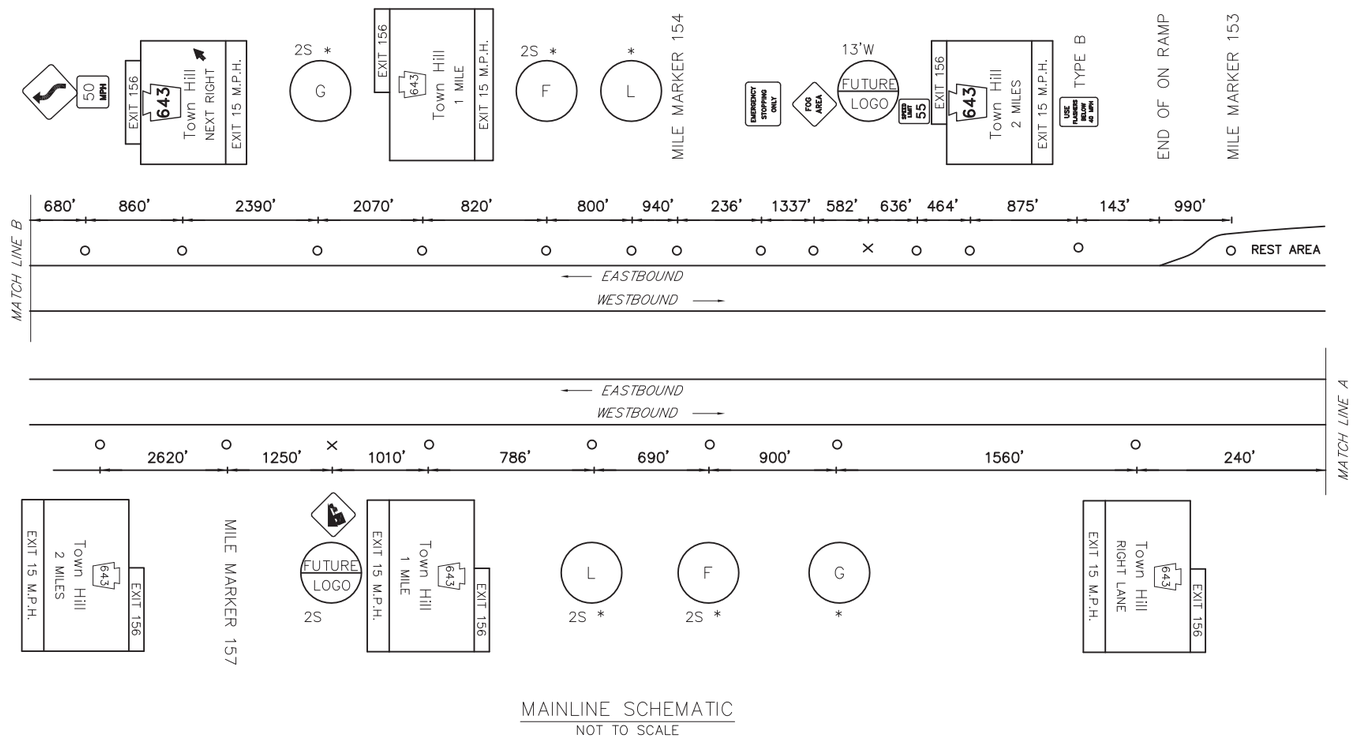

MAINLINE SCHEMATIC
NOT TO SCALE

TABULATION OF QUANTITIES		
ITEM	UNIT	QUANTITY
POST MOUNTED SIGNS, TYPE A, LOGO	SQ.FT.	
POST MOUNTED SIGNS, TYPE B, LOGO	SQ.FT.	
POST MOUNTED SIGNS, TYPE C, LOGO	SQ.FT.	
BREAKAWAY SYSTEMS	EACH	
* STEEL S OR W BEAM POSTS	LBS.	
LOGO SIGN MOUNTING	EACH	
REMOVAL OF POST MOUNTED MOTORIST SERVICE SIGNS, TYPES A & E	EACH	
REMOVAL OF POST MOUNTED MOTORIST SERVICE SIGNS, TYPES B, C & F	L.S.	

* APPROXIMATE QUANTITY FOR INFORMATION ONLY

SYMBOLS

- ○ *Existing Sign to Remain*
- △ *Existing Sign to be Removed*
- □ *Existing Sign Reset as Shown*
- ● NEW SIGN
- × FUTURE SIGN
- Ø *Existing Utility Pole*

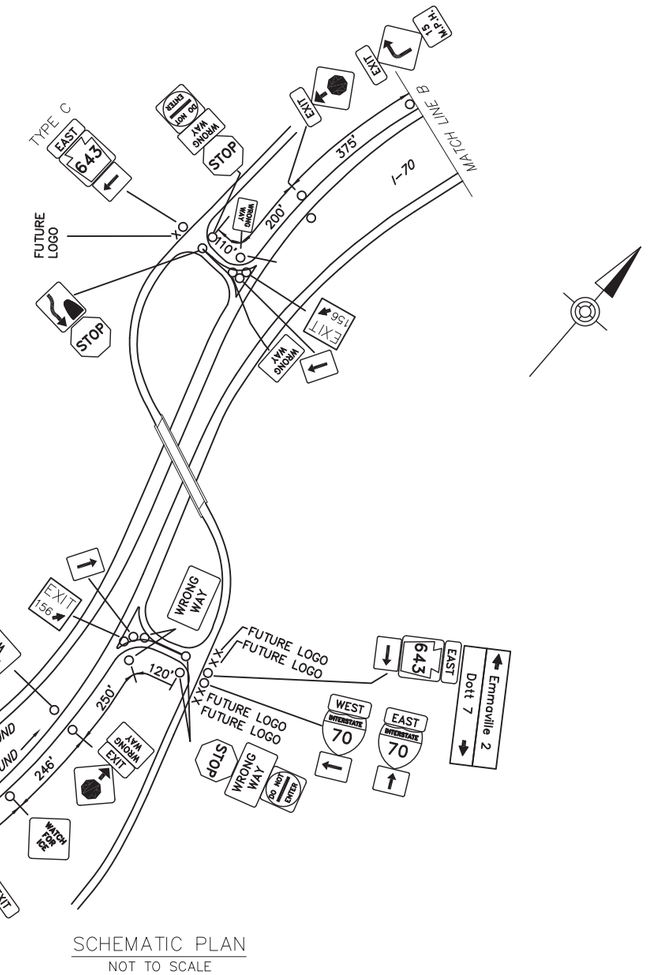

SCHEMATIC PLAN
NOT TO SCALE

LEGEND

2S – GUIDE RAIL

* – NO LOGOS, NO SPECIFIC SERVICE

[ ] – BLANK OVERLAY COVERING TYPE OF SERVICE

EXIT 156 SPECIFIC INFORMATION PANEL			
LEGEND	SIGN NUMBER	BUSINESS	LOGO. NO.
GAS	EB/WB		
FOOD	EB/WB		
LODGING	EB/WB		

EB SIGNS

G
6'Hx16'W
FUTURE 10'H
W8x21
TYPE III
B525 – #2, #1
INSTALLED 1/9/89

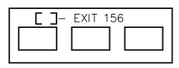

F
6'Hx13'W
FUTURE 10'H
W10x26
TYPE III
B650 – #1, #1
INSTALLED 1/9/89

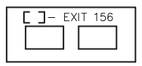

L
6'Hx13'W
FUTURE 12'H
W8x21
TYPE III
B525 – #1, #1
INSTALLED 1/9/89

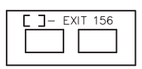

WB SIGNS

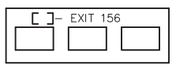

G
6'Hx16'W
FUTURE 12'H
W8x21
TYPE III
B525 – #3, #2
INSTALLED 1/9/89

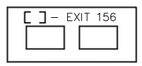

F
6'Hx13'W
FUTURE 10'H
W8x21
TYPE III
B525 – #1, #1
INSTALLED 1/9/89

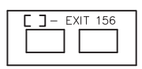

L
6'Hx13'W
FUTURE 10'H
W10x26
TYPE III
B650 – #2, BURIED
INSTALLED 1/9/89

INTERSTATE 70
TOWN HILL
EXIT 156

D:\2015\228\12597G-01\MVPSE\AS-BUILT DRAWINGS\PENNDOT DISTRICT 09\FULTON - 09\I-XX SHTXX-70_EXIT 156 PLAN
August 14, 2019 3:35 PM