DISTRICT	COUNTY	ROUTE	PROJECT	SHEET
3-0	COLUMBIA	I-80		

BORO OF BLOOMSBURG & HEMLOCK TOWNSHIP

REVISIONS

TABULATION OF QUANTITIES		
ITEM	UNIT	QUANTITY
POST MOUNTED SIGNS, TYPE A, LOGO	SQ.FT.	–
POST MOUNTED SIGNS, TYPE B, LOGO	SQ.FT.	–
POST MOUNTED SIGNS, TYPE C, LOGO	SQ.FT.	–
BREAKAWAY SYSTEMS	EACH	–
* STEEL S OR W BEAM POSTS	LBS.	–
LOGO SIGN MOUNTING	EACH	–
FLAT SHEET PANEL REPLACEMENT	SQ.FT.	–
EXTRUDED PANEL REPLACEMENT	SQ.FT.	–
REMOVAL OF POST MOUNTED MOTORIST SERVICE SIGNS, TYPES B, C & F	L.S.	–

* APPROXIMATE QUANTITY FOR INFORMATION ONLY

SYMBOLS

- ○ *Existing Sign to Remain*
- △ *Existing Sign to be Removed*
- □ *Existing Sign Reset as Shown*
- ● NEW SIGN
- × FUTURE SIGN
- Ø *Existing Utility Pole*

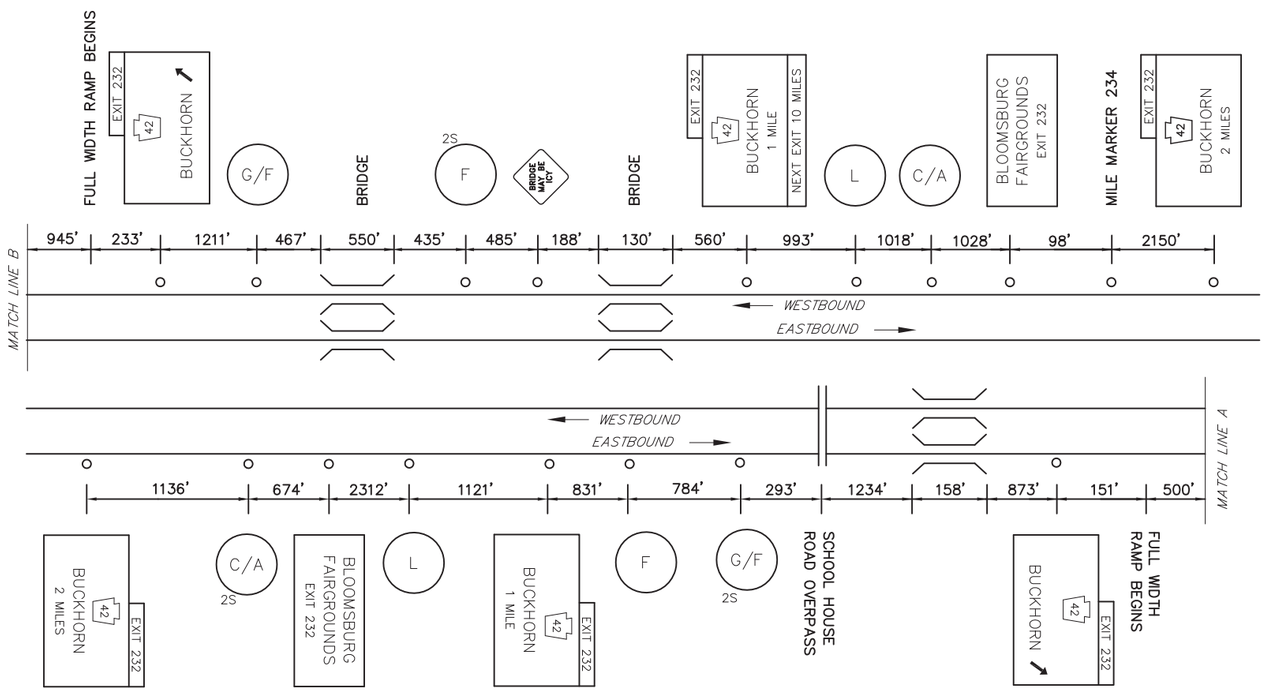

MAINLINE SCHEMATIC
NOT TO SCALE

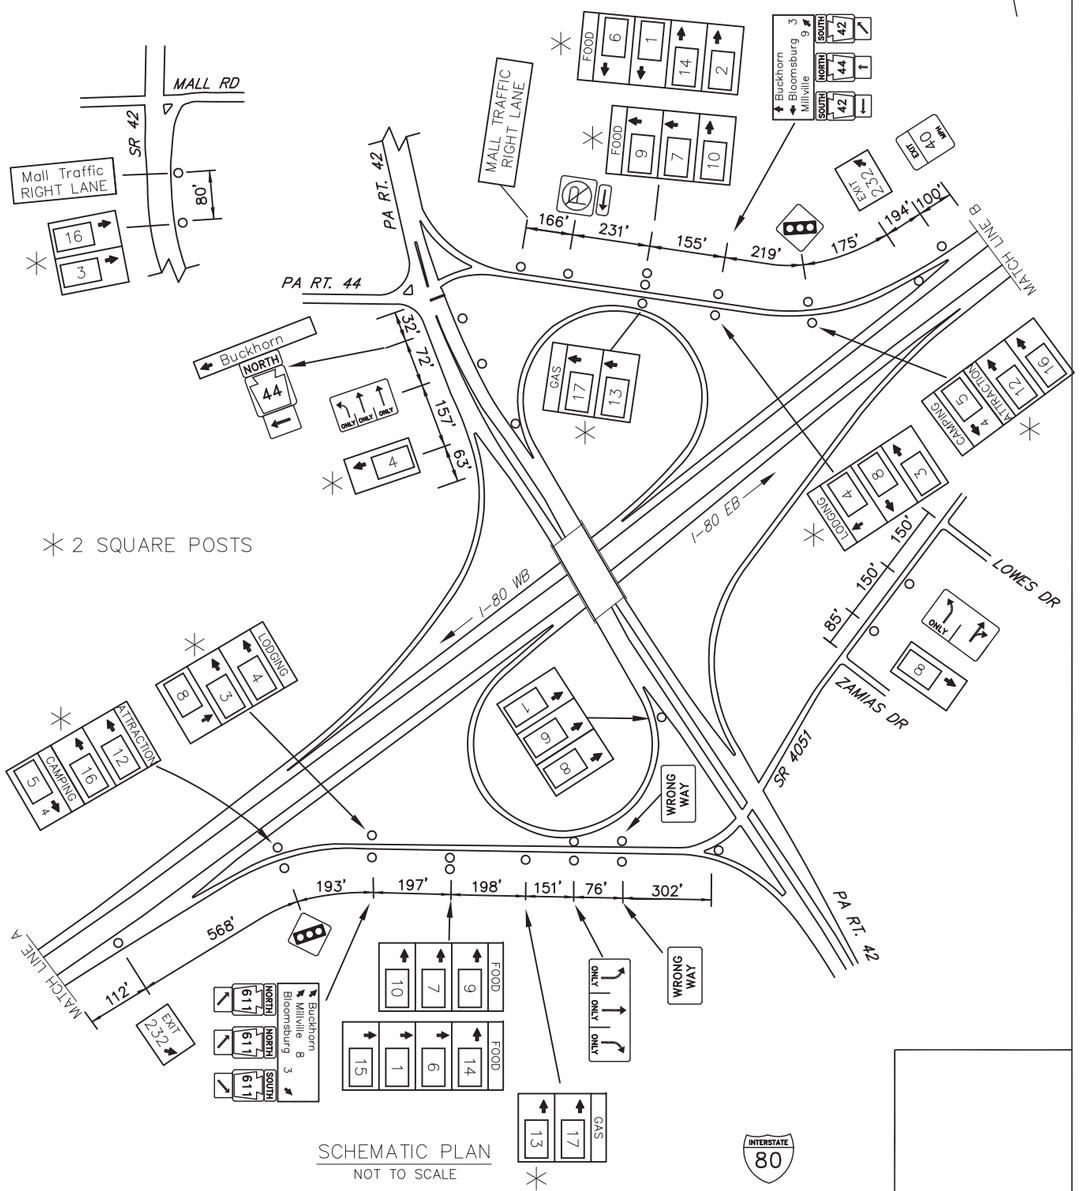

SCHEMATIC PLAN
NOT TO SCALE

INTERSTATE 80

BUCKHORN

EXIT 232

LEGEND

2S – GUIDE RAIL

EXIT 232 SPECIFIC INFORMATION PANEL			
LEGEND	DIRECTION	BUSINESS	LOGO. NO.
FOOD	EB/WB	PANERA BREAD	1
		OLIVE GARDEN	6
		SUBWAY	7
		COUNTRY PRIDE RESTAURANT (24 HOURS)	9
		CRACKER BARREL	10
		PERKINS	14
	WB	RUBY TUESDAY	2
	EB	GOURMET BUFFET	15
LODGING	EB/WB	QUALITY INN	3
		HOLIDAY INN EXPRESS	4
		COMFORT SUITES	8
CAMPING	EB/WB	INDIAN HEAD	5
GAS	EB/WB	SHELL (24 HOURS)	13
		EXXON	17
ATTRACTION	EB/WB	COLUMBIA MALL	12
		THE LUBE	16

EB SIGNS

12'Hx13'W
FUTURE 12'H
W8x18 A572
3M TYPE III
UNKN, B525–#3

GAS – EXIT 232: 17 13
FOOD – EXIT 232: 6

10'Hx19'W
W10x22 A572
3M TYPE III
B650 – #1, #1

FOOD – EXIT 232: 14 1 15 / 7 9 10

10'Hx13'W
12' TOP SECTION
W8x21 A572
3M TYPE III
B525 – #1, #1

LODGING – EXIT 232: 4 3 / 8

12'Hx13W
FUTURE 15'H
W14x30 A572
3M TYPE III
B650 – #2, #2

CAMPING – EXIT 232: 5
ATTRACTION–EXIT 232: 12 16

WB SIGNS

GAS – EXIT 232: 13 17
FOOD – EXIT 232: 6

12'Hx13'W
FUTURE 12'H
W8x18 A572
3M TYPE III
B525 – #2, #3

FOOD – EXIT 232: 9 7 10 / 1 14 2

10'Hx19'W
W12x26
3M TYPE III
B650 – #2, #1

LODGING – EXIT 232: 4 3 / 8

10'Hx13'W
12' TOP SECTION
W8x21 A572
3M TYPE III
B525 – #1, #1

CAMPING – EXIT 232: 5
ATTRACTION–EXIT 232: 12 16

12'Hx13'W
FUTURE 16'H
W14x30 A572
3M TYPE III
B650 – #2, #2

D:\2015_JOBS\215076-01\WK\PSE-AS-BUILT DRAWINGS\PENNDOT DISTRICT 03\COLUMBIA - I91-10-XX SHT00-180_EXIT 232 PLAN
July/19/2019 3:05 PM