DISTRICT	COUNTY	ROUTE	PROJECT	SHEET
4-0	LUZERNE	I-80		
FOSTER TWP. & BOROUGH OF WHITE HAVEN				
5-0	CARBON			
EAST SIDE BOROUGH				
REVISIONS				

TABULATION OF QUANTITIES		
ITEM	UNIT	QUANTITY
POST MOUNTED SIGNS, TYPE A, LOGO	SQ.FT.	
POST MOUNTED SIGNS, TYPE B, LOGO	SQ.FT.	
POST MOUNTED SIGNS, TYPE C, LOGO	SQ.FT.	
BREAKAWAY SYSTEMS	EACH	
* STEEL S OR W BEAM POSTS	LBS.	
LOGO SIGN MOUNTING	EACH	
REMOVAL OF POST MOUNTED MOTORIST SERVICE SIGNS, TYPES B, C & F	L.S.	

* APPROXIMATE QUANTITY FOR INFORMATION ONLY

SYMBOLS

- ○ *Existing Sign to Remain*
- △ *Existing Sign to be Removed*
- □ *Existing Sign Reset as Shown*
- ● NEW SIGN
- × FUTURE SIGN
- Ø *Existing Utility Pole*

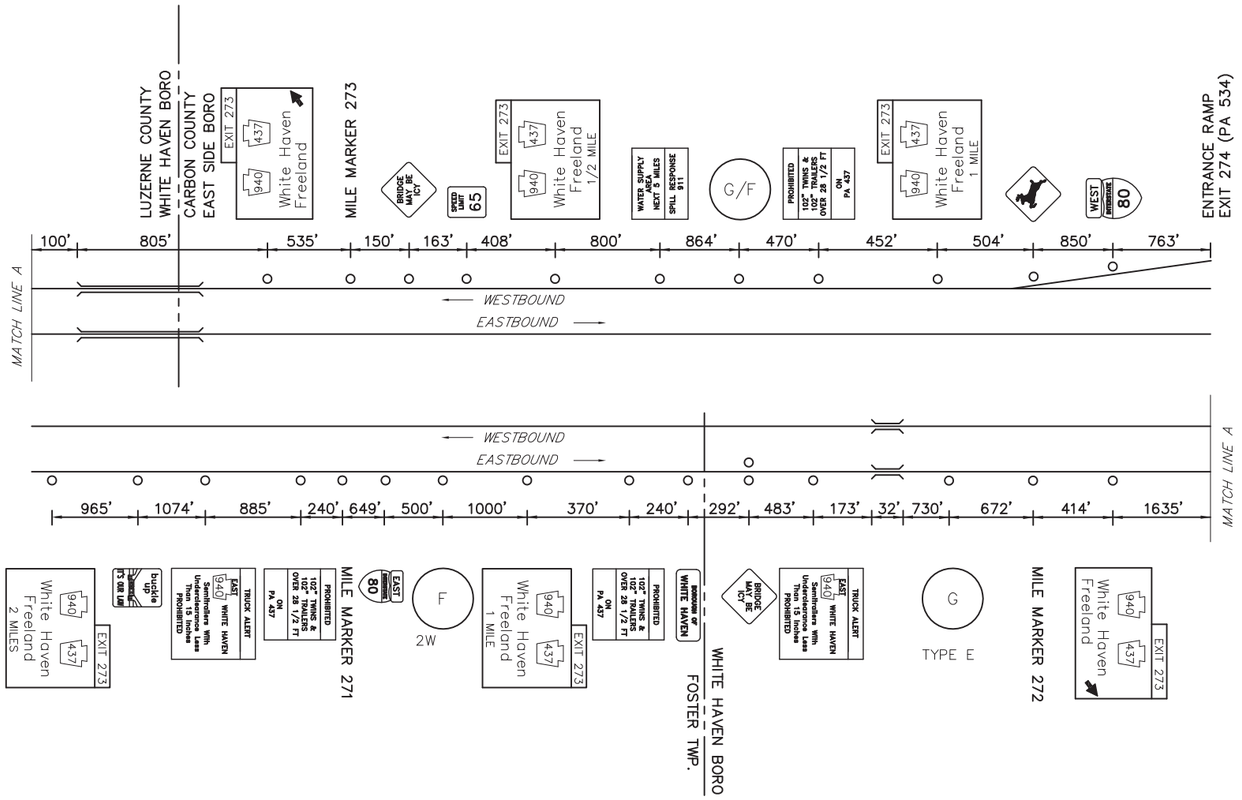

MAINLINE SCHEMATIC
NOT TO SCALE

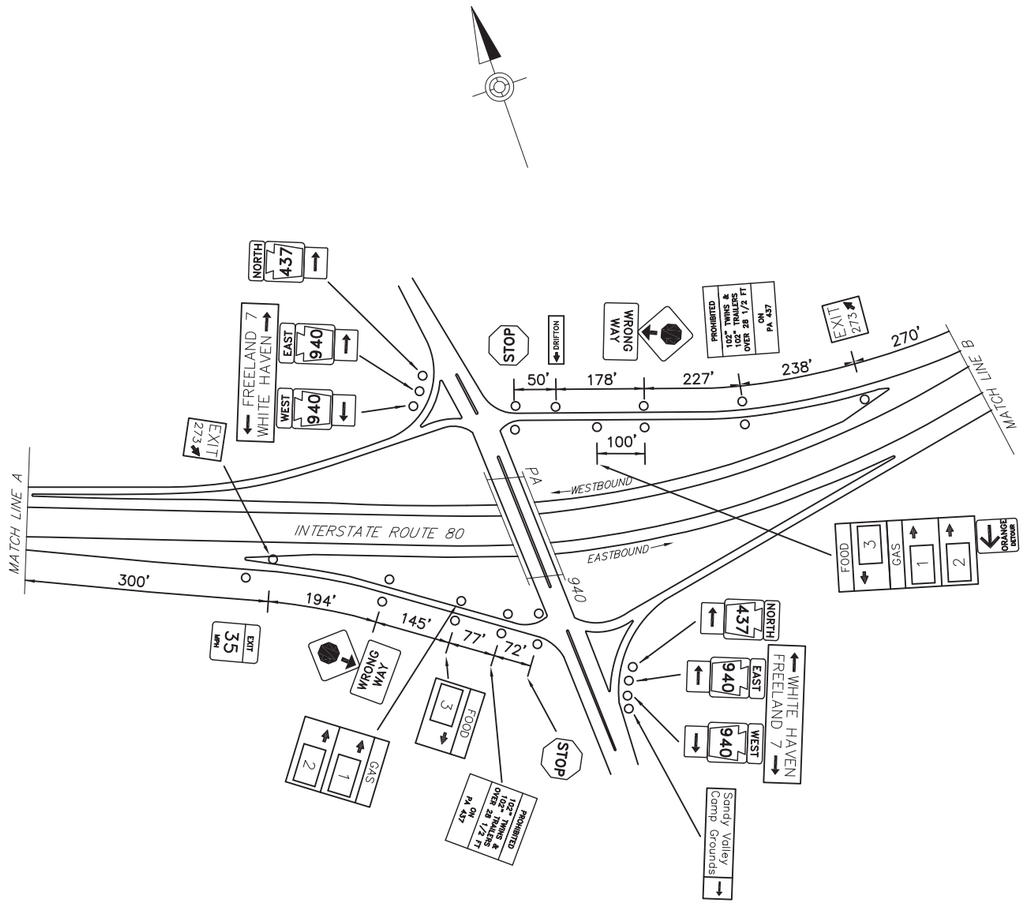

SCHEMATIC PLAN
NOT TO SCALE

LEGEND

2W – GUIDE RAIL

DO NOT CLOSE OR RESTRICT TRAVEL LANES
BETWEEN 6:00 AM AND 9:00 AM, AND
BETWEEN 3:00 PM AND 6:00 PM, MONDAY THRU FRIDAY.
DO NOT WORK DURING HOLIDAY PERIODS.
DO NOT WORK DURING POCONO RACEWAY EVENT DATES.

EXIT 273 SPECIFIC INFORMATION PANEL			
LEGEND	DIRECTION	BUSINESS	LOGO. NO.
GAS	EB/WB	EXXON	1
		FUEL ONE	2
FOOD	EB/WB	POWERHOUSE EATERY	3

EB SIGNS

6'Hx13'W
TYPE E
6"x8" WOOD POSTS
3M TYPE III

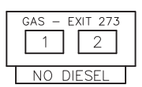

6'Hx13'W
FUTURE 16'H
W18x40
3M TYPE IX LEGEND
TYPE III BACKGROUND
B650 – #2, #1

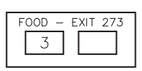

WB SIGNS

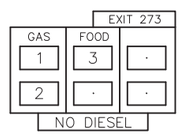

MAIN PANEL 10'Hx19'W
EXIT PANEL 2'Hx 8'W
W12x26
3M TYPE IX LEGEND
TYPE III BACKGROUND
B650 – #2, #2

INTERSTATE 80
WHITE HAVEN
EXIT 273

D:\2015_ED\E\215976-01\WW\PSE\AS-BUILT DRAWINGS\PENNDOT DISTRICT 04\LUZERNE - 40-10-XX SHTXX-180_EXIT 273 PLAN
August/7/2019 12:37 PM