| DISTRICT | COUNTY | ROUTE | PROJECT | SHEET |
|---|---|---|---|---|
| 3-0 | LYCOMING | I-180 | | |

MUNCY AND MUNCY CREEK TOWNSHIPS
REVISIONS

| TABULATION OF QUANTITIES | | |
|---|---|---|
| ITEM | UNIT | QUANTITY |
| POST MOUNTED SIGNS, TYPE A, LOGO | SQ.FT. | |
| POST MOUNTED SIGNS, TYPE B, LOGO | SQ.FT. | |
| POST MOUNTED SIGNS, TYPE C, LOGO | SQ.FT. | |
| BREAKAWAY SYSTEMS | EACH | |
| * STEEL S OR W BEAM POSTS | LBS. | |
| LOGO SIGN MOUNTING | EACH | |

* APPROXIMATE QUANTITY FOR INFORMATION ONLY

**SYMBOLS**

- ○ *Existing Sign to Remain*
- △ *Existing Sign to be Removed*
- □ *Existing Sign Reset as Shown*
- ● NEW SIGN
- × FUTURE SIGN
- Ø *Existing Utility Pole*

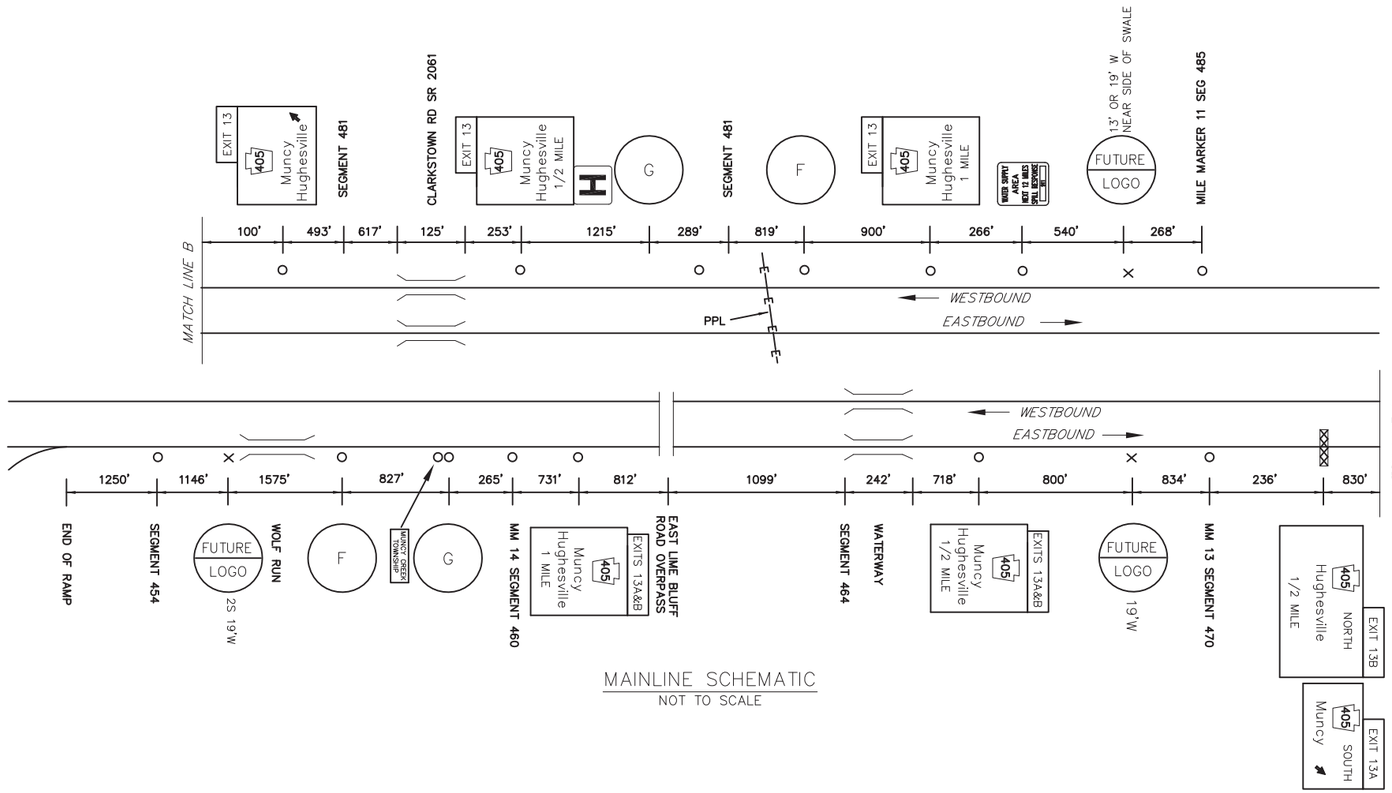


MAINLINE SCHEMATIC
NOT TO SCALE

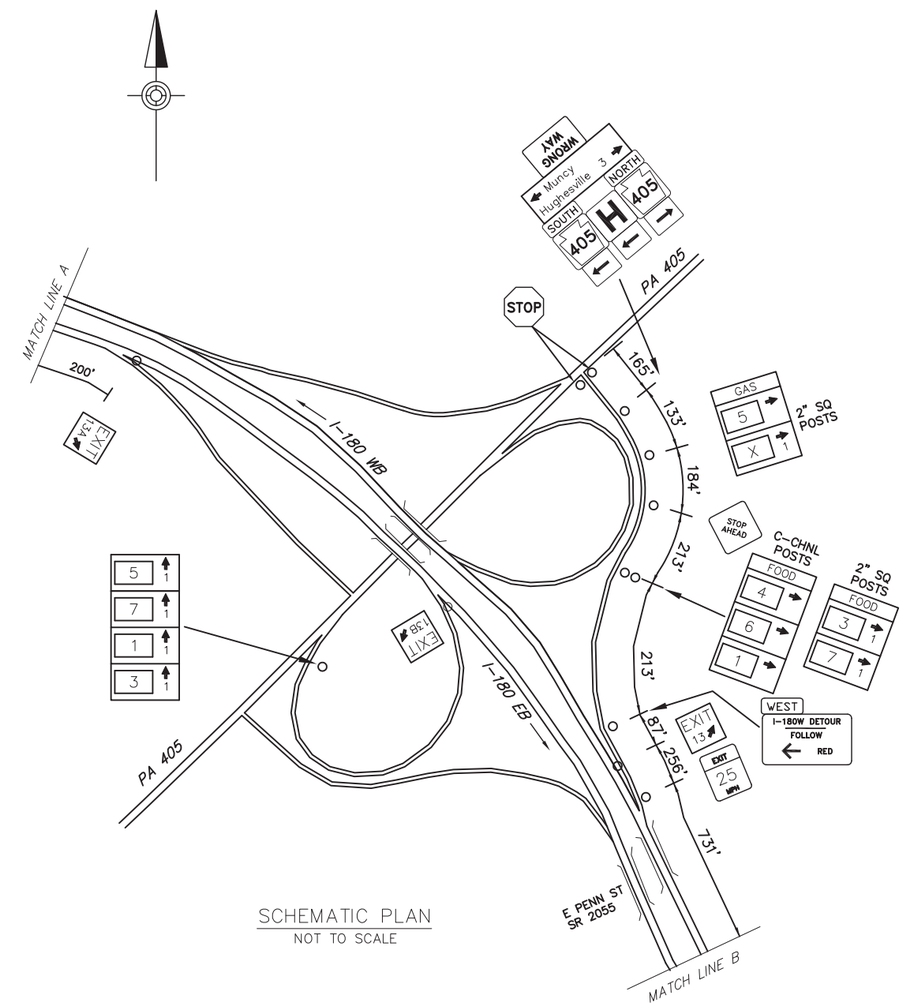


SCHEMATIC PLAN
NOT TO SCALE

## LEGEND

2S – GUIDE RAIL

| EXIT 13 SPECIFIC INFORMATION PANEL | | | |
|---|---|---|---|
| LEGEND | DIRECTION | BUSINESS | LOGO. NO. |
| FOOD | EB/WB | SUBWAY | 1 |
| | | DUNKIN' DONUTS | 3 |
| | | WENDY'S | 4 |
| | | SHEETZ | 6 |
| | | TACO BELL | 7 |
| | | | |
| GAS | EB/WB | SHEETZ (DIESEL) | 5 |
| | | | |
| | | | |

INTERSTATE 180

MUNCY/HUGHESVILLE

EXIT 13

D:\2015_JOBS\215076-01\HW\PSE\AS-BUILT DRAWINGS\PENNDOT DISTRICT 03\LYCOMING - 41\10-XX SHTXX-I180_EXIT 13 PLAN
October/22/2019 11:48 AM