DISTRICT	COUNTY	ROUTE	PROJECT	SHEET
3-0	LYCOMING	I-180		
MUNCY AND MUNCY CREEK TOWNSHIPS				
REVISIONS				

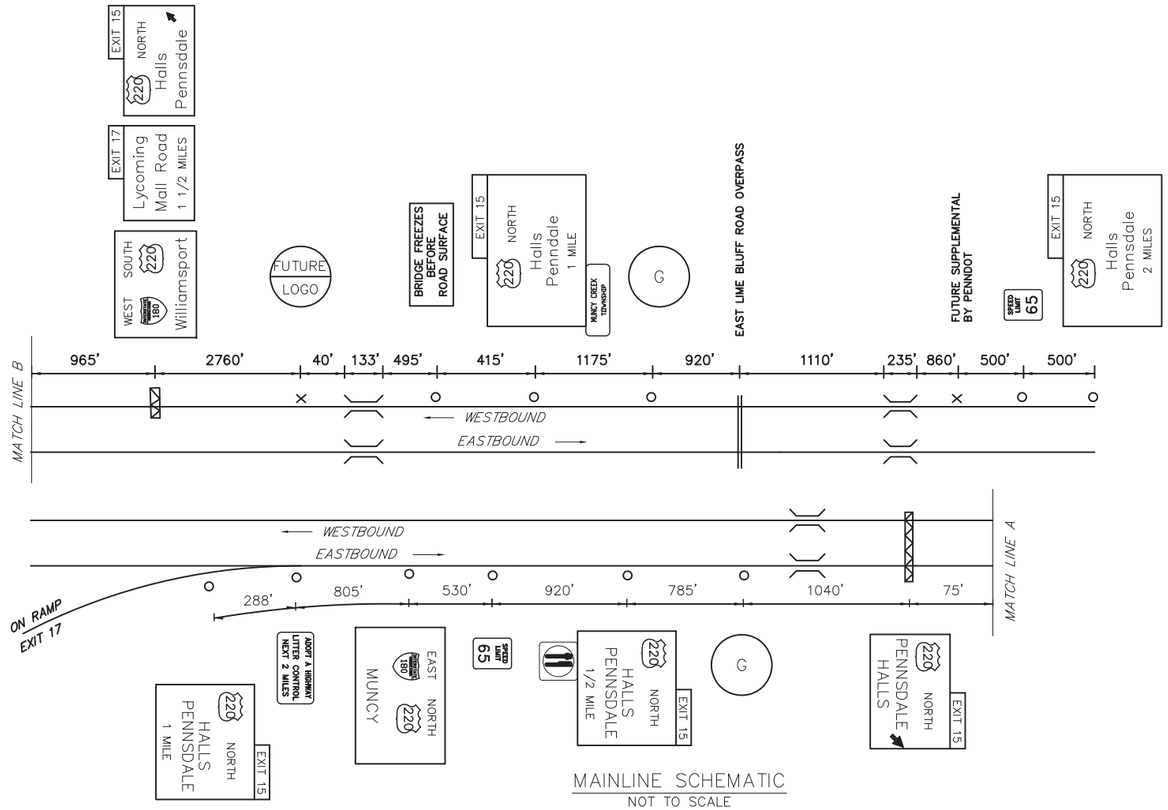

MAINLINE SCHEMATIC
NOT TO SCALE

TABULATION OF QUANTITIES		
ITEM	UNIT	QUANTITY
POST MOUNTED SIGNS, TYPE A, LOGO	SQ.FT.	—
POST MOUNTED SIGNS, TYPE B, LOGO	SQ.FT.	—
POST MOUNTED SIGNS, TYPE C, LOGO	SQ.FT.	—
BREAKAWAY SYSTEMS	EACH	—
* STEEL S OR W BEAM POSTS	LBS.	—
LOGO SIGN MOUNTING	EACH	—
FLAT SHEET PANEL REPLACEMENT	SQ.FT.	
EXTRUDED PANEL REPLACEMENT	SQ.FT.	
REMOVAL OF POST MOUNTED MOTORIST SERVICE SIGNS, TYPES B, C & F	L.S.	

* APPROXIMATE QUANTITY FOR INFORMATION ONLY

SYMBOLS

- ○ *Existing Sign to Remain*
- △ *Existing Sign to be Removed*
- □ *Existing Sign Reset as Shown*
- ● NEW SIGN
- × FUTURE SIGN
- Ø *Existing Utility Pole*

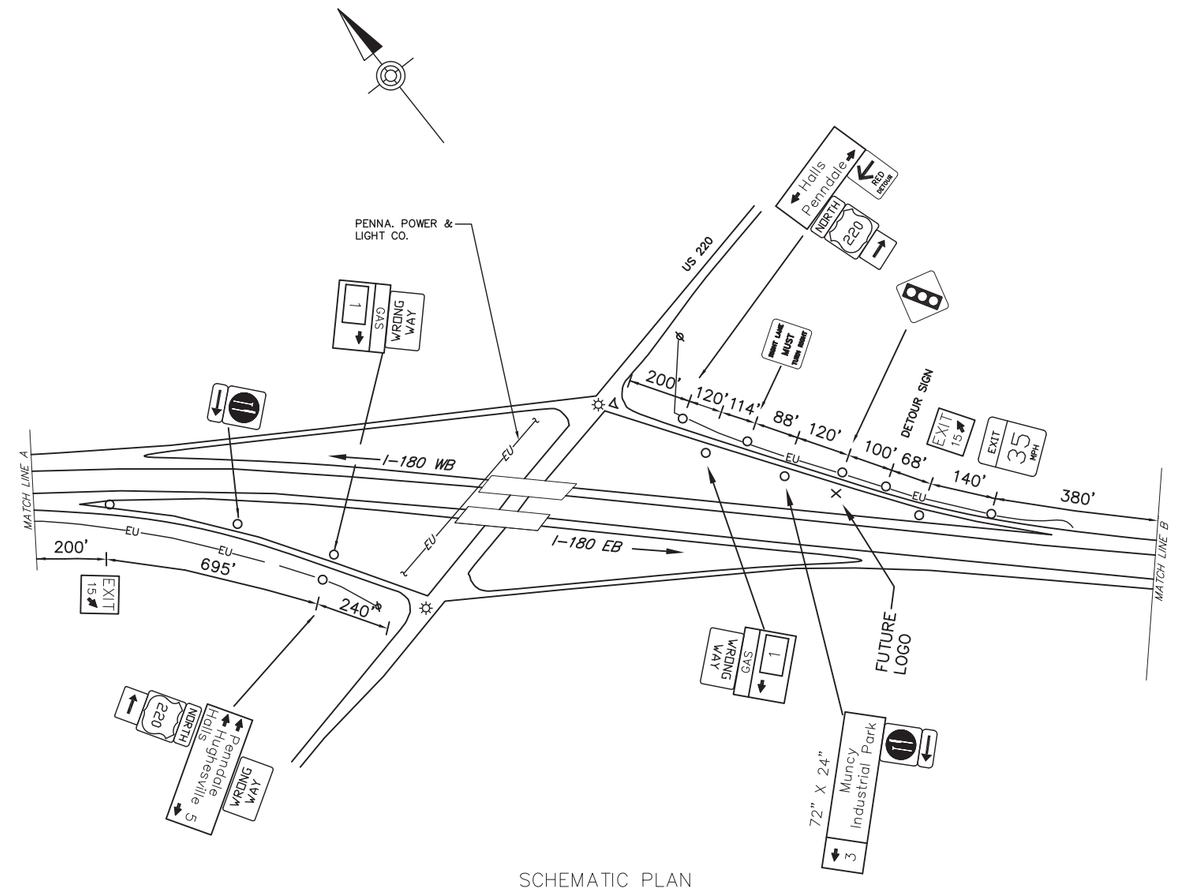

SCHEMATIC PLAN
NOT TO SCALE

EXIT 15		SPECIFIC INFORMATION PANEL	
LEGEND	DIRECTION	BUSINESS	LOGO. NO.
GAS	EB/WB	SUNOCO (DIESEL/24 HRS)	1

EB SIGNS

6'Hx13'W
FUTURE 12'H
W8x21 A572
3M TYPE III
B525 – #1, #2

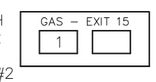

WB SIGNS

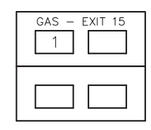

12'Hx13'W
W8x21 A572
3M TYPE III
BRKT 1 NOT STAMPED,
B525 – #1

INTERSTATE 180

US 220
HALLS/PENNSDALE
EXIT 15

D:\2015\2015\2150076-01\HW\PSE\AS-BUILT DRAWINGS\PENNDOT DISTRICT 03\LYCOMING - 41\10-XX SHTXX-180_EXIT 15 PLAN
July/25/2019 4:07 PM