DISTRICT	COUNTY	ROUTE	PROJECT	SHEET
3-0	LYCOMING	I-180		
LOYALSOCK TOWNSHIP				
REVISIONS				

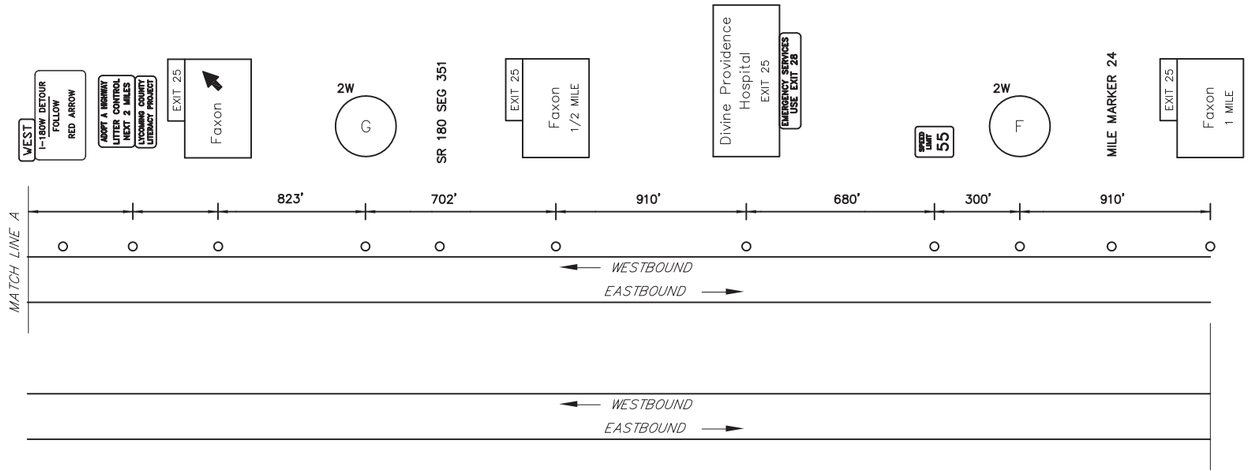

EASTBOUND NOT ELIGIBLE – INSUFFICIENT SPACE

MAINLINE SCHEMATIC
NOT TO SCALE

TABULATION OF QUANTITIES		
ITEM	UNIT	QUANTITY
POST MOUNTED SIGNS, TYPE A, LOGO	SQ.FT.	
POST MOUNTED SIGNS, TYPE B, LOGO	SQ.FT.	
POST MOUNTED SIGNS, TYPE C, LOGO	SQ.FT.	
BREAKAWAY SYSTEMS	EACH	
* STEEL S OR W BEAM POSTS	LBS.	
LOGO SIGN MOUNTING	EACH	

* APPROXIMATE QUANTITY FOR INFORMATION ONLY

SYMBOLS
- ○ *Existing Sign to Remain*
- △ *Existing Sign to be Removed*
- □ *Existing Sign Reset as Shown*
- ● NEW SIGN
- × FUTURE SIGN
- Ø *Existing Utility Pole*

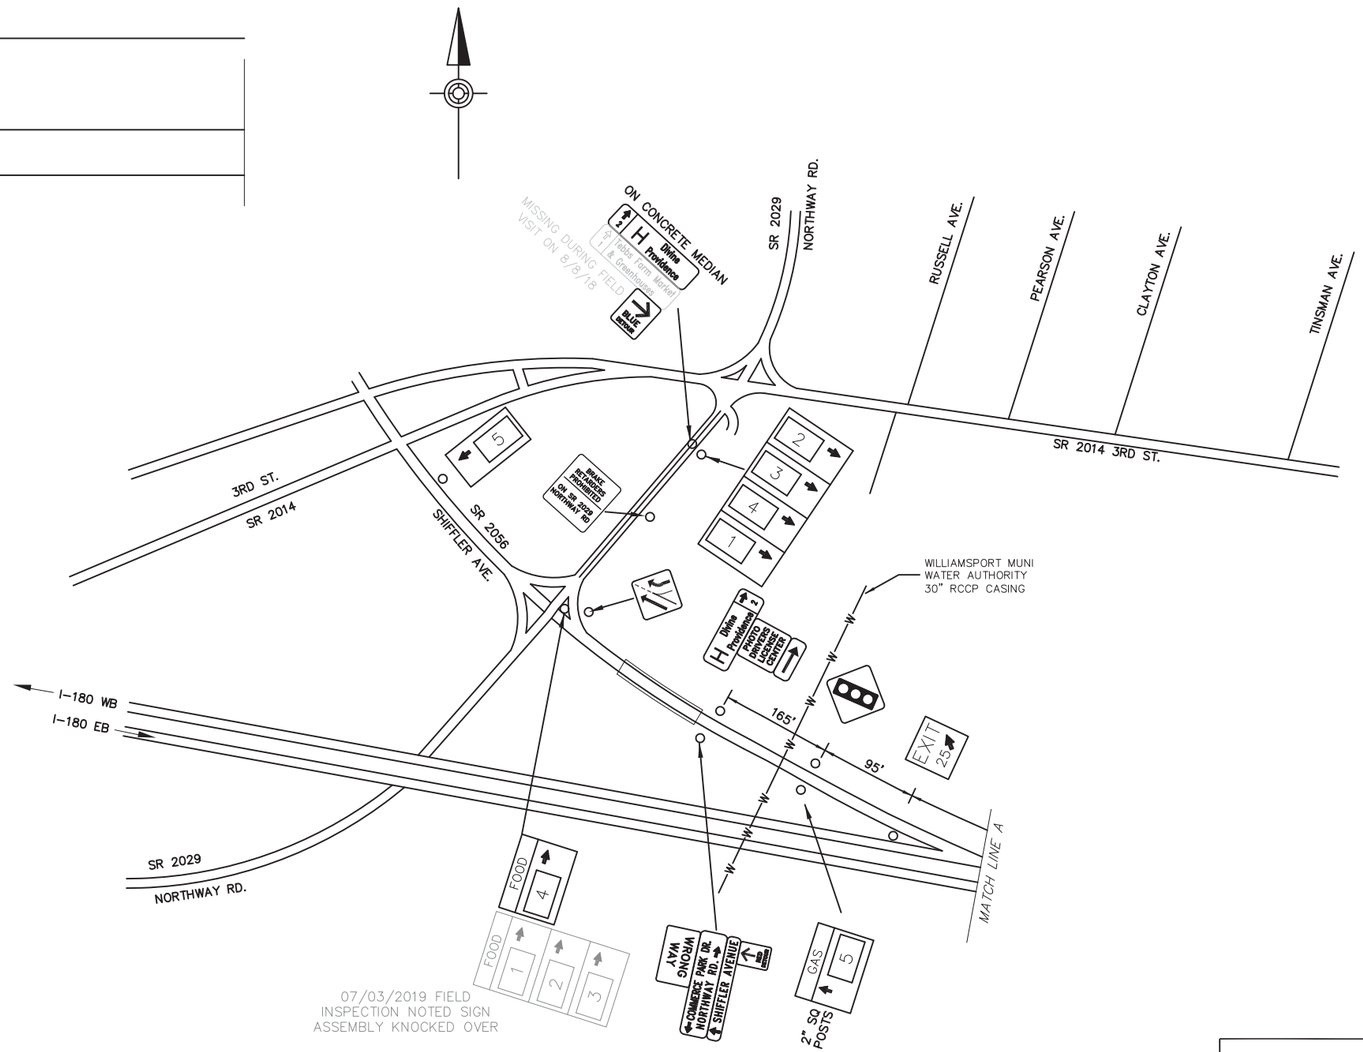

SCHEMATIC PLAN
NOT TO SCALE

LEGEND

2W – GUIDE RAIL

EXIT 25		SPECIFIC INFORMATION PANEL	
LEGEND	DIRECTION	BUSINESS	LOGO. NO.
FOOD	WB	OLIVE GARDEN	1
		DENNY'S (24 HOURS)	2
		McDONALD'S	3
		TACO BELL	4
GAS	WB	NITTANY MINIT MART (DIESEL)	5

WB SIGNS

6'Hx13'W
FUTURE 16'H
W18x40
TYPE IX LEGEND
TYPE III
BACKGROUND
B650 – #2, #2

14'Hx13'W
W10x26 A572
B650 – #1, #1

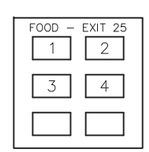

INTERSTATE 180
FAXON
EXIT 25

D:\2015JOBS\215076-01\HW\PSE\AS-BUILT DRAWINGS\PENNDOT DISTRICT 03\LYCOMING - 41\10-XX SHTXX-180_EXIT 25 PLAN
October/10/2019 1:46 PM