DISTRICT	COUNTY	ROUTE	PROJECT	SHEET
5-0	SCHUYLKILL	I-81		

PINEGROVE AND TREMONT TOWNSHIPS

REVISIONS

TABULATION OF QUANTITIES		
ITEM	UNIT	QUANTITY
POST MOUNTED SIGNS, TYPE A, LOGO	SQ.FT.	
POST MOUNTED SIGNS, TYPE A, LOGO (MODIFIED)	SQ.FT.	–
POST MOUNTED SIGNS, TYPE C, LOGO	SQ.FT.	
BREAKAWAY SYSTEMS	EACH	–
* STEEL S OR W BEAM POSTS	LBS.	–
LOGO SIGN MOUNTING	EACH	–
LOGO SIGN MOUNTING, RESET	EACH	–
REMOVAL OF POST MOUNTED MOTORIST SERVICE SIGNS, TYPES A & E	EACH	
REMOVAL OF POST MOUNTED MOTORIST SERVICE SIGNS, TYPES B, C & F	L.S.	

* APPROXIMATE QUANTITY FOR INFORMATION ONLY

SYMBOLS

- *Existing Sign to Remain*
- *Existing Sign to be Removed*
- *Existing Sign Reset as Shown*
- *Existing Sign Foundation*
- NEW SIGN
- FUTURE SIGN
- *Existing Utility Pole*

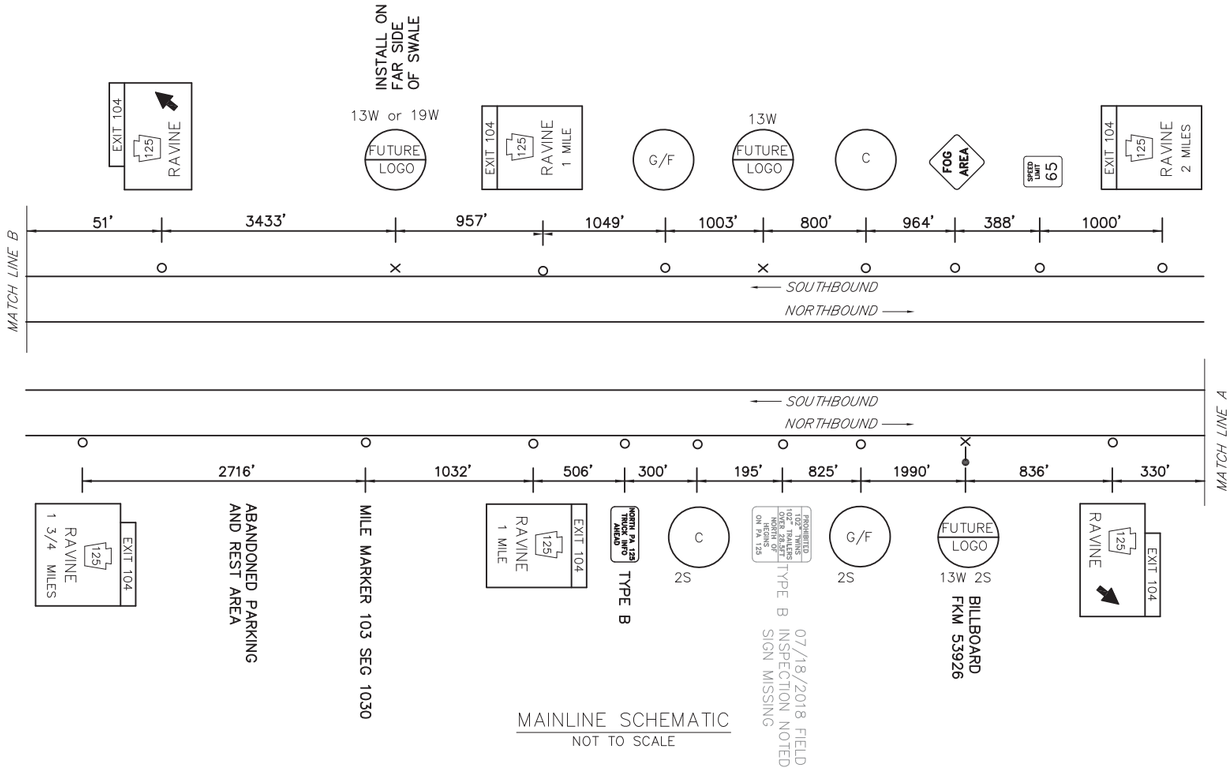

MAINLINE SCHEMATIC
NOT TO SCALE

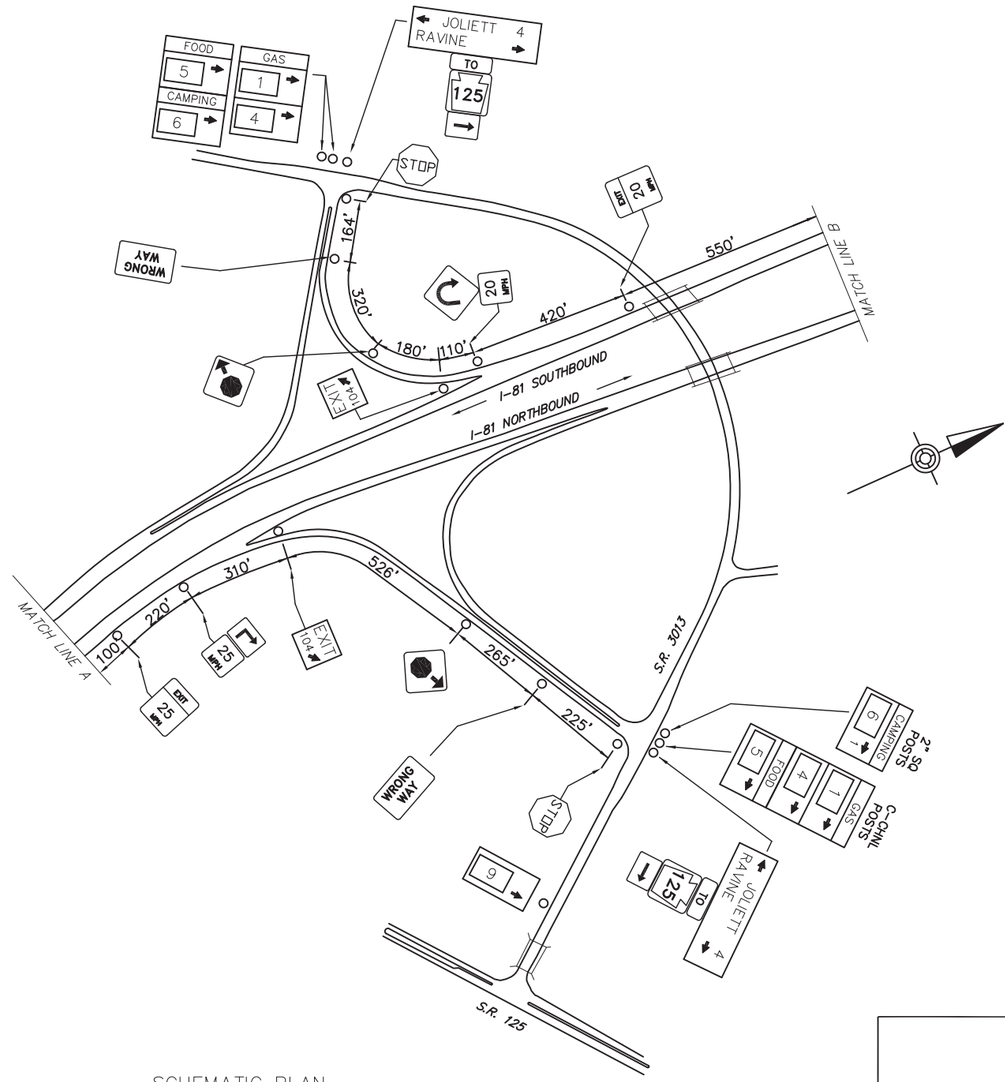

SCHEMATIC PLAN
NOT TO SCALE

LEGEND

2S – GUIDE RAIL

FREEWAY LANE CLOSURES & RESTRICTIONS ONLY PERMITTED BETWEEN 9:00 PM AND 6:00 AM MONDAY THRU FRIDAY. WORK ALONG FREEWAY PERMITTED BETWEEN 9:00 AM AND 2:30 PM, UNLESS OTHERWISE APPROVED BY ENGINEERING DISTRICT. DO NOT WORK DURING HOLIDAY PERIODS. IF APPLICABLE, REINSTALL GUIDERAIL AT END OF EACH DAY.

EXIT 104 SPECIFIC INFORMATION PANEL			
LEGEND	DIRECTION	BUSINESS	LOGO. NO.
GAS	NB/SB	EXXON (24 HR/DIESEL)	1
		RACEWAY TRAVEL PLAZA	4
FOOD	NB/SB	BURGER KING	5
CAMPING	NB/SB	ECHO VALLEY CAMPGROUND (OPEN ALL YEAR)	6

NB SIGNS

12'Hx13'W
FUTURE 14'H
W8x21
AVERY TYPE IV
B525 – #2, #1

GAS – EXIT 104: 1 4
FOOD – EXIT 104: 5

6'Hx13'W
FUTURE 16'H
W10x26
TYPE IX LEGEND
TYPE III BACKGROUND
B650 – #1, #1

CAMPING – EXIT 104: 6

SB SIGNS

GAS – EXIT 104: 1 4
FOOD – EXIT 104: 5

12'Hx13'W
W8x21
3M TYPE III
B525 – #1, #1

CAMPING – EXIT 104: 6

6'Hx13'W
FUTURE 10'H
W8x21
B525 – #1, #1

INTERSTATE 81
RAVINE
EXIT 104

D:\2015_ECMS\215976-1\VIA\PSE_AS-BUILT DRAWINGS\PENNDOT DISTRICT 05\SCHUYLKILL - 53\10-XX_SHTXX IRL_EXIT 104 PLAN
October/3/2019 2:37 PM