DISTRICT	COUNTY	ROUTE	PROJECT	SHEET
8-0	FRANKLIN	I-81		
GUILFORD TWP. & CHAMBERSBURG BORO				
REVISIONS				

TABULATION OF QUANTITIES		
ITEM	UNIT	QUANTITY
POST MOUNTED SIGNS, TYPE A, LOGO	SQ.FT.	
POST MOUNTED SIGNS, TYPE A, LOGO (MODIFIED)	SQ.FT.	
POST MOUNTED SIGNS, TYPE C, LOGO	SQ.FT.	
BREAKAWAY SYSTEMS	EACH	
* STEEL S OR W BEAM POSTS	LBS.	
LOGO SIGN MOUNTING	EACH	
LOGO SIGN MOUNTING, RESET	EACH	
REMOVAL OF POST MOUNTED MOTORIST SERVICE SIGNS, TYPES A & E	EACH	–
REMOVAL OF POST MOUNTED MOTORIST SERVICE SIGNS, TYPES B, C & F	L.S.	

* APPROXIMATE QUANTITY FOR INFORMATION ONLY

SYMBOLS

- ○ *Existing Sign to Remain*
- △ *Existing Sign to be Removed*
- □ *Existing Sign Reset as Shown*
- ● NEW SIGN
- × FUTURE SIGN
- Ø *Existing Utility Pole*

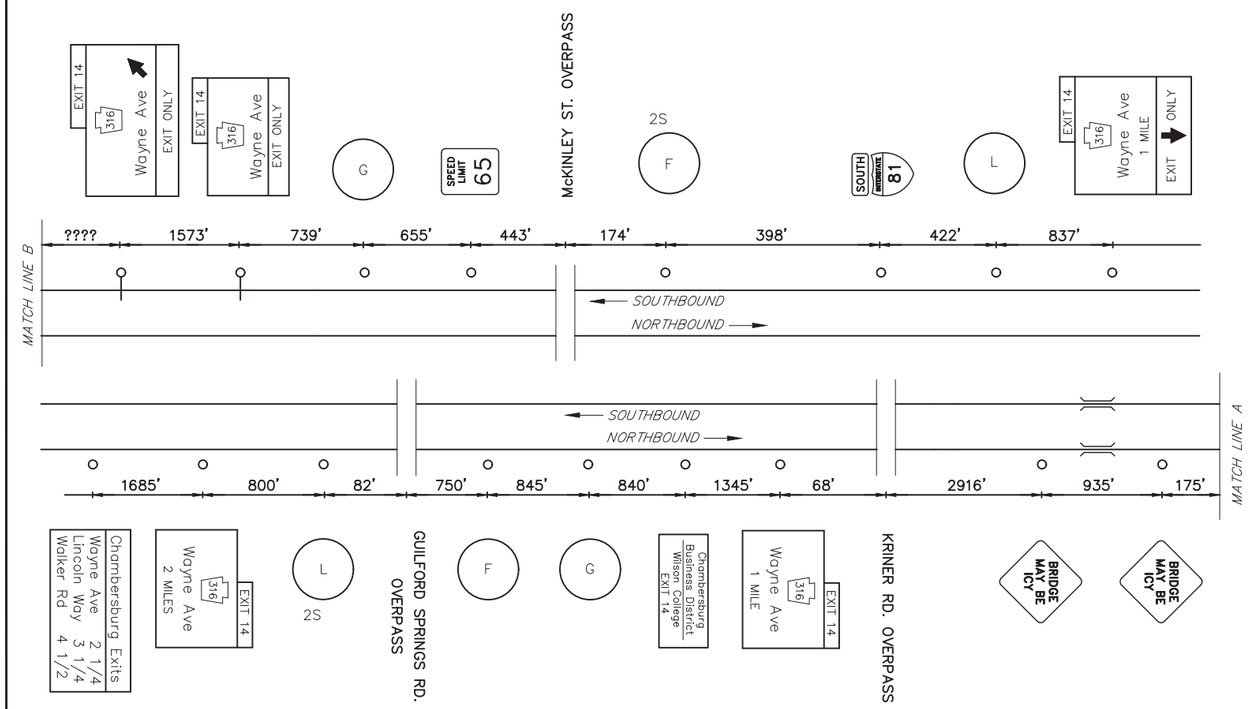

MAINLINE SCHEMATIC
NOT TO SCALE

LEGEND

2S – GUIDE RAIL.

FREEWAY LANE CLOSURES & RESTRICTIONS ONLY PERMITTED BETWEEN 9:00 PM AND 6:00 AM MONDAY THRU FRIDAY. WORK ALONG FREEWAY PERMITTED BETWEEN 9:00 AM AND 2:30 PM, UNLESS OTHERWISE APPROVED BY ENGINEERING DISTRICT. DO NOT WORK DURING HOLIDAY PERIODS. IF APPLICABLE, REINSTALL GUIDERAIL AT END OF EACH DAY.

EXIT 14 SPECIFIC INFORMATION PANEL			
LEGEND	DIRECTION	BUSINESS	LOGO. NO.
GAS	NB/SB		
		SHEETZ (DIESEL)	7
		SUNOCO	6
FOOD	NB/SB	DENNY'S (24 HOURS)	2
		WENDY'S	3
		BOB EVANS RESTAURANT	8
		CRACKER BARREL	10
		APPLEBEE'S	11
		ARBY'S	13
LODGING	NB/SB	MOTEL 6	4
		RED ROOF INN	5
		HAMPTON INN	9
		HOLIDAY INN EXPRESS & SUITES	14
		RED CARPET INN	15
		BAYMONT INN & SUITES	12

	NB SIGNS	SB SIGNS	
6'Hx19'W FUTURE 12'H W14x30 A572 AVERY TYPE IV B650 – #4, #4	GAS – EXIT 14: 7 6	GAS – EXIT 14: 6 7	6'Hx19'W FUTURE 12'H W10x26 A572 AVERY TYPE IV B650 – #4, #4
10'Hx19'W W8x21 A572 AVERY TYPE IV B525 – #1, #2	FOOD – EXIT 14: 8 10 13 / 2 11 3	FOOD – EXIT 14: 2 3 8 / 10 11 13	10'Hx19'W W8x21 3M TYPE III B525 – #1, #1
10'Hx19'W FUTURE 12'H W12x26 A572 AVERY TYPE IV B650 – #2, #2	LODGING – EXIT 14: 9 15 14 / 4 5	LODGING – EXIT 14: 14 4 9 / 15 5	10'Hx19'W W10x26 AVERY TYPE IV B650 – #2, #2

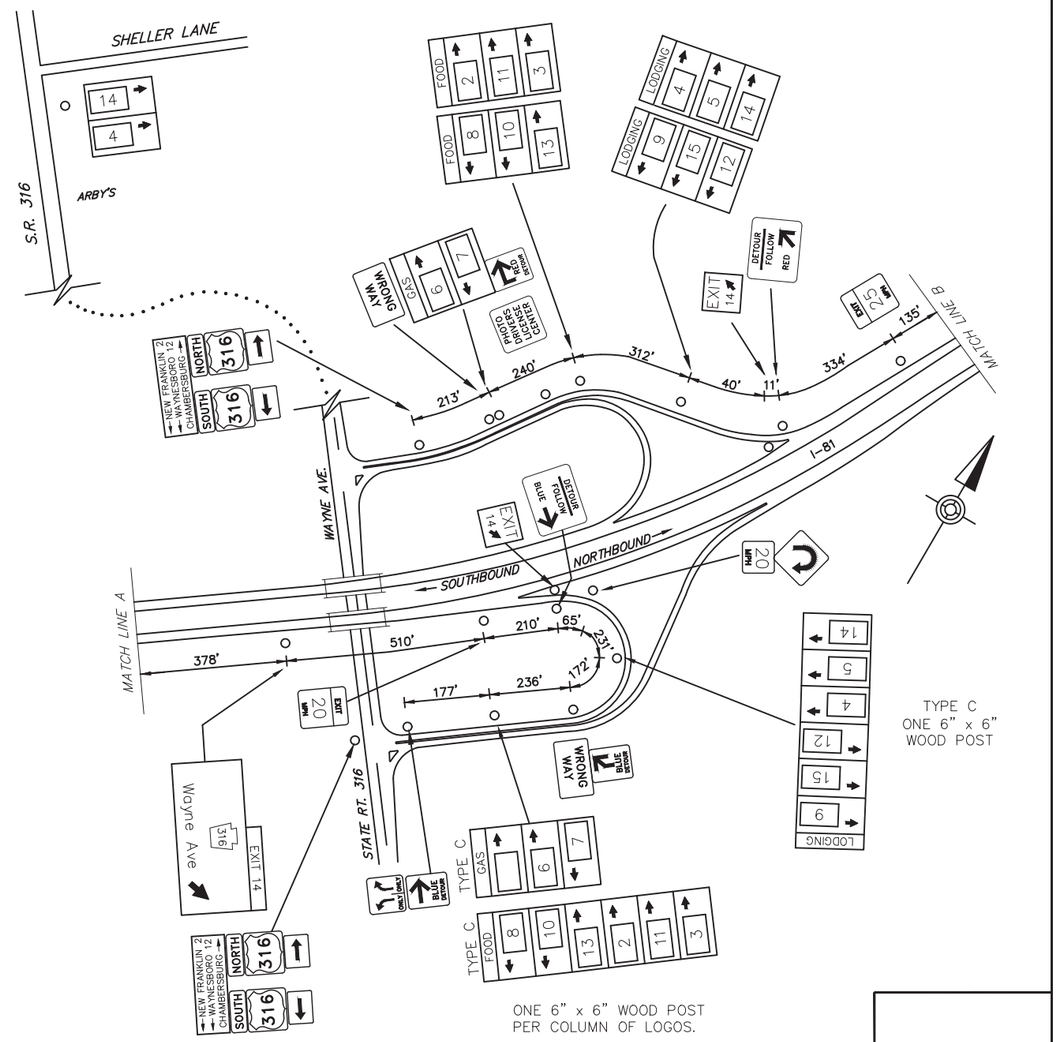

ONE 6" x 6" WOOD POST
PER COLUMN OF LOGOS.

SCHEMATIC PLAN
NOT TO SCALE

INTERSTATE 81

WAYNE AVENUE
EXIT 14

D:\2015_CDBS\215976-01\WK\PSE\AS-BUILT DRAWINGS\PENNDOT DISTRICT 08\FRANKLIN - 28\10-XX SHTXX-I81_EXIT 14 PLAN
September/24/2019 3:28 PM