DISTRICT	COUNTY	ROUTE	PROJECT	SHEET
8-0	CUMBERLAND	I-81		
SOUTHAMPTON & SHIPPENSBURG TOWNSHIPS				
REVISIONS				

TABULATION OF QUANTITIES		
ITEM	UNIT	QUANTITY
POST MOUNTED SIGNS, TYPE A, LOGO	SQ.FT.	–
POST MOUNTED SIGNS, TYPE A, LOGO (MODIFIED)	SQ.FT.	
POST MOUNTED SIGNS, TYPE C, LOGO	SQ.FT.	
BREAKAWAY SYSTEMS	EACH	–
* STEEL S OR W BEAM POSTS	LBS.	–
LOGO SIGN MOUNTING	EACH	
LOGO SIGN MOUNTING, RESET	EACH	
REMOVAL OF POST MOUNTED MOTORIST SERVICE SIGNS, TYPES A & E	EACH	–
REMOVAL OF POST MOUNTED MOTORIST SERVICE SIGNS, TYPES B, C & F	L.S.	

* APPROXIMATE QUANTITY FOR INFORMATION ONLY

SYMBOLS

- ○ *Existing Sign to Remain*
- △ *Existing Sign to be Removed*
- □ *Existing Sign Reset as Shown*
- ● NEW SIGN
- × FUTURE SIGN
- Ø *Existing Utility Pole*

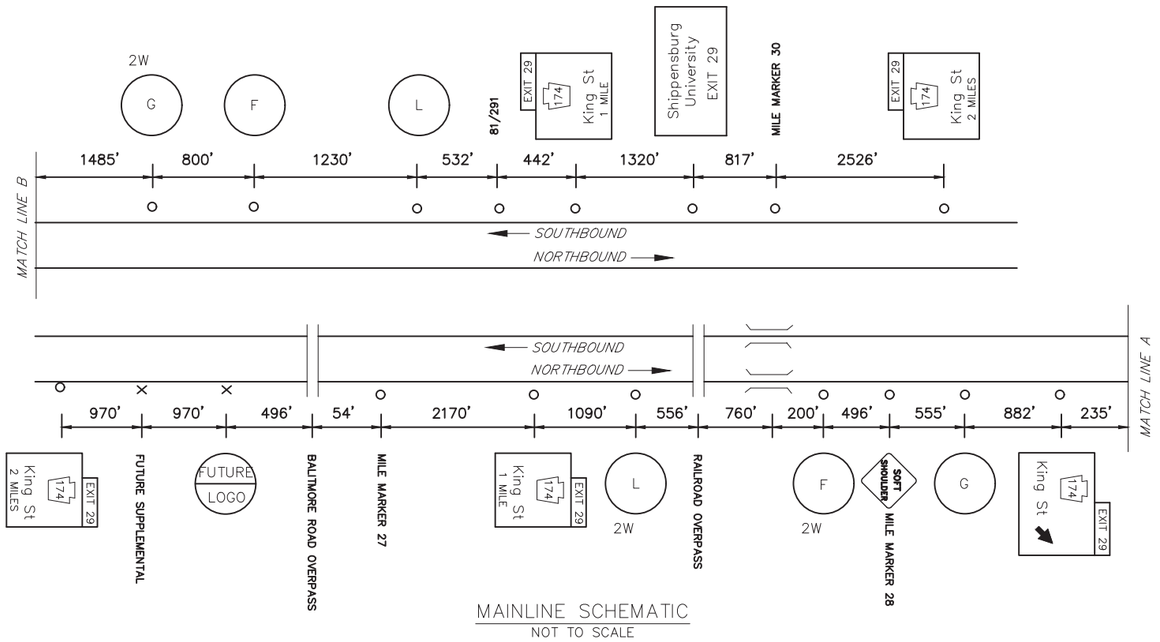

MAINLINE SCHEMATIC
NOT TO SCALE

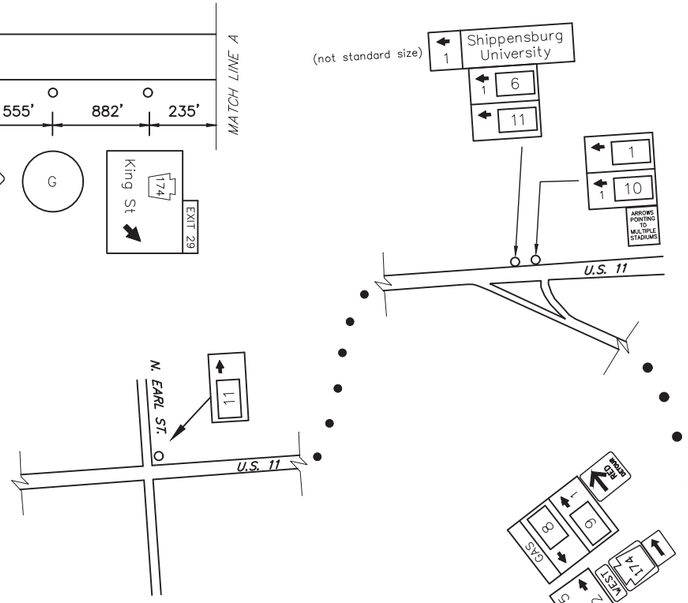

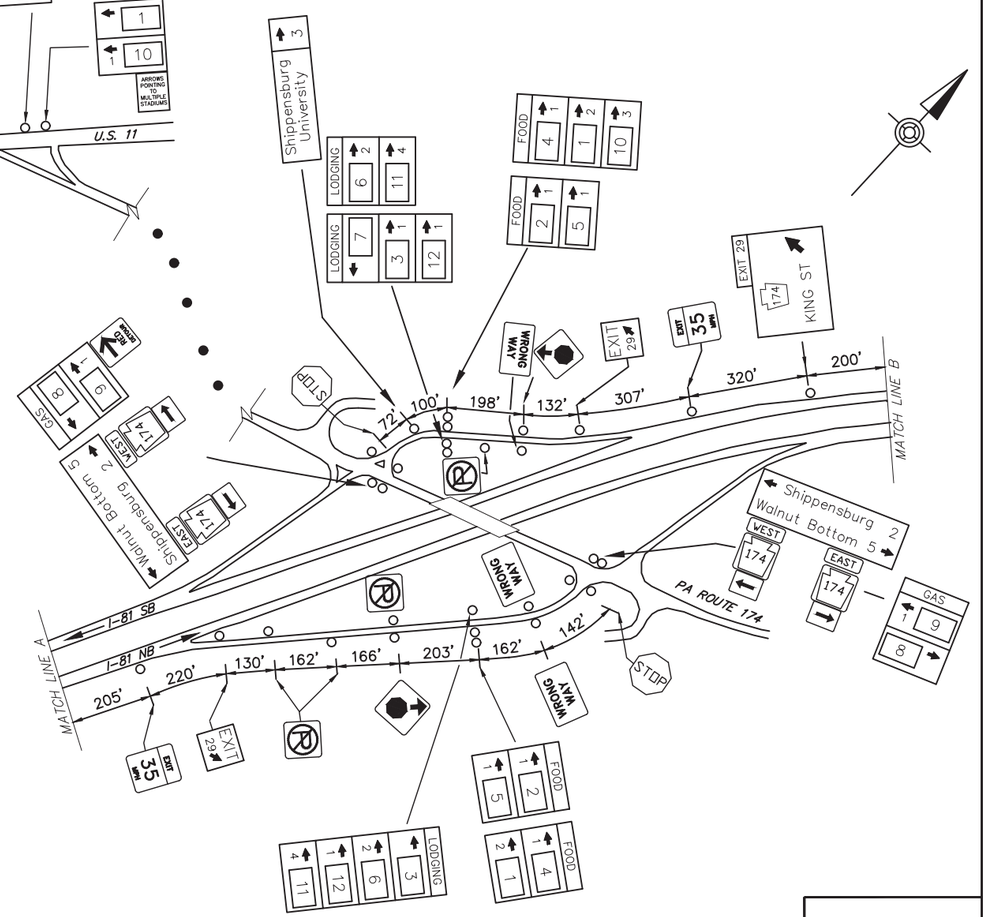

SCHEMATIC PLAN
NOT TO SCALE

LEGEND

2W – GUIDE RAIL.

DO NOT CLOSE OR RESTRICT TRAVEL LANES DURING RUSH HOUR. WORK ALONG FREEWAY PERMITTED BETWEEN 9:00 AM AND 2:30 PM, UNLESS OTHERWISE APPROVED BY ENGINEERING DISTRICT. DO NOT WORK DURING HOLIDAY. PERIODS IF APPICABLE, REINSTALL GUIDERAIL AT END OF EACH DAY.

EXIT 29 ** SPECIFIC INFORMATION PANEL			
LEGEND	DIRECTION	BUSINESS	LOGO. NO.
FOOD	NB/SB	McDONALDS	1
		BURGER KING	4
		SUBWAY	2
		WENDY'S	5
		AROOGA'S	10
LODGING	NB/SB	BEST WESTERN	3
		QUALITY INN	6
		COURTYARD BY MARRIOTT	11
		HOLIDAY INN EXPRESS	12
	SB	RODEWAY INN	7
GAS	NB/SB	SUNOCO (DIESEL/24 HRS)	8
		RUTTER'S (24 HOURS/DIESEL)	9

** ONE MILE EXTENSION ALLOWANCE APPLIES AT THIS INTERCHANGE

NB SIGNS		SB SIGNS	
6'Hx13'W FUTURE 16'H W14x30 A572 AVERY TYPE IV B650 – #3, #3	GAS – EXIT 29: 8 9	GAS – EXIT 29: 8 9	6'Hx13'W FUTURE 14'H W14x30 A572 3M TYPE III B650 – #2, #2
10'Hx13'W FUTURE 12'H W10x26 A572 TYPE III B650 – #1, #1	FOOD – EXIT 29: 4 1 / 2 5	FOOD – EXIT 29: 5 2 / 4 1 / 10	14'Hx13'W W8x21 A572 AVERY TYPE IV B525 – #2, #2
10'Hx13'W W6x12 AVERY TYPE IV B525 – #1, #1	LODGING – EXIT 29: 3 12 / 6 11	LODGING – EXIT 29: 7 3 12 / 6 11	10'Hx19'W FUTURE 12'H W12x26 AVERY TYPE IV B650 – #2, #2

INTERSTATE 81
KING STREET
EXIT 29

D:\2015_ID\51-215076-01\MVP\PSE\AS-BUILT DRAWINGS\PENNDOT DISTRICT 08\CUMBERLAND - 21x10-XX SHTX I81_EXIT 29 PLAN
September/24/2019 3:28 PM