DISTRICT	COUNTY	ROUTE	PROJECT	SHEET
8-0	CUMBERLAND	I-81		
SOUTH MIDDLE TOWNSHIP				
REVISIONS				

SB NOT ELIGIBLE – INSUFFICIENT SPACE

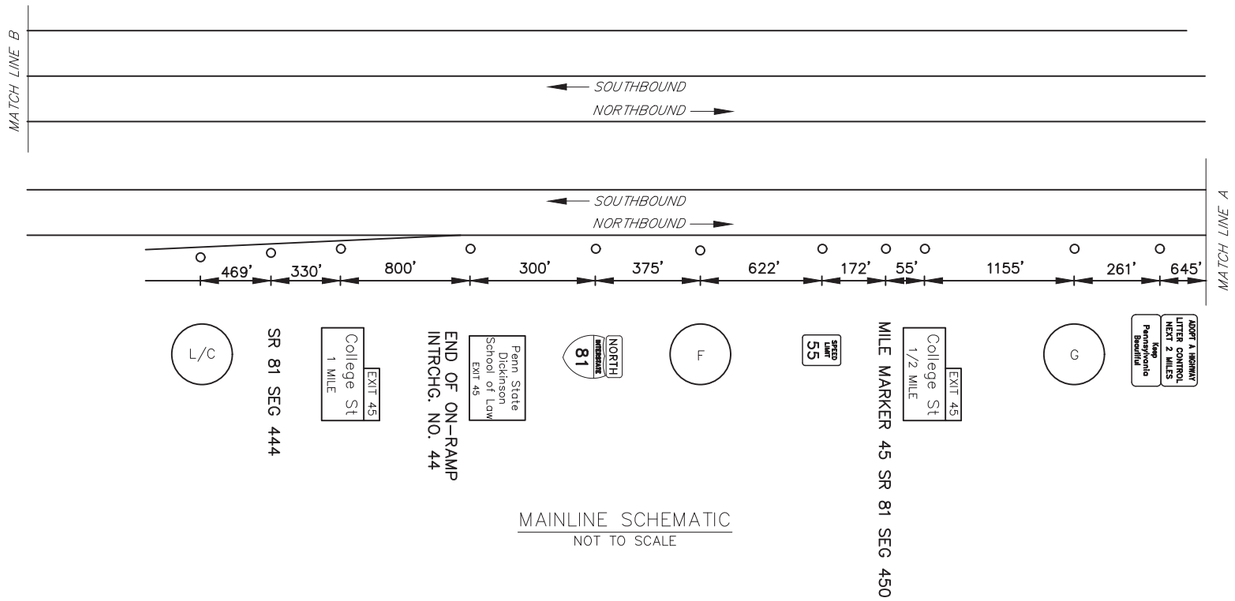

MAINLINE SCHEMATIC
NOT TO SCALE

TABULATION OF QUANTITIES		
ITEM	UNIT	QUANTITY
POST MOUNTED SIGNS, TYPE A, LOGO	SQ.FT.	
POST MOUNTED SIGNS, TYPE A, LOGO (MODIFIED)	SQ.FT.	
POST MOUNTED SIGNS, TYPE C, LOGO	SQ.FT.	
BREAKAWAY SYSTEMS	EACH	
* STEEL S OR W BEAM POSTS	LBS.	
LOGO SIGN MOUNTING	EACH	
LOGO SIGN MOUNTING, RESET	EACH	
REMOVAL OF POST MOUNTED MOTORIST SERVICE SIGNS, TYPES A & E	EACH	–
REMOVAL OF POST MOUNTED MOTORIST SERVICE SIGNS, TYPES B, C & F	L.S.	

* APPROXIMATE QUANTITY FOR INFORMATION ONLY

SYMBOLS

- ○ *Existing Sign to Remain*
- △ *Existing Sign to be Removed*
- □ *Existing Sign Reset as Shown*
- ● NEW SIGN
- × FUTURE SIGN
- Ø *Existing Utility Pole*

DO NOT CLOSE OR RESTRICT TRAVEL LANES DURING RUSH HOUR. WORK ALONG FREEWAY PERMITTED BETWEEN 9:00 AM AND 2:30 PM, UNLESS OTHERWISE APPROVED BY ENGINEERING DISTRICT. DO NOT WORK DURING HOLIDAY. PERIODS IF APPICABLE, REINSTALL GUIDERAIL AT END OF EACH DAY.

EXIT 45 SPECIFIC INFORMATION PANEL			
LEGEND	DIRECTION	BUSINESS	LOGO. NO.
FOOD	NB	McDONALD'S	1
		HOSS'S	4
		ARBY'S	6
		SUBWAY	8
		WALNUT BOTTOM DINER	10
LODGING	NB	SUPER 8	2
GAS	NB		
		GULF (DIESEL)	9
CAMPING	NB		

NB SIGNS

6'Hx19'W
FUTURE 12'H
W14x30 A572
AVERY TYPE IV
B650 – #4, #4

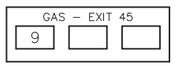

10'Hx19'W
W10x26 A572
AVERY TYPE IV
B650 – #2, #1

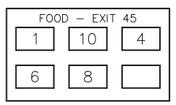

12'Hx13'W
W8x21 A572
AVERY TYPE IV
B525 – #1, #1

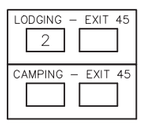

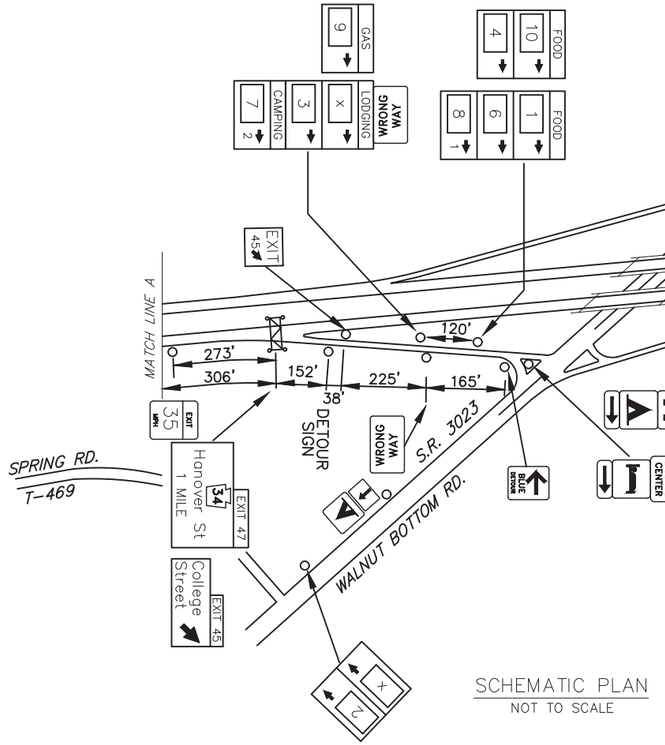

SCHEMATIC PLAN
NOT TO SCALE

INTERSTATE 81

COLLEGE ST.
EXIT 45

D:\2015\DB\32507%-01\PA\PSE\AS-BUILT DRAWINGS\PENNDOT DISTRICT 08\CUMBERLAND - 21\10-XX SHTX IBL_EXIT 45 PLAN
September/24/2019 3:28 PM