DISTRICT	COUNTY	ROUTE	PROJECT	SHEET
8-0	FRANKLIN	I-81		
BOROUGH OF GREENCASTLE & ANTRIM TOWNSHIP				
REVISIONS				

TABULATION OF QUANTITIES		
ITEM	UNIT	QUANTITY
POST MOUNTED SIGNS, TYPE A, LOGO	SQ.FT.	–
POST MOUNTED SIGNS, TYPE A, LOGO (MODIFIED)	SQ.FT.	–
POST MOUNTED SIGNS, TYPE C, LOGO	SQ.FT.	
BREAKAWAY SYSTEMS	EACH	–
* STEEL S OR W BEAM POSTS	LBS.	–
LOGO SIGN MOUNTING	EACH	–
LOGO SIGN MOUNTING, RESET	EACH	–
REMOVE POST MOUNTED SIGNS, TYPE A, LOGO (MODIFIED)	EACH	–
REMOVAL OF POST MOUNTED MOTORIST SERVICE SIGNS, TYPES B, C & F	L.S.	

* APPROXIMATE QUANTITY FOR INFORMATION ONLY

SYMBOLS

- ○ *Existing Sign to Remain*
- △ *Existing Sign to be Removed*
- □ *Existing Sign Reset as Shown*
- ◪ *Existing Sign Foundation*
- ● NEW SIGN
- × FUTURE SIGN
- Ø *Existing Utility Pole*

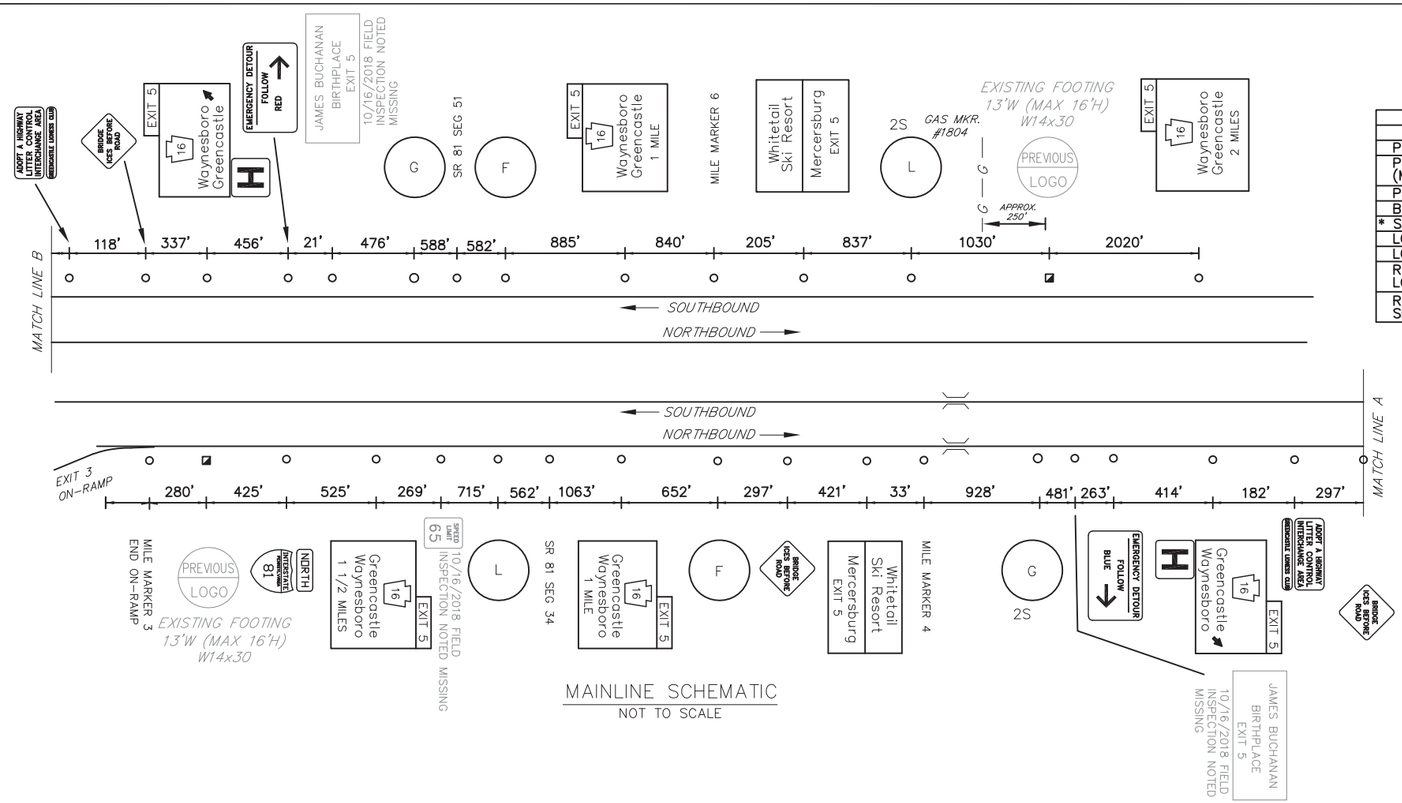

MAINLINE SCHEMATIC
NOT TO SCALE

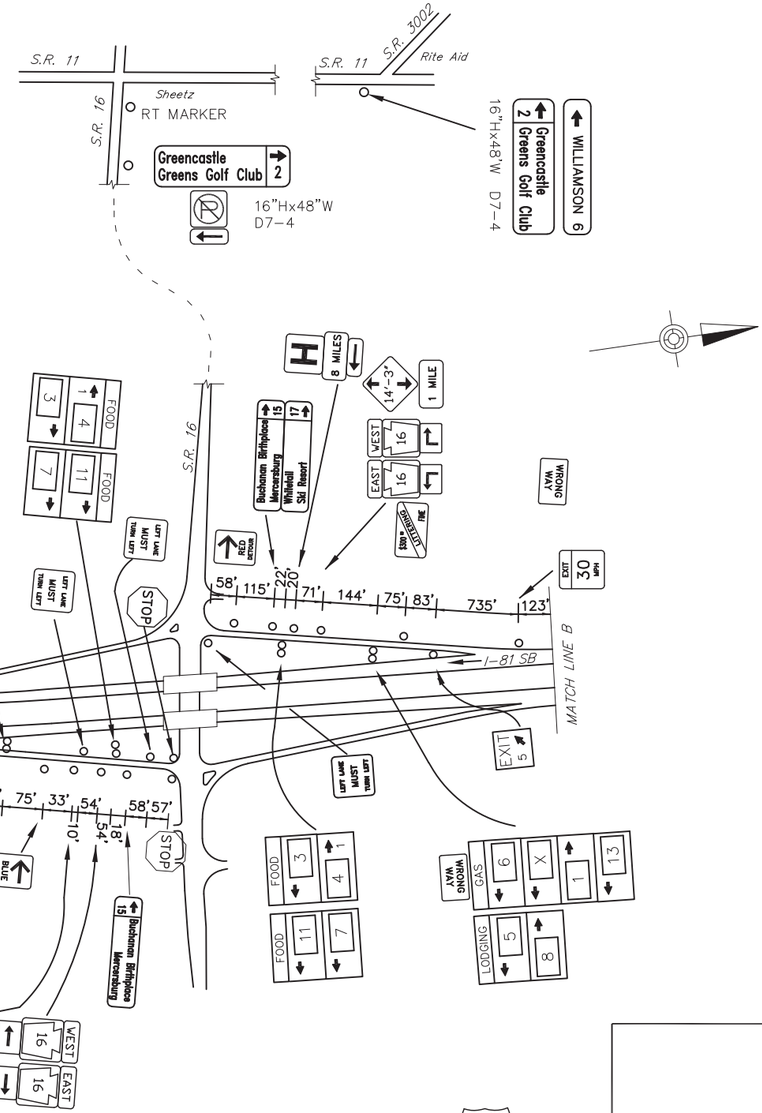

SCHEMATIC PLAN
NOT TO SCALE

LEGEND

2S – GUIDE RAIL.

DO NOT CLOSE OR RESTRICT TRAVEL LANES DURING RUSH HOUR. WORK ALONG FREEWAY PERMITTED BETWEEN 9:00 AM AND 2:30 PM, UNLESS OTHERWISE APPROVED BY ENGINEERING DISTRICT. DO NOT WORK DURING HOLIDAY. PERIODS IF APPICABLE, REINSTALL GUIDERAIL AT END OF EACH DAY.

EXIT 5 SPECIFIC INFORMATION PANEL			
LEGEND	DIRECTION	BUSINESS	LOGO. NO.
FOOD	NB/SB	McDONALD'S	3
		HARDEE'S	4
		TACO BELL	7
		COUNTRY PRIDE RESTAURANT	11
LODGING	NB/SB	SUPER 8	5
		CASTLE GREEN MOTEL	8
GAS	NB/SB	EXXON (DIESEL)	1
		SHELL (24 Hours)	6
		SHEETZ (DIESEL)	13

NB SIGNS

10'Hx13'W FUTURE 16'H W10x26 A572 AVERY TYPE IV B650 – #4, #4

GAS – EXIT 5: 6 1 / 13

10'Hx19'W W10x26 A572 AVERY TYPE IV B650 – #1, #2

FOOD – EXIT 5: 7 3 11 / 4

10'Hx13'W W6x15 A572 3M TYPE III B525 – #2, #2

LODGING – EXIT 5: 5 / 8

SB SIGNS

GAS – EXIT 5: 1 6 / 13

10'Hx13'W FUTURE 16'H W18x40 A572 AVERY TYPE IV B650 – #4, #4

FOOD – EXIT 5: 7 3 11 / 4

10'Hx19'W W10x26 A572 AVERY TYPE IV B650 – #2, #1

LODGING – EXIT 5: 8 5

10'Hx13'W W8x21 A572 AVERY TYPE IV B525 – #1, #1

INTERSTATE 81

GREENCASTLE / PA 16

EXIT 5

D:\2015\2015\215974-01\PW\PSE\AS-BUILT DRAWINGS\PENNDOT DISTRICT 08\FRANKLIN - 28\10-XX SHTXX-1B1_EXIT 5 PLAN
October/3/2019 3:28 PM