DISTRICT	COUNTY	ROUTE	PROJECT	SHEET
8-0	CUMBERLAND	I-81		
MIDDLESEX TOWNSHIP				
REVISIONS				

TABULATION OF QUANTITIES		
ITEM	UNIT	QUANTITY
POST MOUNTED SIGNS, TYPE A, LOGO	SQ.FT.	–
POST MOUNTED SIGNS, TYPE A, LOGO (MODIFIED)	SQ.FT.	–
POST MOUNTED SIGNS, TYPE C, LOGO	SQ.FT.	
BREAKAWAY SYSTEMS	EACH	–
* STEEL S OR W BEAM POSTS	LBS.	–
LOGO SIGN MOUNTING	EACH	–
LOGO SIGN MOUNTING, RESET	EACH	–
REMOVAL OF POST MOUNTED MOTORIST SERVICE SIGNS, TYPES A & E	EACH	
REMOVAL OF POST MOUNTED MOTORIST SERVICE SIGNS, TYPES B, C & F	L.S.	

* APPROXIMATE QUANTITY FOR INFORMATION ONLY

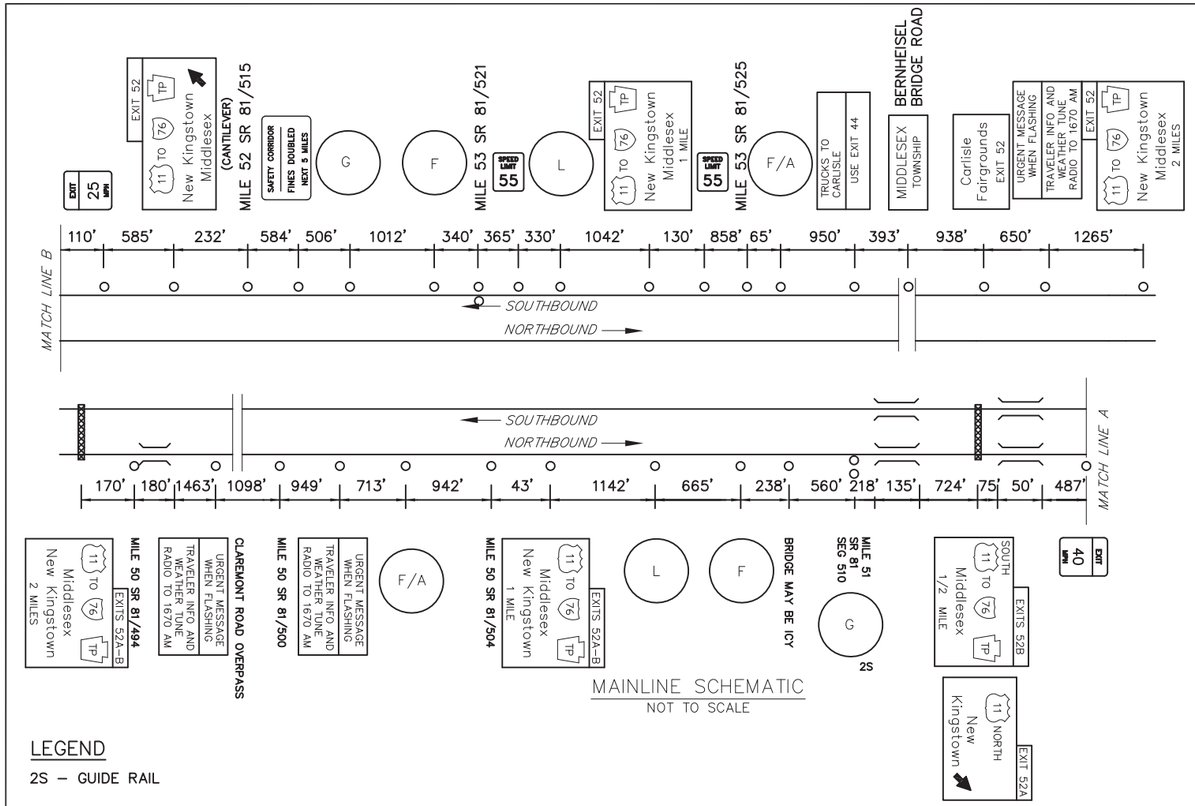

MAINLINE SCHEMATIC
NOT TO SCALE

LEGEND

2S – GUIDE RAIL

FREEWAY LANE CLOSURES & RESTRICTIONS ONLY PERMITTED BETWEEN 9:00 PM AND 6:00 AM MONDAY THRU FRIDAY. WORK ALONG FREEWAY PERMITTED BETWEEN 9:00 AM AND 2:30 PM, UNLESS OTHERWISE APPROVED BY ENGINEERING DISTRICT. DO NOT WORK DURING HOLIDAY PERIODS. IF APPLICABLE, REINSTALL GUIDERAIL AT END OF EACH DAY.

EXIT 52 SPECIFIC INFORMATION PANEL			
LEGEND	DIRECTION	BUSINESS	LOGO. NO.
ATTRACTION	NB/SB	SPORTS EMPORIUM	4
FOOD	NB/SB	DUNKIN' DONUTS	6
		MIDDLESEX DINER (24 HRS)	7
		ARBY'S	12
		SUBWAY	13
		DENNY'S (24 HOURS)	14
		WAFFLE HOUSE (24 HOURS)	22
		McDONALDS #4619	23
	NB	WENDY'S	9
LODGING	NB	COMFORT INN	11
	NB/SB		
		AMERICA'S BEST VALUE INN	16
		DAYS INN WYNDHAM	18
		ECONOLODGE	19
		SUPER 8	21
		RED ROOF	24
GAS	NB/SB	GULF (DIESEL)	1
		SUNOCO (DIESEL/24 HRS)	2
		FLYING J (DIESEL)	5
		LOVE'S TRAVEL STOPS	3
		SHEETZ (24 HRS)	25

SYMBOLS

- ○ *Existing Sign to Remain*
- △ *Existing Sign to be Removed*
- □ *Existing Sign Reset as Shown*
- ● NEW SIGN
- × FUTURE SIGN
- Ø *Existing Utility Pole*

MISSING ON 12/28/16 FIELD VISIT

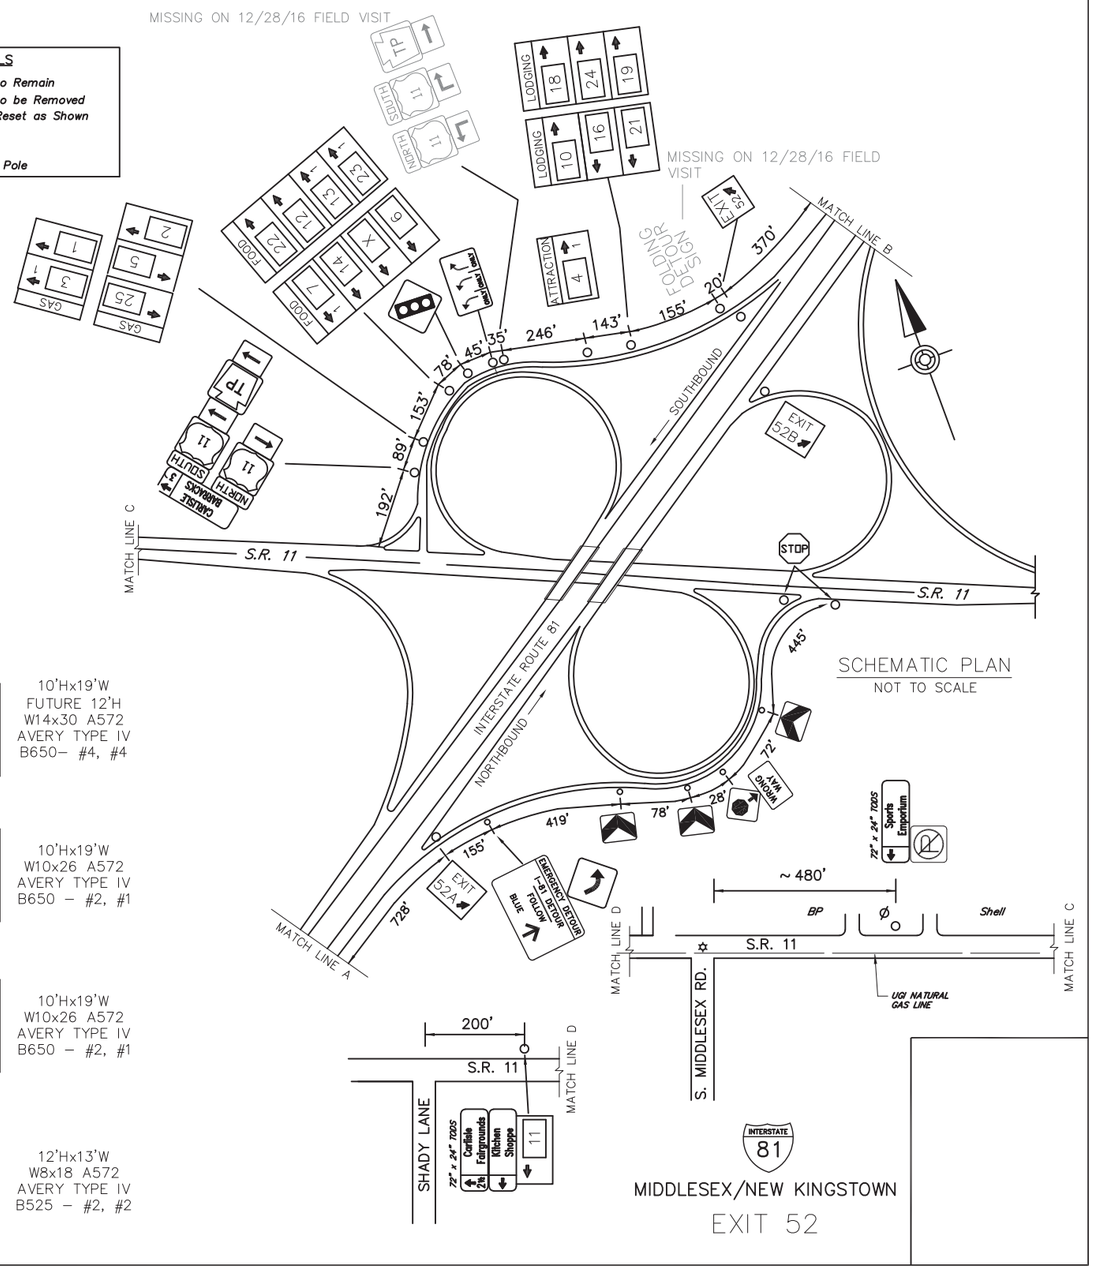

SCHEMATIC PLAN
NOT TO SCALE

NB SIGNS

SB SIGNS

16'Hx13'W W14x30 A572 STIM. TYPE IV B650 – #1, #1

GAS – EXIT 52A: 25 5
GAS – EXIT 52B: 2 1 / 3

GAS – EXIT 52: 2 1 5 / 25 3

10'Hx19'W FUTURE 12'H W14x30 A572 AVERY TYPE IV B650– #4, #4

12'Hx19'W FUTURE 16'H W14x30 AVERY TYPE IV B650 – #2, #2

FOOD – EXIT 52A: 6 14
FOOD – EXIT 52B: 13 22 23

FOOD – EXIT 52: 13 22 6 / 14 12 7

10'Hx19'W W10x26 A572 AVERY TYPE IV B650 – #2, #1

16'Hx13'W W10x26 AVERY TYPE IV B650 – #1, #1

LODGING – EXIT 52A: 16 24
LODGING – EXIT 52B: 18 19 / 11

LODGING – EXIT 52: 18 19 16 / 24 21

10'Hx19'W W10x26 A572 AVERY TYPE IV B650 – #2, #1

12'Hx13'W W8x21 AVERY TYPE IV B525 – #1, #1

FOOD–EXIT 52B: 9
ATTRACTION–EXIT 52B: 4

FOOD–EXIT 52: 23
ATTRACTION–EXIT 52: 4

12'Hx13'W W8x18 A572 AVERY TYPE IV B525 – #2, #2

D:\2015_ADES\215076-01\WVPSE\AS-BUILT DRAWINGS\PENNDOT DISTRICT 08\CUMBERLAND - 21\10-XX SHTXX 181_EXIT 52 PLAN
October/3/2019 12:01 PM