DISTRICT	COUNTY	ROUTE	PROJECT	SHEET
8-0	DAUPHIN	I-81		
EAST & WEST HANOVER TOWNSHIPS				
REVISIONS				

TABULATION OF QUANTITIES		
ITEM	UNIT	QUANTITY
POST MOUNTED SIGNS, TYPE A, LOGO	SQ.FT.	
POST MOUNTED SIGNS, TYPE A, LOGO (MODIFIED)	SQ.FT.	
POST MOUNTED SIGNS, TYPE C, LOGO	SQ.FT.	
BREAKAWAY SYSTEMS	EACH	
* STEEL S OR W BEAM POSTS	LBS.	
LOGO SIGN MOUNTING	EACH	
LOGO SIGN MOUNTING, RESET	EACH	
REMOVAL OF POST MOUNTED MOTORIST SERVICE SIGNS, TYPES A & E	EACH	–
REMOVAL OF POST MOUNTED MOTORIST SERVICE SIGNS, TYPES B, C & F	L.S.	

* APPROXIMATE QUANTITY FOR INFORMATION ONLY

SYMBOLS

- ○ *Existing Sign to Remain*
- △ *Existing Sign to be Removed*
- □ *Existing Sign Reset as Shown*
- ● NEW SIGN
- × FUTURE SIGN
- Ø *Existing Utility Pole*

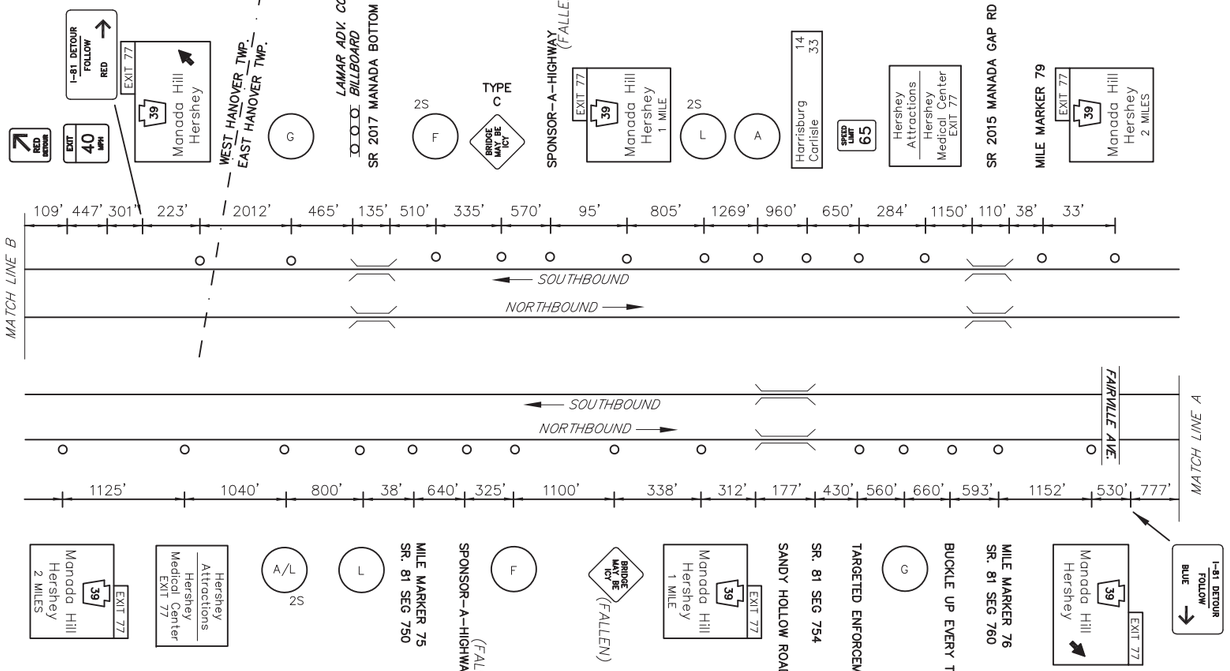

MAINLINE SCHEMATIC
NOT TO SCALE

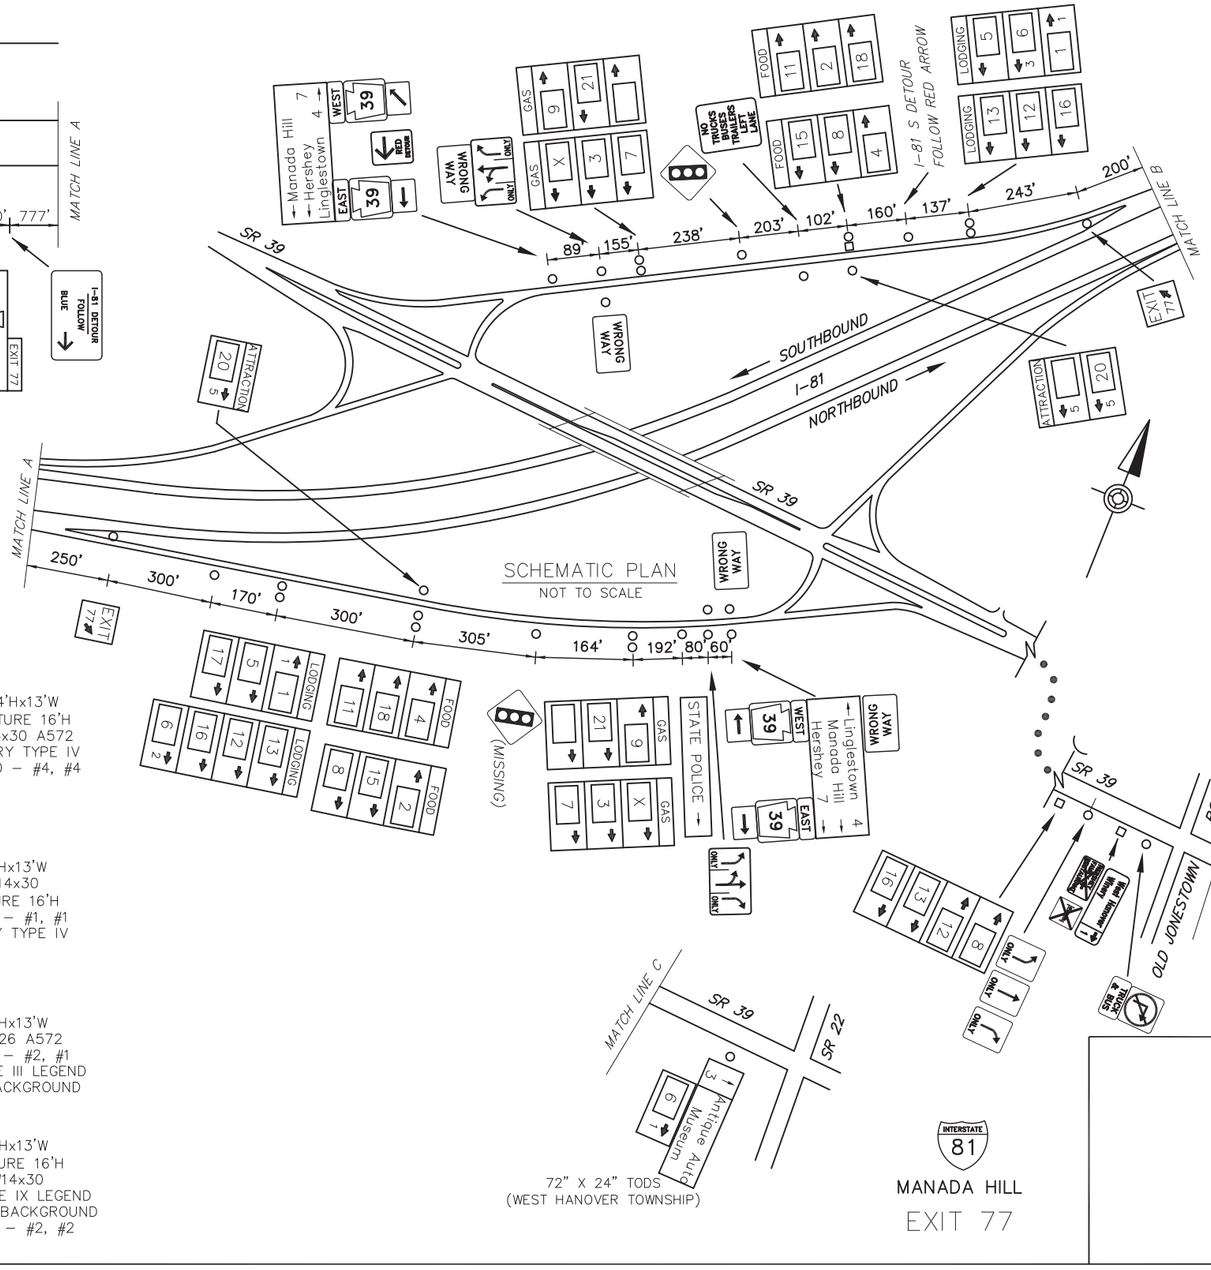

SCHEMATIC PLAN
NOT TO SCALE

LEGEND

2S – GUIDE RAIL

FREEWAY LANE CLOSURES & RESTRICTIONS ONLY PERMITTED BETWEEN 9:00 PM AND 6:00 AM MONDAY THRU FRIDAY.
WORK ALONG FREEWAY PERMITTED BETWEEN 9:00 AM AND 2:30 PM, UNLESS OTHERWISE APPROVED BY ENGINEERING DISTRICT.
DO NOT WORK DURING HOLIDAY PERIODS.
IF APPLICABLE, REINSTALL GUIDERAIL AT END OF EACH DAY.

EXIT 77 SPECIFIC INFORMATION PANEL			
LEGEND	DIRECTION	BUSINESS	LOGO. NO.
GAS	NB/SB	SHEETZ (DIESEL/24 HRS)	21
		PILOT (OPEN 24 HRS)	7
		FLYING J (24 HRS)	9
FOOD	NB/SB	McDONALD'S	18
		COUNTRY PRIDE RESTAURANT	4
		DUNKIN' DONUTS	2
		HERSHEY ROAD FAMILY RESTAURANT	8
		PERKIN'S FAMILY RESTAURANT	11
LODGING	NB/SB	LA QUINTA INNS & SUITES	5
		HOLIDAY INN EXPRESS	1
		COUNTRY INN & SUITES	12
		MOTEL 6	13
		SUPER 8	16
	NB	ECONOLODGE	17
	SB	BEST WESTERN	6
ATTRACTION	NB/SB		
		ANTIQUE AUTO MUSEUM AT HERSHEY	20

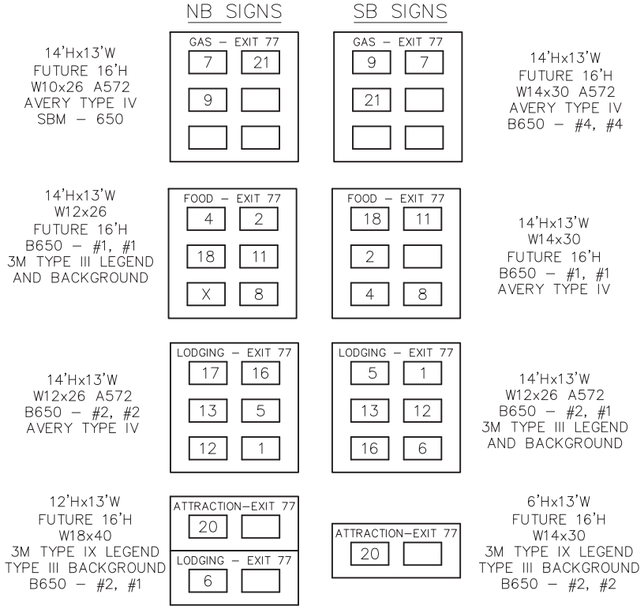

D:\2015_GEO\215976-01\VA\PSE\AS-BUILT DRAWINGS\PENNDOT DISTRICT 8\DAUPHIN - 22\SHTXX-I81_EXIT 77 PLAN
October/3/2019 2:14 PM