DISTRICT	COUNTY	ROUTE	PROJECT	SHEET
5-0	BERKS	US-222		
BERN AND MUHLENBERG TOWNSHIPS				
REVISIONS				

TABULATION OF QUANTITIES		
ITEM	UNIT	QUANTITY
POST MOUNTED SIGNS, TYPE A, LOGO	SQ.FT.	
POST MOUNTED SIGNS, TYPE B, LOGO	SQ.FT.	
POST MOUNTED SIGNS, TYPE C, LOGO	SQ.FT.	
BREAKAWAY SYSTEMS	EACH	
* STEEL S OR W BEAM POSTS	LBS.	
LOGO SIGN MOUNTING	EACH	
REMOVAL OF POST MOUNTED MOTORIST SERVICE SIGNS, TYPES A & E	EACH	–
REMOVAL OF POST MOUNTED MOTORIST SERVICE SIGNS, TYPES B, C & F	L.S.	

* APPROXIMATE QUANTITY FOR INFORMATION ONLY

SYMBOLS

- ○ *Existing Sign to Remain*
- △ *Existing Sign to be Removed*
- □ *Existing Sign Reset as Shown*
- ● NEW SIGN
- × FUTURE SIGN
- Ø *Existing Utility Pole*

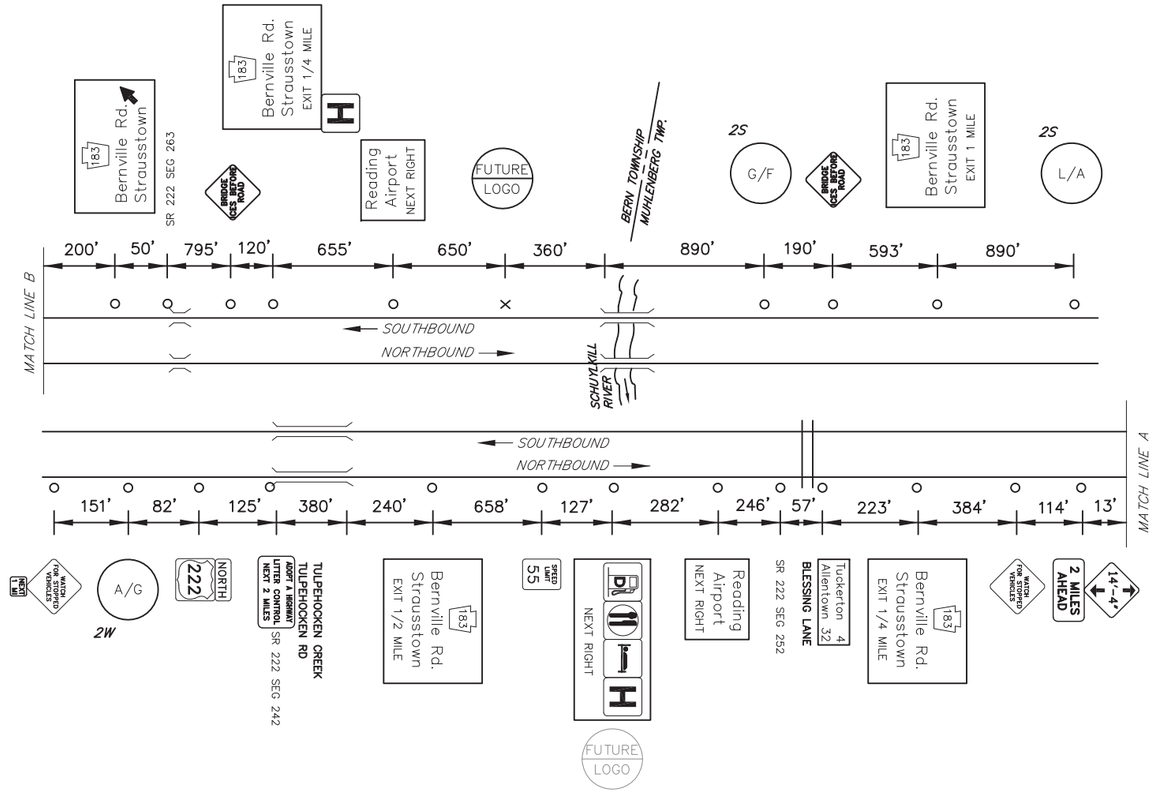

MAINLINE SCHEMATIC
NOT TO SCALE

DO NOT CLOSE OR RESTRICT TRAVEL LANES
BETWEEN 6:00 AM AND 9:00 AM, AND
BETWEEN 3:00 PM AND 6:00 PM, MONDAY THRU FRIDAY.
DO NOT WORK DURING HOLIDAY PERIODS.

BERNVILLE EXIT SPECIFIC INFORMATION PANEL			
LEGEND	DIRECTION	BUSINESS	LOGO NO.
LODGING	SB	QUALITY INN	1
		HOLIDAY INN EXPRESS	3
GAS	NB/SB	WAWA (DIESEL/24 HOURS)	7
ATTRACTION	NB/SB	MID-ATLANTIC AIR MUSEUM	4
		BERKS COUNTY HERITAGE CENTER	5
FOOD	SB	SUBWAY	6

NB SIGNS

12'Hx19'W
FUTURE 16'H
W18x40 A572
TYPE IX LEGEND
TYPE III
BACKGROUND
B650 – #2, #2

ATTRACTION–NEXT RIGHT: 5 4
GAS–NEXT RIGHT: 7

SB SIGNS

LODGING–NEXT RIGHT: 1 3
ATTRACTION NEXT RIGHT: 4 5

13.5'Hx13'W
FUTURE 14'H
W14x30 A572
3M TYPE III
B650 – #2, #2

GAS – NEXT RIGHT: X 7
FOOD – NEXT RIGHT: 6

12'Hx13'W
FUTURE 16'H
W14x30 A572
3M TYPE III
B650 – #2, #2

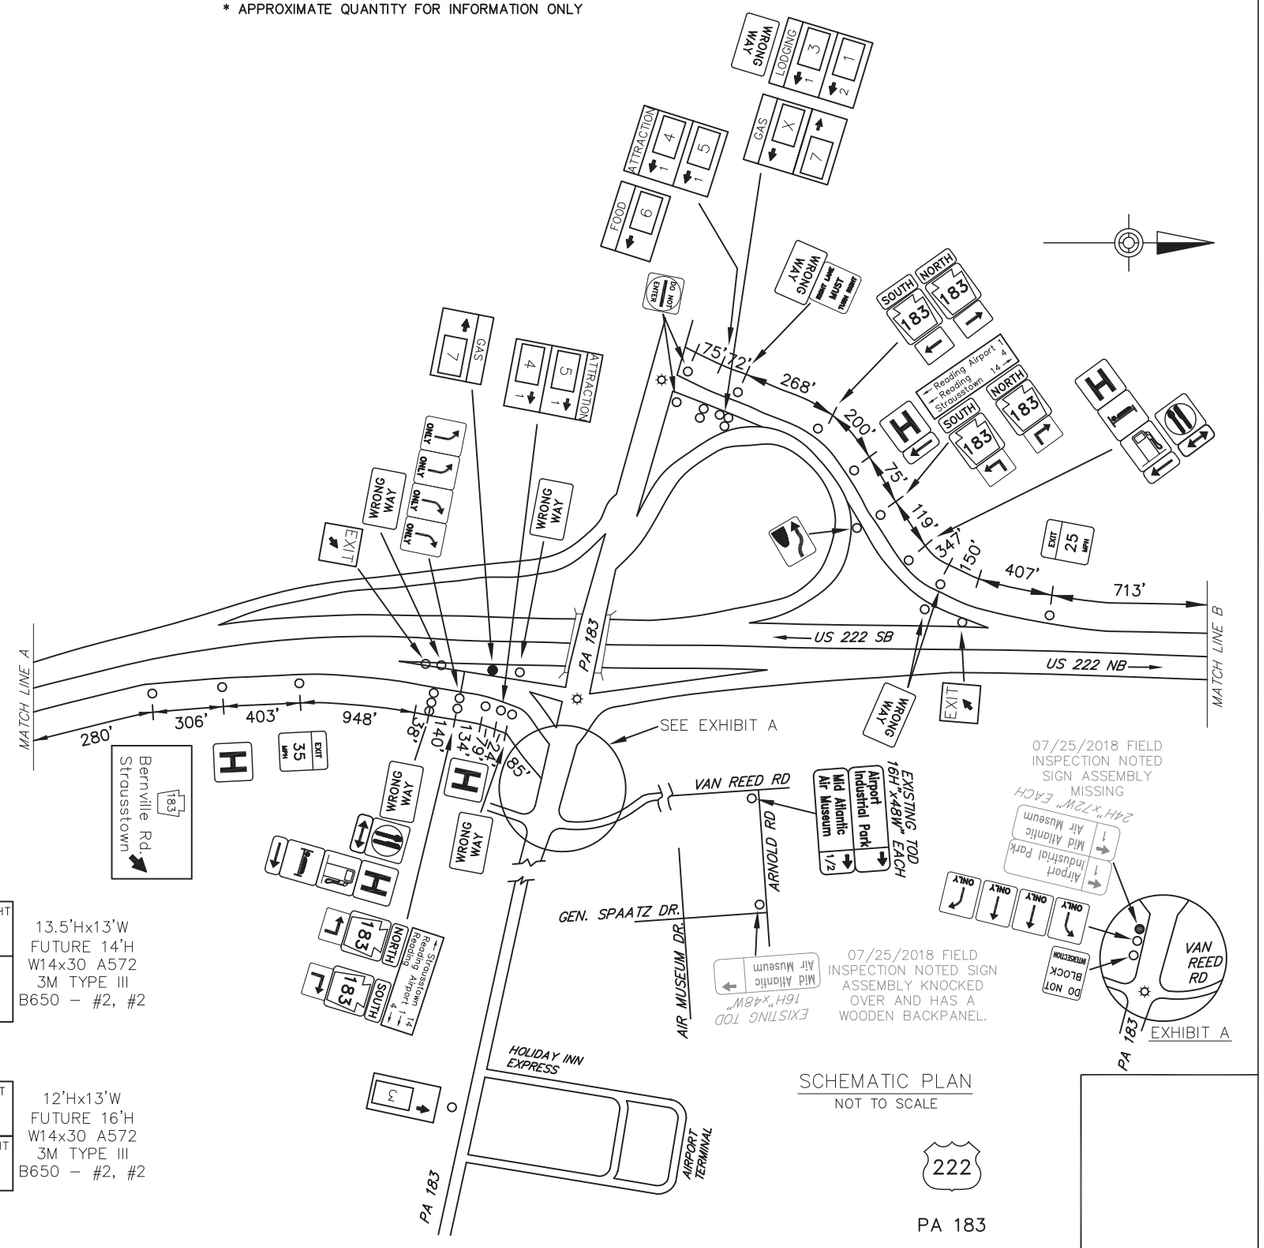

SCHEMATIC PLAN
NOT TO SCALE

222
PA 183
BERNVILLE

\\BRG-NAS01\DATA\PROJECTS\2015\D05\215076-01\HV\PSE\AS-BUILT DRAWINGS\PENNDOT DISTRICT 05\BERKS - 06\10-XX SHTXX-222_ EXIT BERNVILLE PLAN
May/29/2020 11:01 AM