DISTRICT	COUNTY	ROUTE	PROJECT	SHEET
5-0	CARBON	I-80		
KIDDER TOWNSHIP AND BORO OF EASTSIDE				
REVISIONS				

TABULATION OF QUANTITIES		
ITEM	UNIT	QUANTITY
POST MOUNTED SIGNS, TYPE A, LOGO	SQ.FT.	
POST MOUNTED SIGNS, TYPE B, LOGO	SQ.FT.	
POST MOUNTED SIGNS, TYPE C, LOGO	SQ.FT.	
BREAKAWAY SYSTEMS	EACH	
* STEEL S OR W BEAM POSTS	LBS.	
LOGO SIGN MOUNTING	EACH	
FLAT SHEET PANEL REPLACEMENT	SQ.FT.	
EXTRUDED PANEL REPLACEMENT	SQ.FT.	
REMOVAL OF POST MOUNTED MOTORIST SERVICE SIGNS, TYPES B, C & F	L.S.	

* APPROXIMATE QUANTITY FOR INFORMATION ONLY

SYMBOLS

- ○ *Existing Sign to Remain*
- △ *Existing Sign to be Removed*
- □ *Existing Sign Reset as Shown*
- ● NEW SIGN
- × FUTURE SIGN
- Ø *Existing Utility Pole*

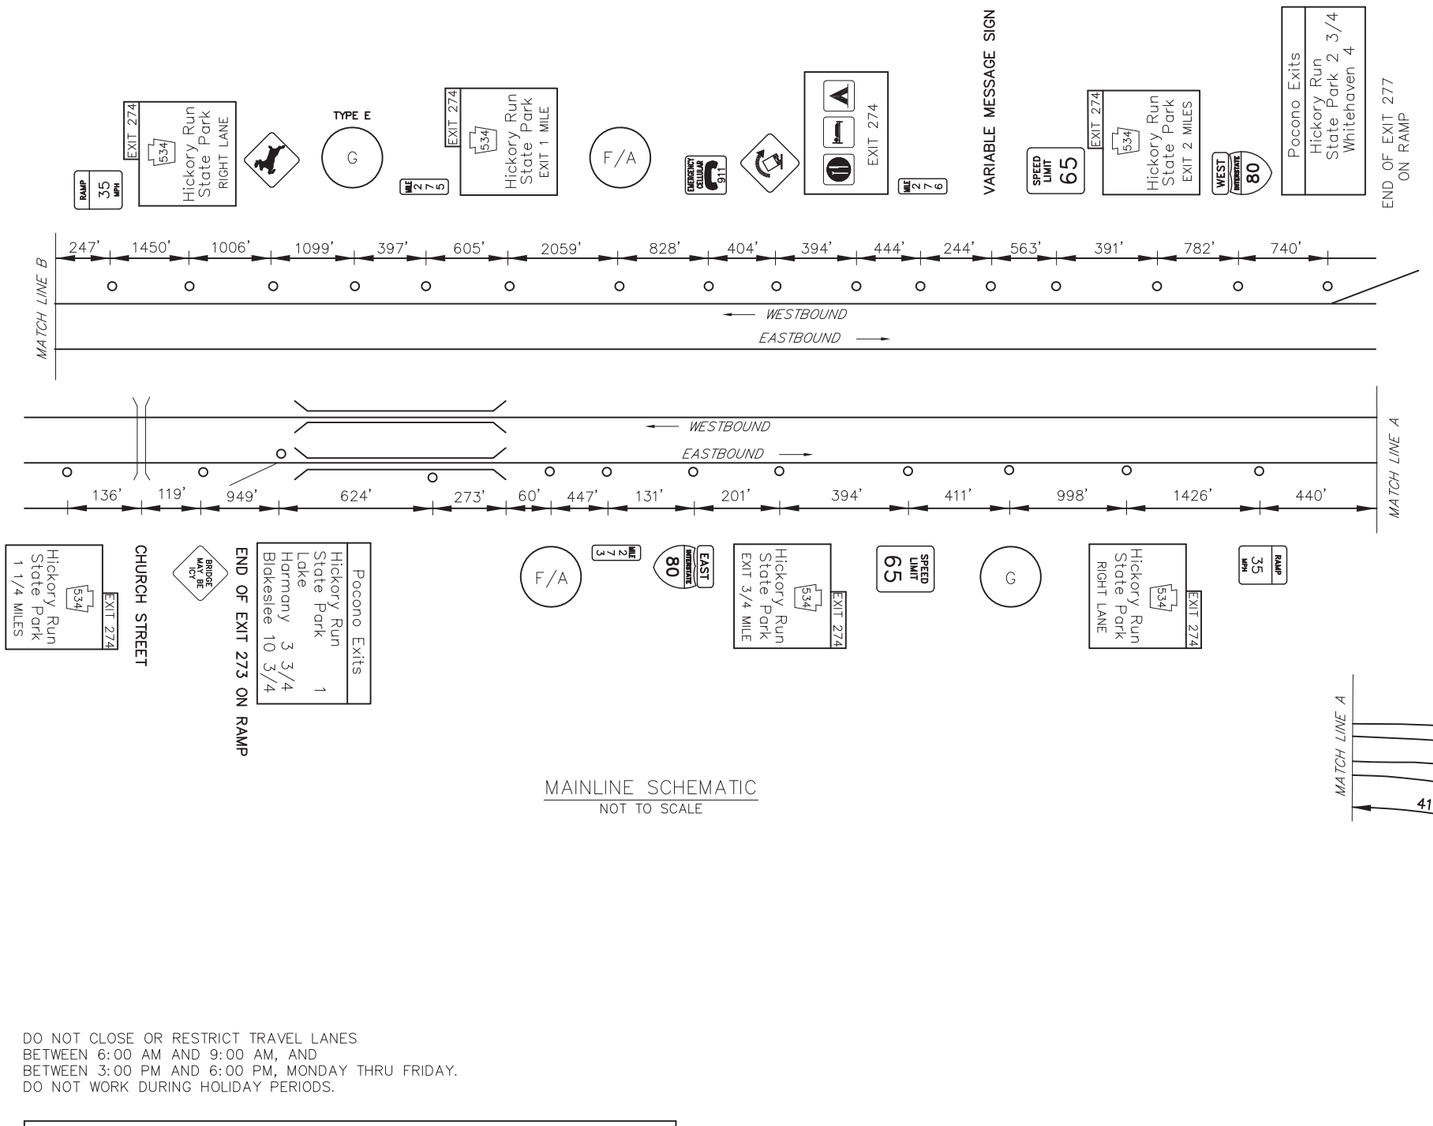

MAINLINE SCHEMATIC
NOT TO SCALE

DO NOT CLOSE OR RESTRICT TRAVEL LANES
BETWEEN 6:00 AM AND 9:00 AM, AND
BETWEEN 3:00 PM AND 6:00 PM, MONDAY THRU FRIDAY.
DO NOT WORK DURING HOLIDAY PERIODS.

EXIT 274 SPECIFIC INFORMATION PANEL			
LEGEND	SIGN NUMBER	BUSINESS	LOGO NO.
FOOD	EB/WB	IHOP	5
GAS	EB/WB	SUNOCO (DIESEL/24 HRS)	1
		EXXON (DIESEL/24 HRS)	2
ATTRACTION	EB/WB		

EB SIGNS

6'Hx13'W
FUTURE 12'H
W8x21
3M TYPE III
UNKN, B525-3

12'Hx13'W
FUTURE 16'H
W14x30
B650 – #2, #2

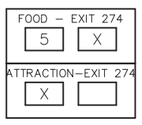

WB SIGNS

6'Hx13'W
TYPE E
3M TYPE III
WOOD POSTS

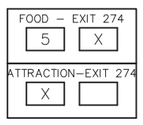

12'Hx13'W
FUTURE 16'H
W14x30
B650 – #2, #2

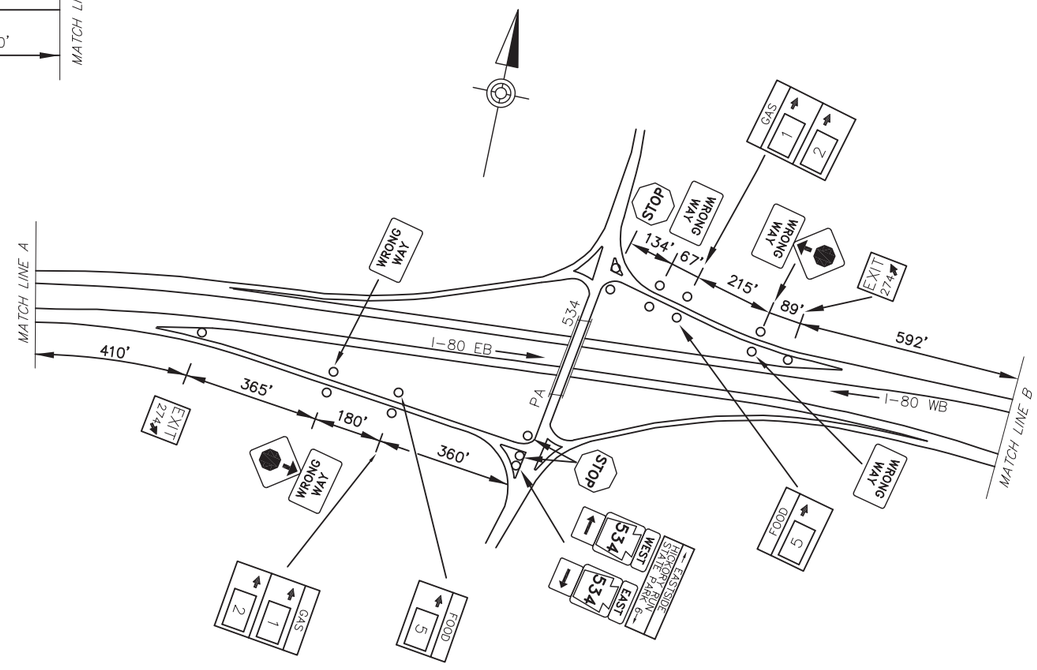

SCHEMATIC PLAN
NOT TO SCALE

INTERSTATE 80

HICKORY RUN STATE PARK

EXIT 274

\\HBG-NAS1\AT\PROJECTS\2015\D35\125076-01\WK\PSE\AS-BUILT DRAWINGS\PENNDOT DISTRICT 05\CARBON - 13\10-XX SHTXX-180_EXIT 274
May/29/2020 11:19 AM