DISTRICT	COUNTY	ROUTE	PROJECT	SHEET
4-0	LACKAWANNA	I-81		
MOOSIC BORO & CITY OF SCRANTON				
REVISIONS				

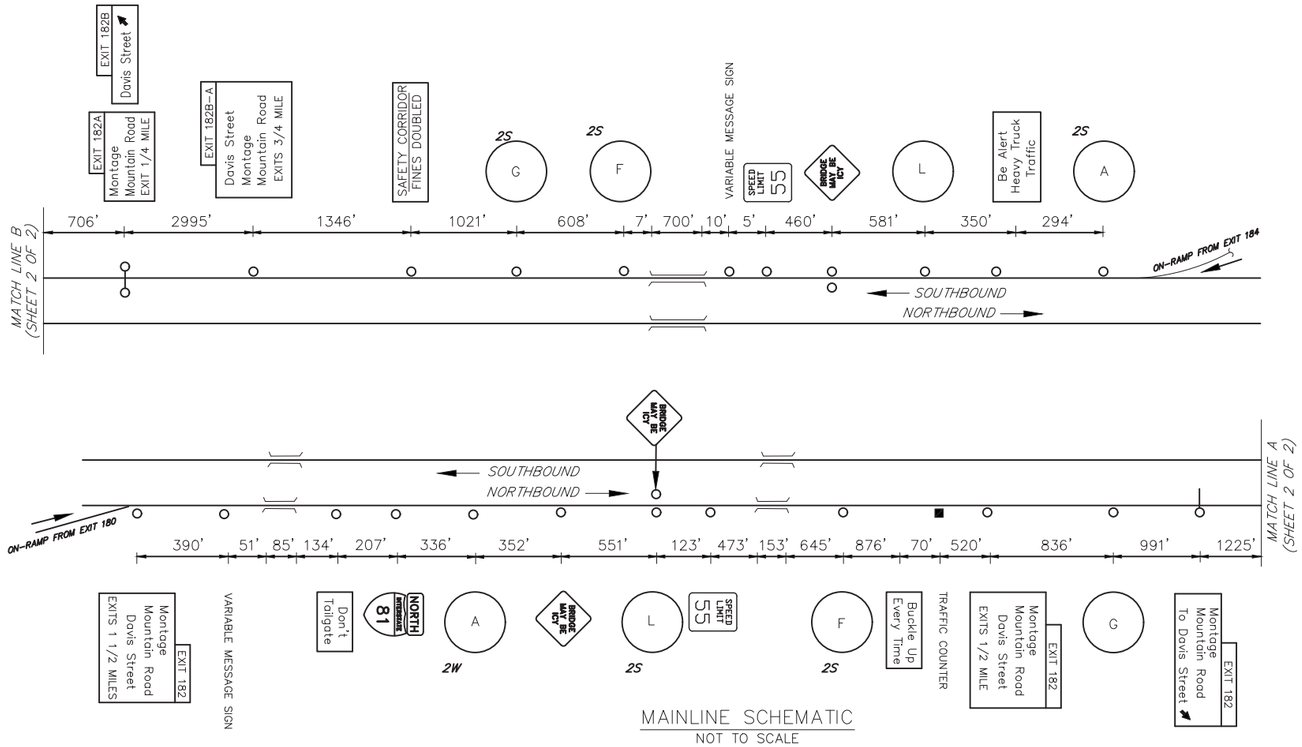

MAINLINE SCHEMATIC
NOT TO SCALE

TABULATION OF QUANTITIES		
ITEM	UNIT	QUANTITY
POST MOUNTED SIGNS, TYPE A, LOGO	SQ.FT.	
POST MOUNTED SIGNS, TYPE A, LOGO (MODIFIED)	SQ.FT.	
POST MOUNTED SIGNS, TYPE C, LOGO	SQ.FT.	
BREAKAWAY SYSTEMS	EACH	
* STEEL S OR W BEAM POSTS	LBS.	
LOGO SIGN MOUNTING	EACH	
LOGO SIGN MOUNTING, RESET	EACH	
REMOVE POST MOUNTED SIGNS, TYPE A LOGO	EACH	
REMOVAL OF POST MOUNTED MOTORIST SERVICE SIGNS, TYPES B, C & F	L.S.	

* APPROXIMATE QUANTITY FOR INFORMATION ONLY

SYMBOLS

- ○ *Existing Sign to Remain*
- △ *Existing Sign to be Removed*
- □ *Existing Sign Reset as Shown*
- ◪ *Existing Sign Foundation*
- ● NEW SIGN
- × FUTURE SIGN
- Ø *Existing Utility Pole*

LEGEND

2S/2W – GUIDE RAIL

FREEWAY LANE CLOSURES & RESTRICTIONS ONLY PERMITTED BETWEEN 9:00 PM AND 6:00 AM MONDAY THRU FRIDAY.
WORK ALONG FREEWAY PERMITTED BETWEEN 9:00 AM AND 2:30 PM, UNLESS OTHERWISE APPROVED BY ENGINEERING DISTRICT.
DO NOT WORK DURING HOLIDAY PERIODS.
IF APPLICABLE, REINSTALL GUIDERAIL AT END OF EACH DAY.

EXIT 182 SPECIFIC INFORMATION PANEL			
LEGEND	DIRECTION	BUSINESS	LOGO NO.
GAS	NB	EXXON (Diesel)	22
	NB/SB	SUNOCO	8
FOOD	SB	WAFFLE HOUSE (24 HOURS)	1
		LONG JOHN SILVER'S	5
		WENDY'S	12
	NB		
		RUBY TUESDAY	16
		MARZONI'S PIZZA AND BREWERY	23
	NB/SB	STARBUCKS	7
		PANERA BREAD	13
		BURGER KING	24
LODGING	SB	RODEWAY INN	3
	NB/SB	ECONOLODGE	2
		SPRINGHILL SUITES – MARRIOTT	4
		HAMPTON INN	6
		COURTYARD – MARRIOTT	10
		COMFORT SUITES	11
		TOWNEPLACE SUITES – MARRIOTT	21
ATTRACTION	NB/SB	LACKAWANNA COUNTY VISITOR CENTER	17
		PNC FIELD	18
		THE PAVILION AT MONTAGE MOUNTAIN	19
		SHOPPES AT MONTAGE	9

POST SPACING SUITED FOR 13'W AND 14'H MAX

	NB SIGNS	SB SIGNS	
GAS	10'H x 19'W FUTURE 14'H** W8x21 A572 AVERY TYPE IV B650 – #4, #4	GAS – EXIT 182: 8, 22 / GAS – EXIT 182B: 8 / GAS – EXIT 182A	12'H x 13'W FUTURE 16'H W10x26 A572 AVERY TYPE IV B650 – #4, #4
FOOD	10'H x 19'W W10x22 A572 B650 – #2, #2 STIM. TYPE III	FOOD – EXIT 182: 7, 16, X, 23, 13, 24 / FOOD – EXIT 182B: 1, 12, 5 / FOOD – EXIT 182A: 7, 13, 24	12'H x 19'W W14x30 B650 – #2, #1 3M TYPE III
LODGING	10'H x 19'W W10x22 A572 B650 – #2, #2 STIM. TYPE III	LODGING – EXIT 182: 10, 6, 11, 2, 21, 4 / LODGING – EXIT 182B: 2, 3 / LODGING – EXIT 182A: 6, 11, 10, 21	16'H x 13'W W14x30 A572 B650 – #2, #2 AVERY TYPE IV
ATTRACTION	10'H x 19'W W10x22 A572 B650 – #2, #1 STIM. TYPE III	ATTRACTION – EXIT 182: 17, 18, 19, 9 / ATTRACTION–EXIT 182A: 17, 18, 19, 9	14'H x 13'W FUTURE 16'H W14x30 A572 B650 – #2, #1 AVERY TYPE III

INTERSTATE 81
DAVIS STREET
EXIT 182
SHEET 1 OF 2

\\VBG-HASUN\DATA\PROJECTS\2015\08126\215076-01\VA\PSE\AS-BUILT DRAWINGS\PENNDOT DISTRICT 04\LACKAWANNA - 35\10-XX SHT0X-181_EXIT 182 PLAN
May/29/2020 9:46 AM

DISTRICT	COUNTY	ROUTE	PROJECT	SHEET
4-0	LACKAWANNA	I-81		
MOOSIC BORO & CITY OF SCRANTON				
REVISIONS				

SYMBOLS

- ○ *Existing Sign to Remain*
- △ *Existing Sign to be Removed*
- □ *Existing Sign Reset as Shown*
- ◪ *Existing Sign Foundation*
- ● NEW SIGN
- × FUTURE SIGN
- Ø *Existing Utility Pole*

TYPE A
9'H x 10'W
W8x18 A572
B525 – #1, #1
3M TYPE III
LOGOS
14"Hx23"W

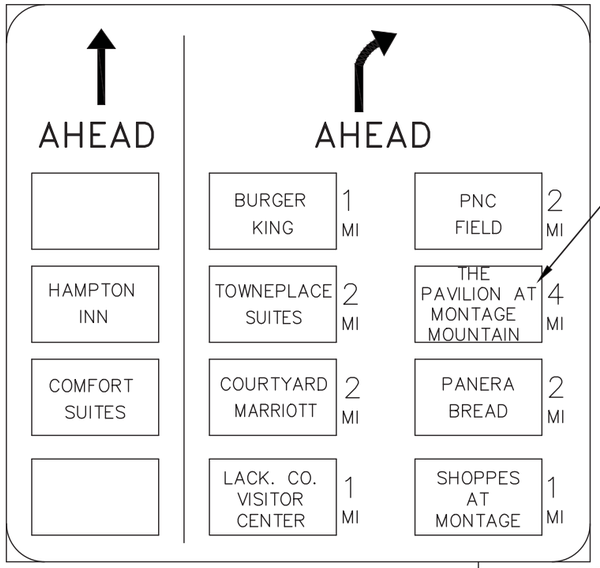

LOGO IS LARGER THAN THE REST

BACKPANEL MOUNTED ON POST #2
LOGOS
14"Hx23"W

BUSINESS	LOGO. NO.
EXXON (Diesel)	22
SUNOCO	8
WAFFLE HOUSE	1
LONG JOHN SILVER'S	5
WENDY'S	12
PANERA BREAD	13
BURGER KING	24
RUBY TUESDAY	16
MARZONI'S PIZZA	23
STARBUCKS	7
ECONOLODGE	2
RODEWAY INN	3
SPRINGHILL SUITES – MARRIOTT	4
HAMPTON INN	6
COURTYARD – MARRIOTT	10
COMFORT SUITES	11
TOWNEPLACE SUITES – MARRIOTT	21
LACKAWANNA COUNTY VISITOR CENTER	17
PNC FIELD	18
THE PAVILION AT MONTAGE MOUNTAIN	19
SHOPPES AT MONTAGE	9

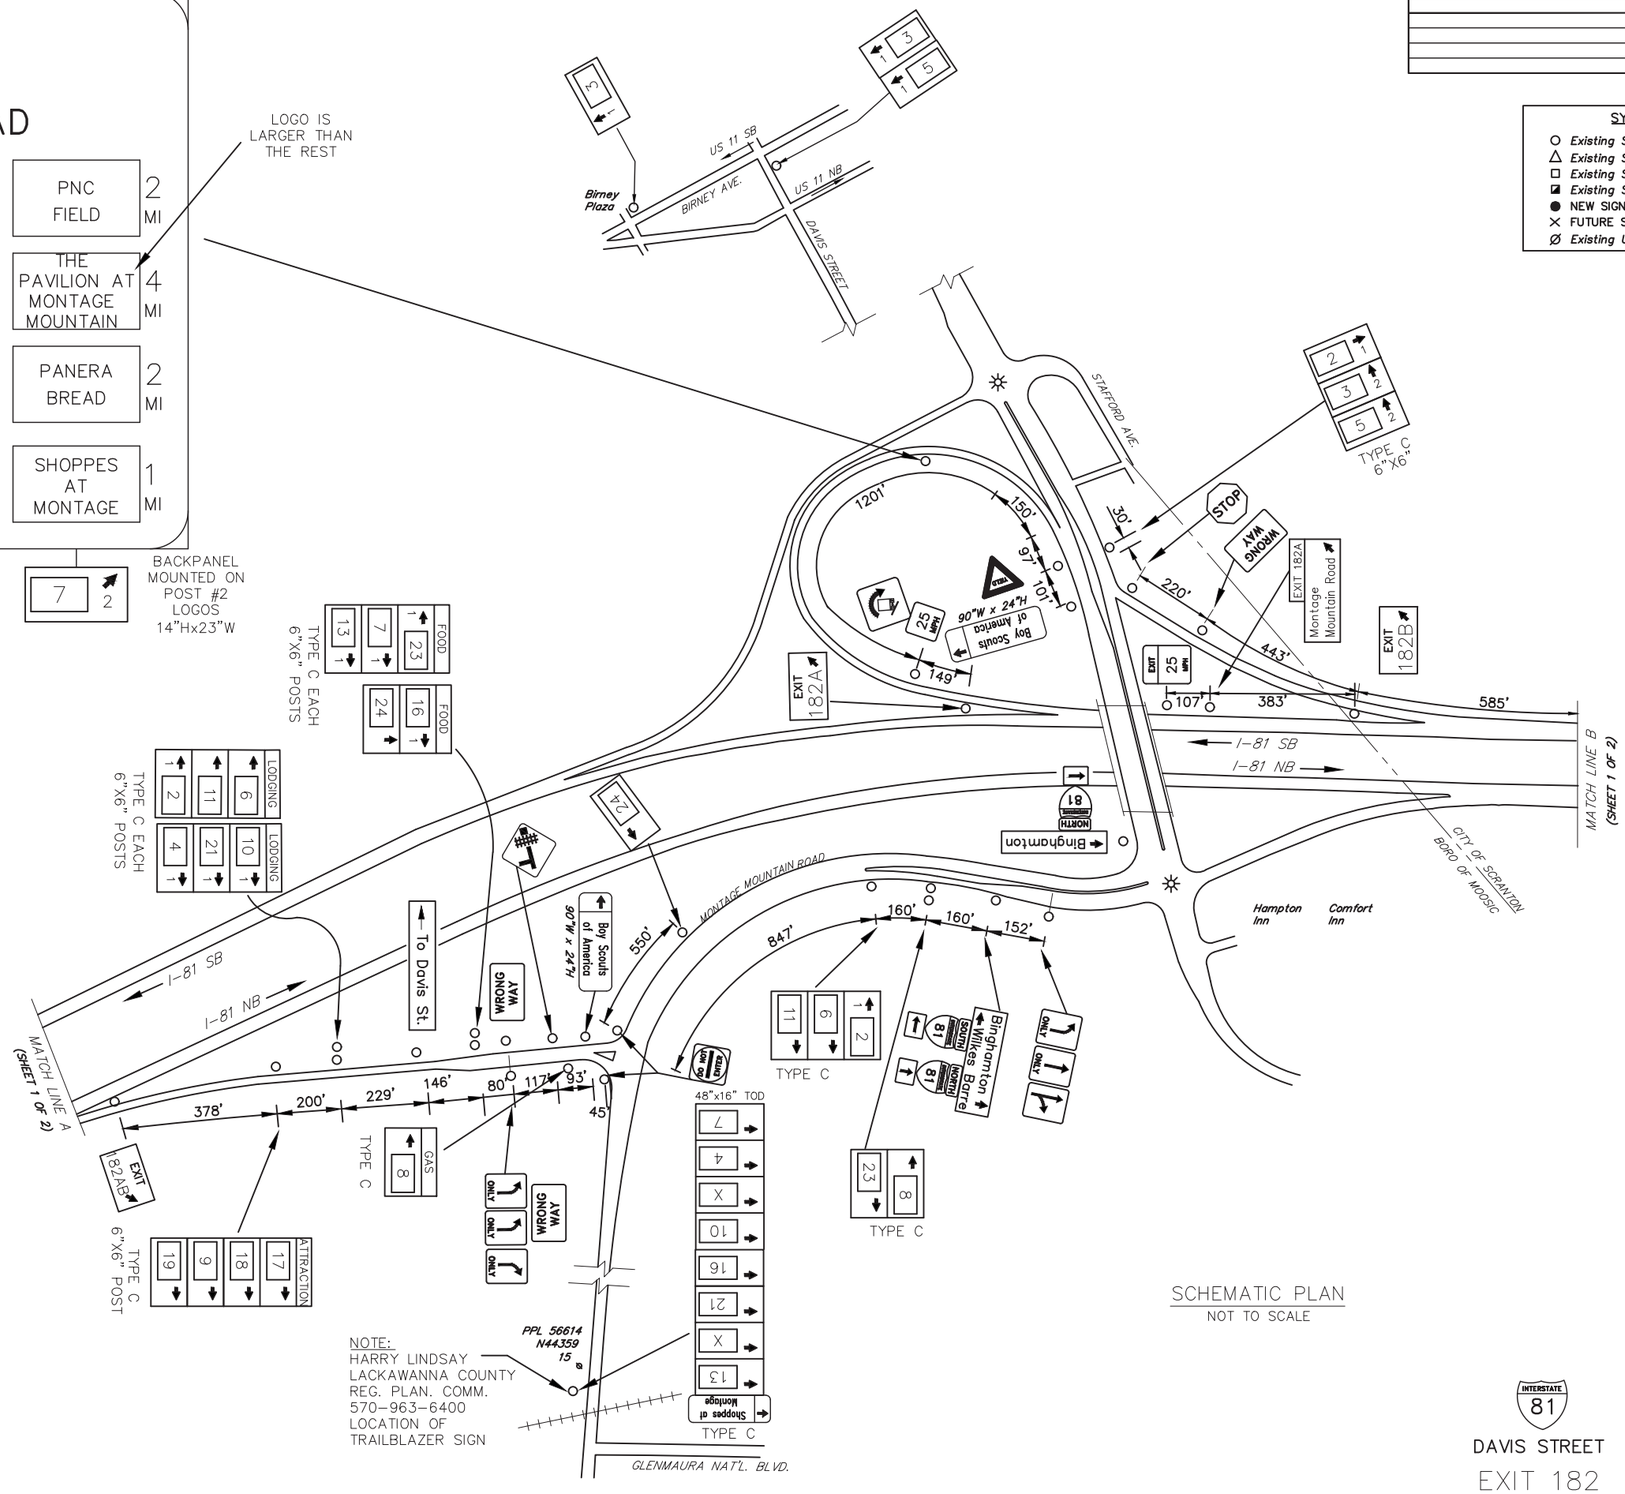

SCHEMATIC PLAN
NOT TO SCALE

INTERSTATE 81

DAVIS STREET

EXIT 182

SHEET 2 OF 2

\\HBG-NAS1\INT\DATA\PROJECTS\2015\2015-215076-01\HV\PSE\AS-BUILT DRAWINGS\PENNDOT DISTRICT 4\LACKAWANNA - 35\10-XX SHT0X-I81_EXIT 182 PLAN
May/29/2020 10:08 AM