DISTRICT	COUNTY	ROUTE	PROJECT	SHEET
4-0	LACKAWANNA	I-81		

SOUTH ABINGTON TWP. & CITY OF SCRANTON

REVISIONS

TABULATION OF QUANTITIES		
ITEM	UNIT	QUANTITY
POST MOUNTED SIGNS, TYPE A, LOGO	SQ.FT.	–
POST MOUNTED SIGNS, TYPE A, LOGO (MODIFIED)	SQ.FT.	
POST MOUNTED SIGNS, TYPE C, LOGO	SQ.FT.	
BREAKAWAY SYSTEMS	EACH	–
* STEEL S OR W BEAM POSTS	LBS.	–
LOGO SIGN MOUNTING	EACH	
LOGO SIGN MOUNTING, RESET	EACH	
REMOVE POST MOUNTED SIGNS, TYPE A LOGO	EACH	
REMOVAL OF POST MOUNTED MOTORIST SERVICE SIGNS, TYPES B, C & F	L.S.	

* APPROXIMATE QUANTITY FOR INFORMATION ONLY

SYMBOLS

- ○ *Existing Sign to Remain*
- △ *Existing Sign to be Removed*
- □ *Existing Sign Reset as Shown*
- ◪ *Existing Sign Foundation*
- ● NEW SIGN
- × FUTURE SIGN
- Ø *Existing Utility Pole*

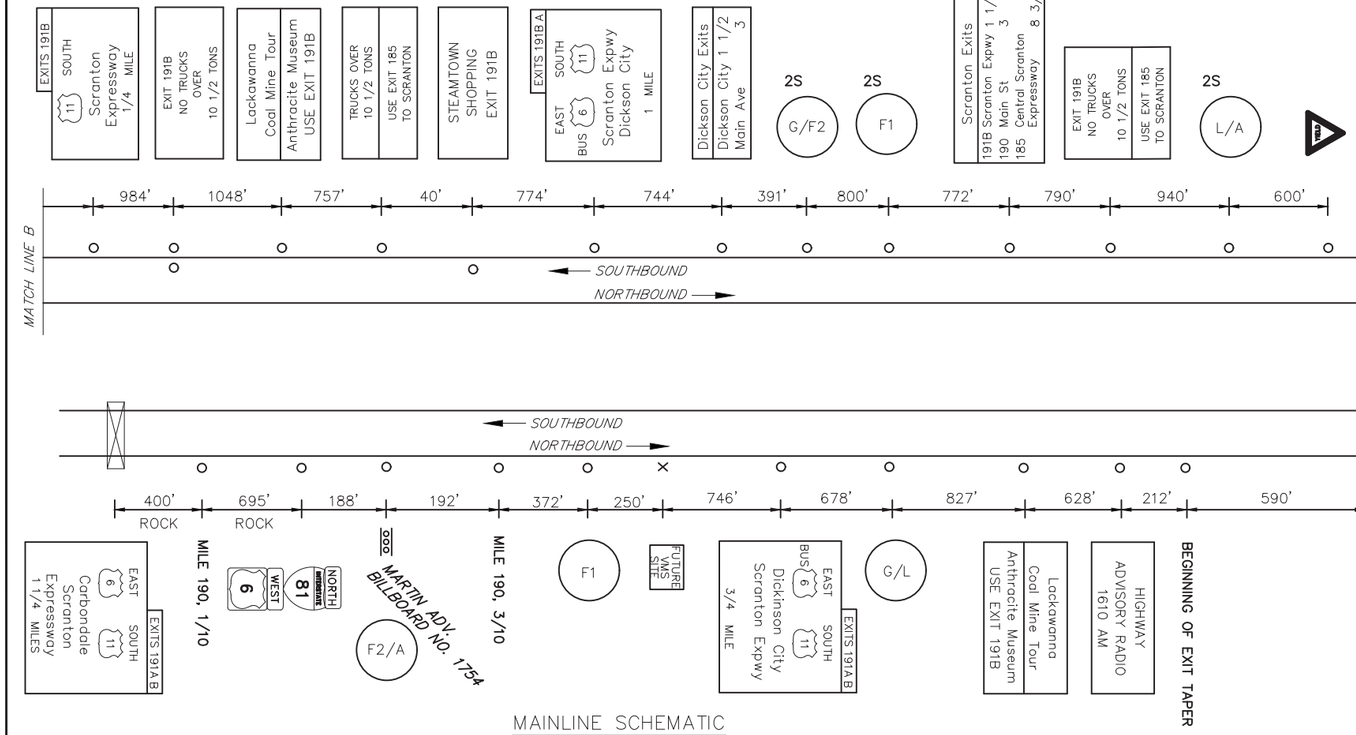

MAINLINE SCHEMATIC
NOT TO SCALE

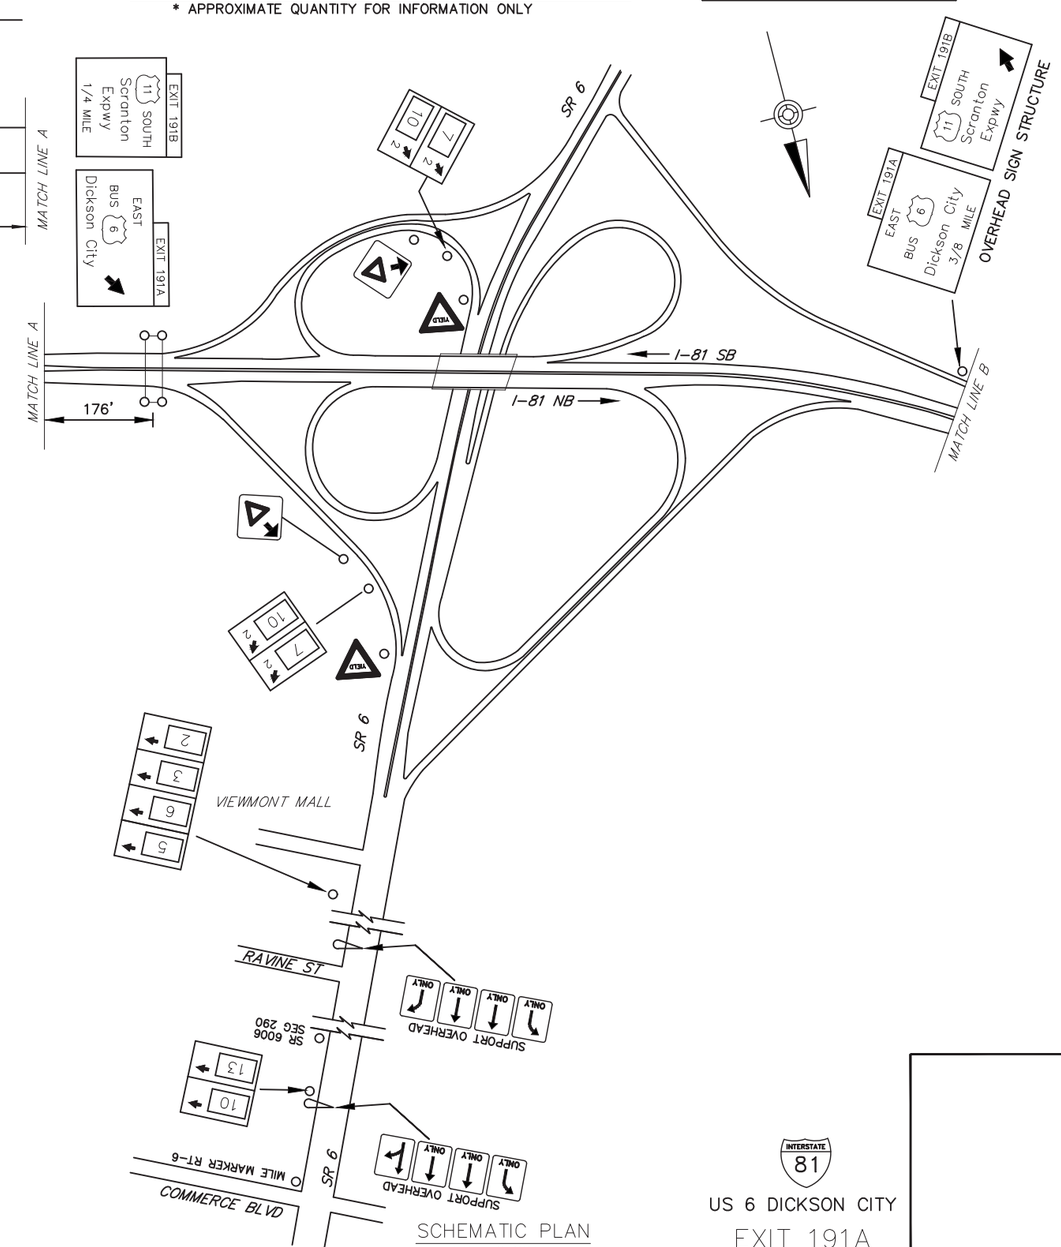

SCHEMATIC PLAN
NOT TO SCALE

LEGEND

2S – GUIDE RAIL

FREEWAY LANE CLOSURES & RESTRICTIONS ONLY PERMITTED BETWEEN 9:00 PM AND 6:00 AM MONDAY THRU FRIDAY.
WORK ALONG FREEWAY PERMITTED BETWEEN 9:00 AM AND 2:30 PM, UNLESS OTHERWISE APPROVED BY ENGINEERING DISTRICT.
DO NOT WORK DURING HOLIDAY PERIODS.
IF APPLICABLE, REINSTALL GUIDERAIL AT END OF EACH DAY.

EXIT 191 SPECIFIC INFORMATION PANEL			
LEGEND	DIRECTION	BUSINESS	LOGO NO.
FOOD	NB/SB	APPLEBEE'S NEIGHBORHOOD GRILL	4
		RUBY TUESDAY	2
		PERKINS FAMILY RESTAURANT	3
		DENNY'S (24 HOURS)	5
		LONG JOHN SILVER'S	6
		TGI FRIDAY'S	11
		STARBUCKS	13
LODGING	NB/SB	DAYS INN	7
		HOLIDAY INN EXPRESS & SUITES	10
		HOME2SUITES	14
ATTRACTION	NB/SB		
GAS	NB/SB	SHEETZ (DIESEL)	9

NB SIGNS

G/L
12'Hx19'W
W14x30 A572
3M TYPE III
SBM-650-#4, #4

GAS – EXIT 191A: 9
LODGING – EXIT 191A: 7 10 14

F1
10'Hx19'W
FUTURE 12'H
W10x22 A572
AVERY TYPE IV
B650-#2, #2

FOOD – EXIT 191A: 4 5 2 / 3 11 6

F2/A
16'Hx13'W
W18x40 A572
3M TYPE III
SBM-650- #4, #4

FOOD – EXIT 191A: 13
ATTRACTION-EXIT 191A: X

SB SIGNS

GAS – EXIT 191A: 9
FOOD – EXIT 191A: 13

FOOD – EXIT 191A: 11 2 / 4 3 / 5 6

LODGING – EXIT 191A: 14 10 / 7
ATTRACTION-EXIT 191A: X

G/F2
12'Hx19'W
FUTURE 14'H
W12x26 A572
3M TYPE III
B650 – #2, #1

F1
14'Hx13'W
W14x30 A572
3M TYPE III
B650 – #1, #1

L/A
16'Hx13'W
W18x40 A572
AVERY TYPE IV
B650-#2, #2

INTERSTATE 81

US 6 DICKSON CITY

EXIT 191A

\\HBG-HASAN\DATA\PROJECTS\2015_EDBS\215076-01\HW\PSE\AS-BUILT DRAWINGS\PENNDOT DISTRICT 04\LACKAWANNA - 351D-XX SHT0X-I81_EXIT 191A PLAN
May/29/2020 10:17 AM