DISTRICT	COUNTY	ROUTE	PROJECT	SHEET
2-0	CENTRE	I-99		

BENNER & COLLEGE TOWNSHIPS

REVISIONS

TABULATION OF QUANTITIES		
ITEM	UNIT	QUANTITY
POST MOUNTED SIGNS, TYPE A, LOGO	SQ.FT.	
POST MOUNTED SIGNS, TYPE B, LOGO	SQ.FT.	
POST MOUNTED SIGNS, TYPE C, LOGO	SQ.FT.	
BREAKAWAY SYSTEMS	EACH	
* STEEL S OR W BEAM POSTS	LBS.	
LOGO SIGN MOUNTING	EACH	
REMOVAL OF POST MOUNTED MOTORIST SERVICE SIGNS, TYPES B, C & F	L.S.	

* APPROXIMATE QUANTITY FOR INFORMATION ONLY

SYMBOLS

- ○ *Existing Sign to Remain*
- △ *Existing Sign to be Removed*
- □ *Existing Sign Reset as Shown*
- ● NEW SIGN
- × FUTURE SIGN
- Ø *Existing Utility Pole*

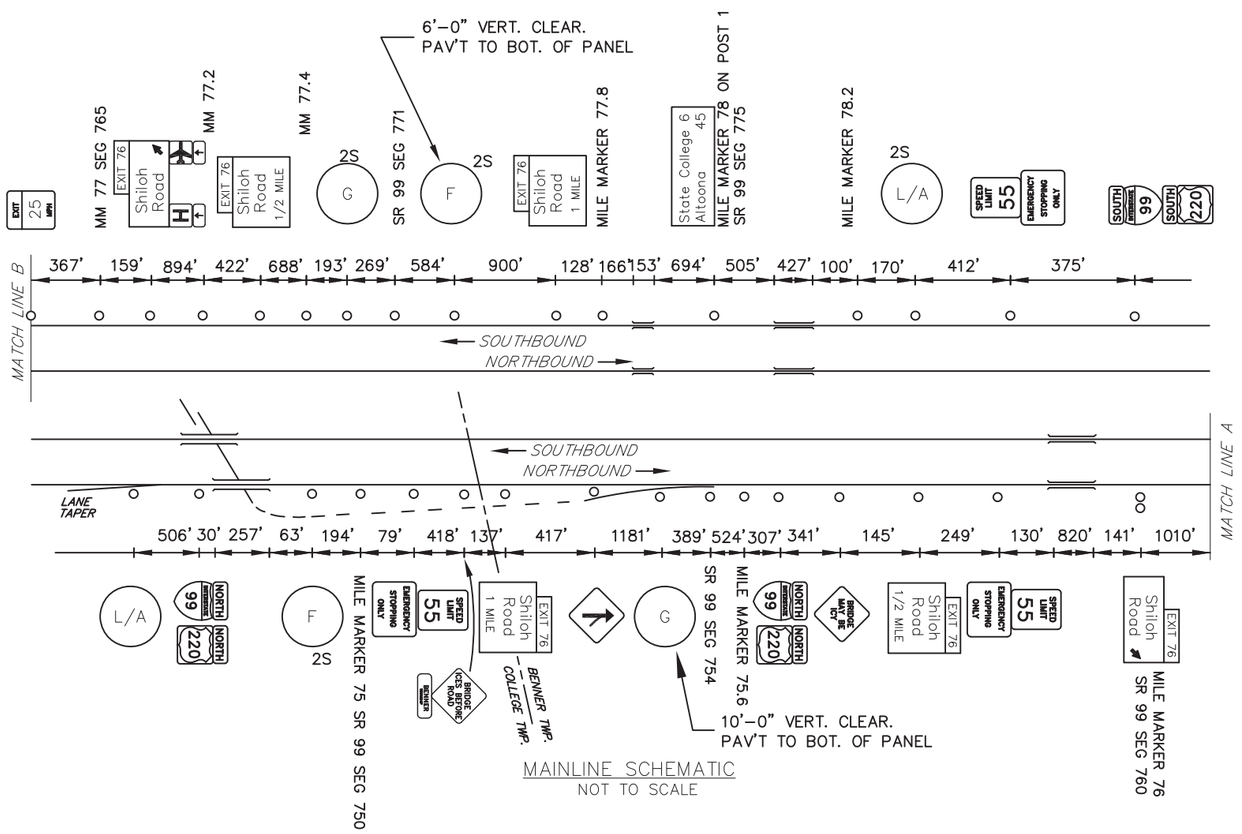

MAINLINE SCHEMATIC
NOT TO SCALE

LEGEND

2S – GUIDE RAIL

FREEWAY LANE CLOSURES/RESTRICTIONS
NOT PERMITTED MONDAY THRU THURSDAY
6:00 – 9:00 AM & 3:00 – 6:00 PM
AND NOT PERMITTED FRIDAY.

EXIT 76 SPECIFIC INFORMATION PANEL			
LEGEND	DIRECTION	BUSINESS	LOGO NO.
FOOD	NB/SB	McDONALD'S (24 HOURS)	2
		QUAKER STEAK & LUBE	6
		PERKINS RESTAURANT & BAKERY	7
		TACO BELL	3
		SHEETZ	8
LODGING	NB/SB	BEST WESTERN PLUS	5
ATTRACTION	NB/SB	NITTANY MALL	1
GAS	NB/SB	SHEETZ	4

NB SIGNS

6'Hx19'W
FUTURE 12'H
W14x30 A572
B650 – #2, #2

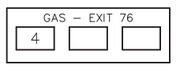

10'Hx19'W
FUTURE 12'H
W12x26 A572
B650 – #2, #1

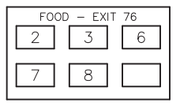

12'Hx19'W
W10x22 A572
B650 – #2, #2

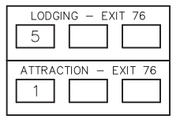

SB SIGNS

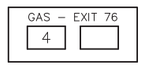

6'Hx13'W
FUTURE 16'H
W14x30 A572
B650 – #2, #2

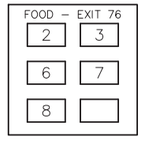

14'Hx13'W
FUTURE 16'H
W14x30 A572
B650 – #2, #1

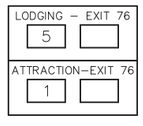

12'Hx13'W
FUTURE 16'H
W14x30 A572
B650 – #1, #2

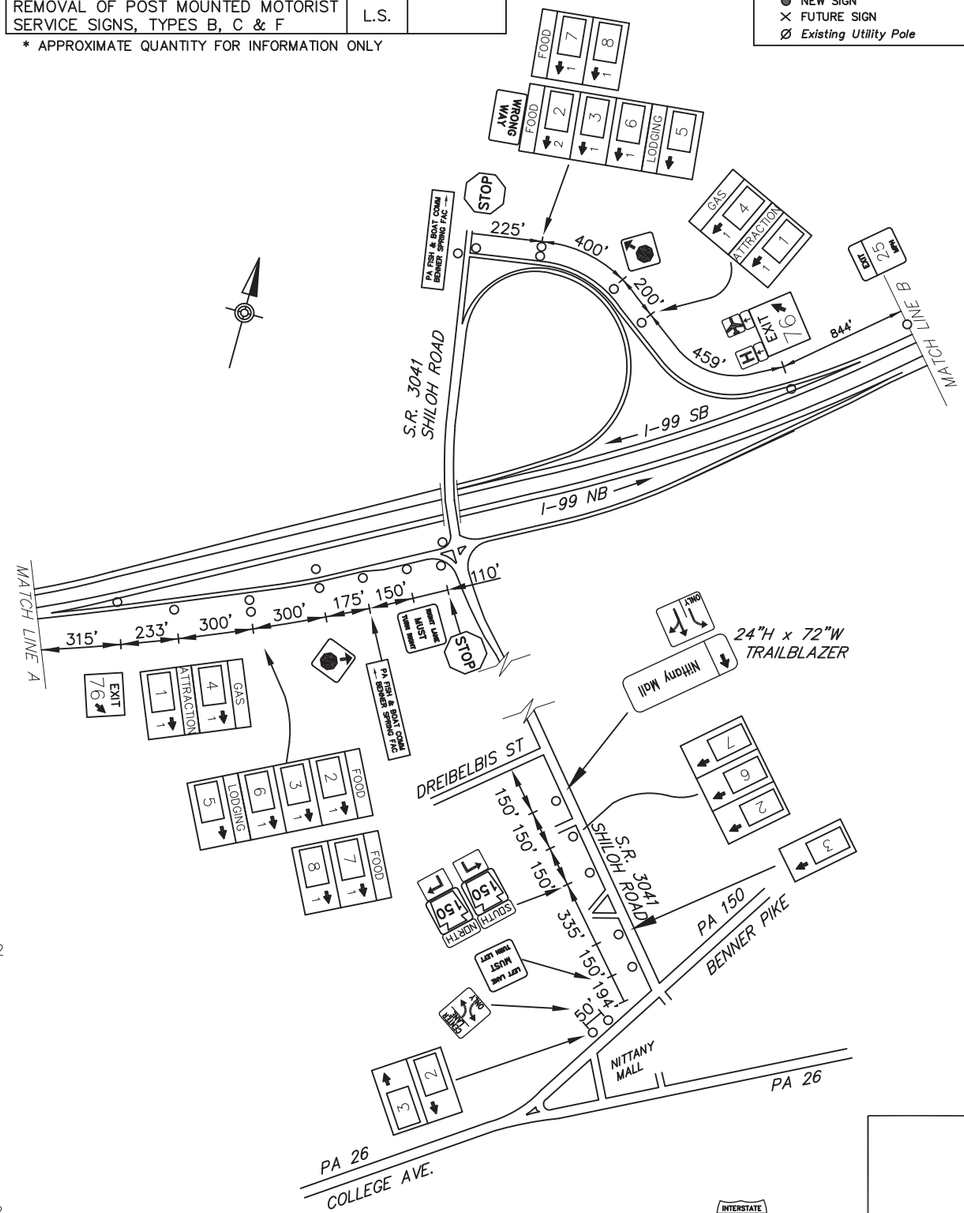

SCHEMATIC PLAN
NOT TO SCALE

INTERSTATE 99

SHILOH RD.
EXIT 76

\\HBG-HAS1\N\DATA\PROJECTS\2015.0285\215076-01\WK\PSE\AS-BUILT DRAWINGS\PENNDOT DISTRICT 02\CENTRE - 14\10-XX SHTXX-I99_EXIT 76 PLAN
May/28/2020 11:01 AM