DISTRICT	COUNTY	ROUTE	PROJECT	SHEET
5-0	NORTHAMPTON	PA 33		
PLAINFIELD TOWNSHIP & WIND GAP BORO				
REVISIONS				

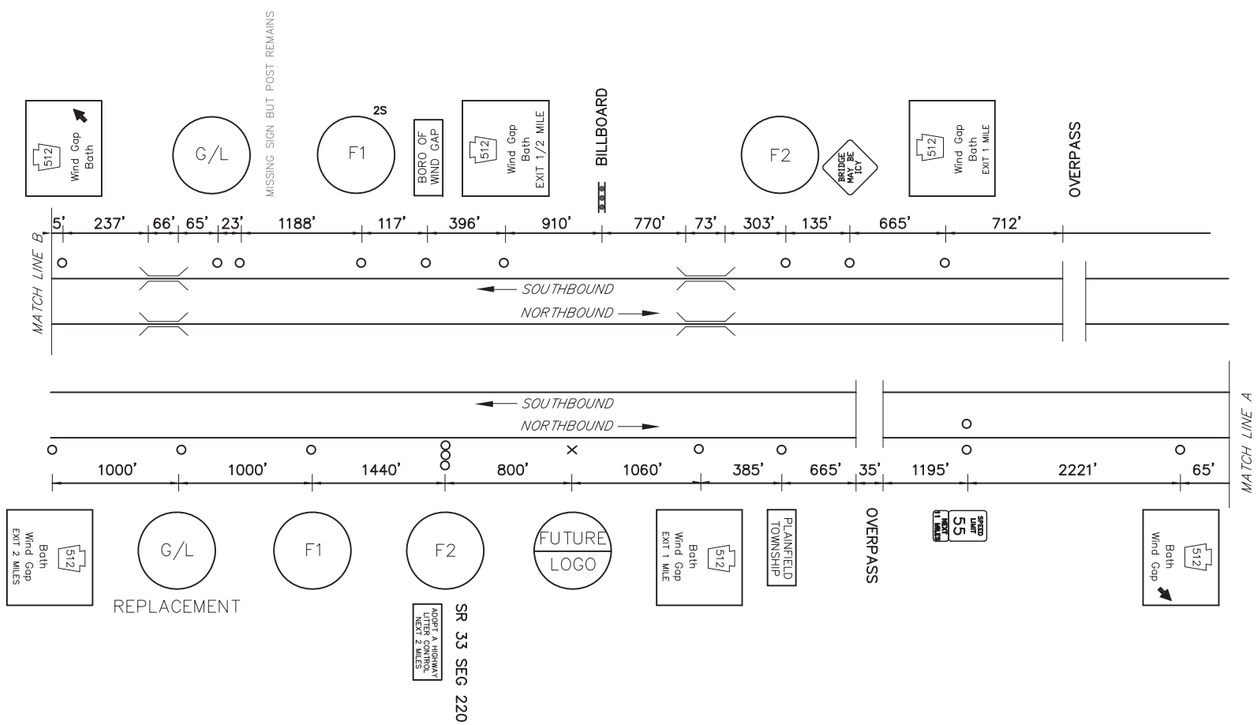

MAINLINE SCHEMATIC
NOT TO SCALE

DO NOT CLOSE OR RESTRICTION TRAVEL LANES
BETWEEN 6:00 AM & 9:00 AM, AND
BETWEEN 3:00 PM & 6:00 PM, MONDAY THRU FRIDAY.
DO NOT WORK DURING HOLIDAY PERIODS.

WIND GAP SPECIFIC INFORMATION PANEL			
LEGEND	DIRECTION	BUSINESS	LOGO NO.
FOOD	NB/SB	DUNKIN' DONUTS	2
		McDONALD'S	4
		ARBY'S	5
		BURGER KING	6
		WENDY'S	9
		GAP DINER (24 HOURS)	10
GAS	NB/SB	VALERO (DIESEL)	7
		SUNOCO (DIESEL)	1
LODGING	NB/SB		

TABULATION OF QUANTITIES		
ITEM	UNIT	QUANTITY
POST MOUNTED SIGNS, TYPE A, LOGO	SQ.FT.	
POST MOUNTED SIGNS, TYPE B, LOGO	SQ.FT.	
POST MOUNTED SIGNS, TYPE C, LOGO	SQ.FT.	
BREAKAWAY SYSTEMS	EACH	
* STEEL S OR W BEAM POSTS	LBS.	
LOGO SIGN MOUNTING	EACH	
REMOVAL OF POST MOUNTED MOTORIST SERVICE SIGNS, TYPES A & E	EACH	
REMOVAL OF POST MOUNTED MOTORIST SERVICE SIGNS, TYPES B, C & F	L.S.	
POST MOUNTED SIGNS SUPPLIED BY TRUST, TYPE A	SQ. FT.	
BREAKAWAY SYSTEMS SUPPLIED BY TRUST	EACH	

* APPROXIMATE QUANTITY FOR INFORMATION ONLY

SYMBOLS
- ○ *Existing Sign to Remain*
- △ *Existing Sign to be Removed*
- □ *Existing Sign Reset as Shown*
- ● NEW SIGN
- × FUTURE SIGN
- Ø *Existing Utility Pole*

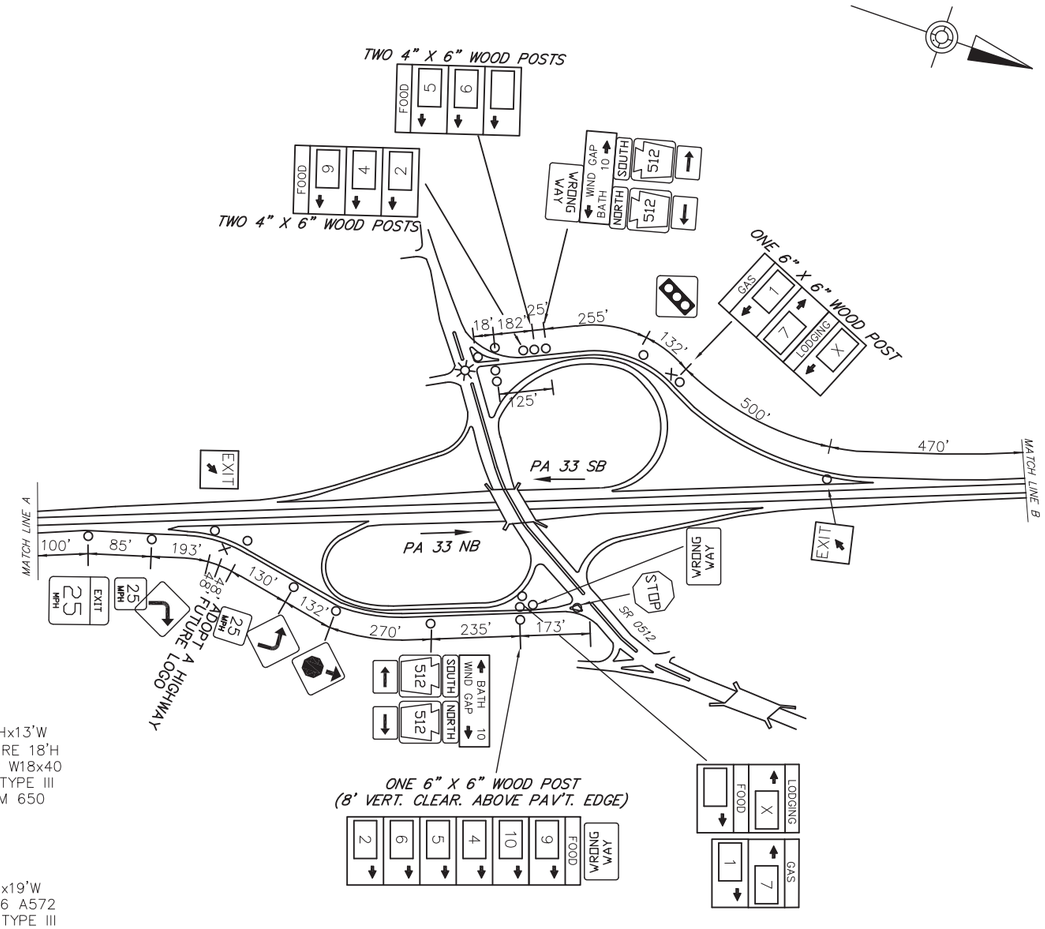

SCHEMATIC PLAN
NOT TO SCALE

NB SIGNS

6'Hx13'W FUTURE 12'H A572 W14x30 3M TYPE III SBM 650 – #4, #4

F2
FOOD – NEXT RIGHT

10'Hx19'W W10x26 A572 STIM. TYPE III OR TYPE IV SBM 650 – #4, #4

FI
FOOD – NEXT RIGHT: 4 5 6 / 9 10 2

12'Hx13'W FUTURE 18'H A572 W14x30 3M TYPE III SBM 650 – #4, #4

GAS – NEXT RIGHT: 7 1
LODGING–NEXT RIGHT: X

SB SIGNS

GAS – NEXT RIGHT: 7 1
LODGING–NEXT RIGHT: X

12'Hx13'W FUTURE 18'H A572 W18x40 3M TYPE III SBM 650

FI
FOOD – NEXT RIGHT: 4 5 6 / 9 2

10'Hx19'W W10x26 A572 STIM. TYPE III OR TYPE IV SBM 650 – #4, #4

F2
FOOD – NEXT RIGHT

6'Hx13'W FUTURE 16'H W18x40 3M TYPE III SBM 650 – #4, #4

33
S.R. 0512
WIND GAP/BATH

\\HBG-NAS01\DATA\PROJECTS\2015\D05\215974-01\PW\PSE\AS-BUILT DRAWINGS\PENNDOT DISTRICT 05\NORTHAMPTON - 48-10-XX SHTXX-33_EXIT WIND GAP PLAN
May/29/2020 11:53 AM