DISTRICT	COUNTY	ROUTE	PROJECT	SHEET
9-0	CAMBRIA	U.S. 219		
RICHLAND TOWNSHIP				
REVISIONS				

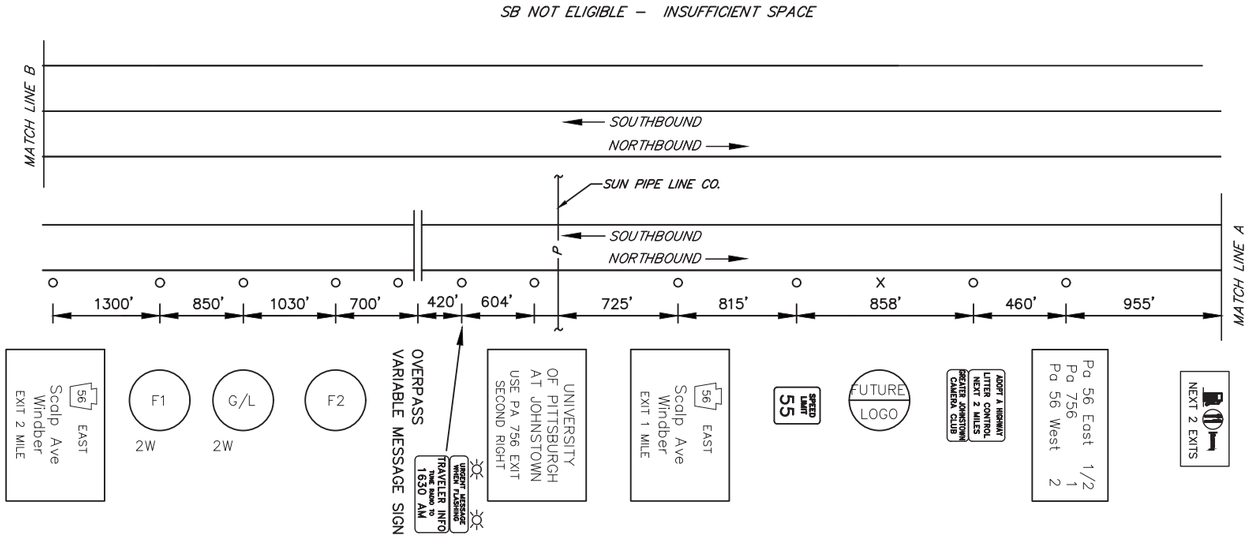

MAINLINE SCHEMATIC
NOT TO SCALE

TABULATION OF QUANTITIES		
ITEM	UNIT	QUANTITY
POST MOUNTED SIGNS, TYPE A, LOGO	SQ.FT.	–
POST MOUNTED SIGNS, TYPE B, LOGO	SQ.FT.	–
BREAKAWAY SYSTEMS	EACH	–
* STEEL W BEAM BREAKAWAY POSTS	LBS.	–
LOGO SIGN MOUNTING	EACH	–

* APPROXIMATE QUANTITY FOR INFORMATION ONLY

SYMBOLS

- ○ *Existing Sign to Remain*
- △ *Existing Sign to be Removed*
- □ *Existing Sign Reset as Shown*
- ○ NEW SIGN
- × FUTURE SIGN
- Ø *Existing Utility Pole*

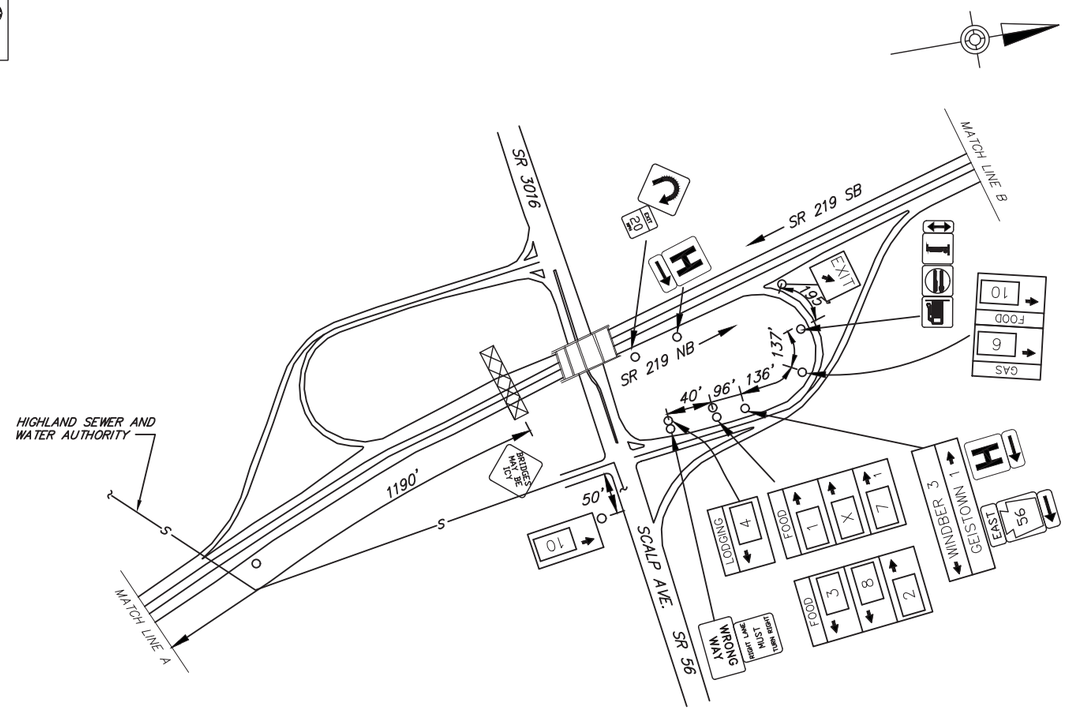

SCHEMATIC PLAN
NOT TO SCALE

LEGEND

2W – GUIDE RAIL

CALL RICHLAND TWP. ZONING OFFICER AT 617-226-2922 TO SPOT SIGN PLACEMENT IN FIELD. STRICT ADHERENCE TO TWP. REQUIREMENTS MUST BE MET.

WINDBER SPECIFIC INFORMATION PANEL			
LEGEND	DIRECTION	BUSINESS	LOGO NO.
GAS	NB	SHEETZ	6
FOOD	NB		
		WENDY'S	2
		DUNKIN'	3
		McDONALD'S	7
		EAT'N PARK	8
		VALLEY DAIRY RESTAURANT	1
		QUAKER STEAK AND LUBE	10
LODGING	NB	HOLIDAY INN EXPESS	4

NB SIGNS

F2
10'H x 19'W
FUTURE 12'H
W8x21 A572
3M TYPE III
B525 – #2, #2

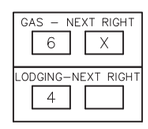

12'H x 13'W
FUTURE 15'H
W12x26 A572
3M TYPE III
B650 – #2, #1

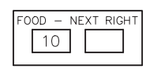

F1
6'H x 13'W
FUTURE 16'H
W14x30 A572
3M TYPE III
B650 – #4, #4

219
PA 56 EAST
WINDBER

D:\2015_JDIS\215076-01\HW\PSE\AS-BUILT DRAWINGS\PENNDOT DISTRICT 09\CAMBRIA - 11\10-XX SHTXX-219_WINDBER EXIT PLAN
July/21/2020 2:06 PM