DISTRICT	COUNTY	ROUTE	PROJECT	SHEET
5-0	BERKS	US 222		
SPRING TOWNSHIP				
REVISIONS				

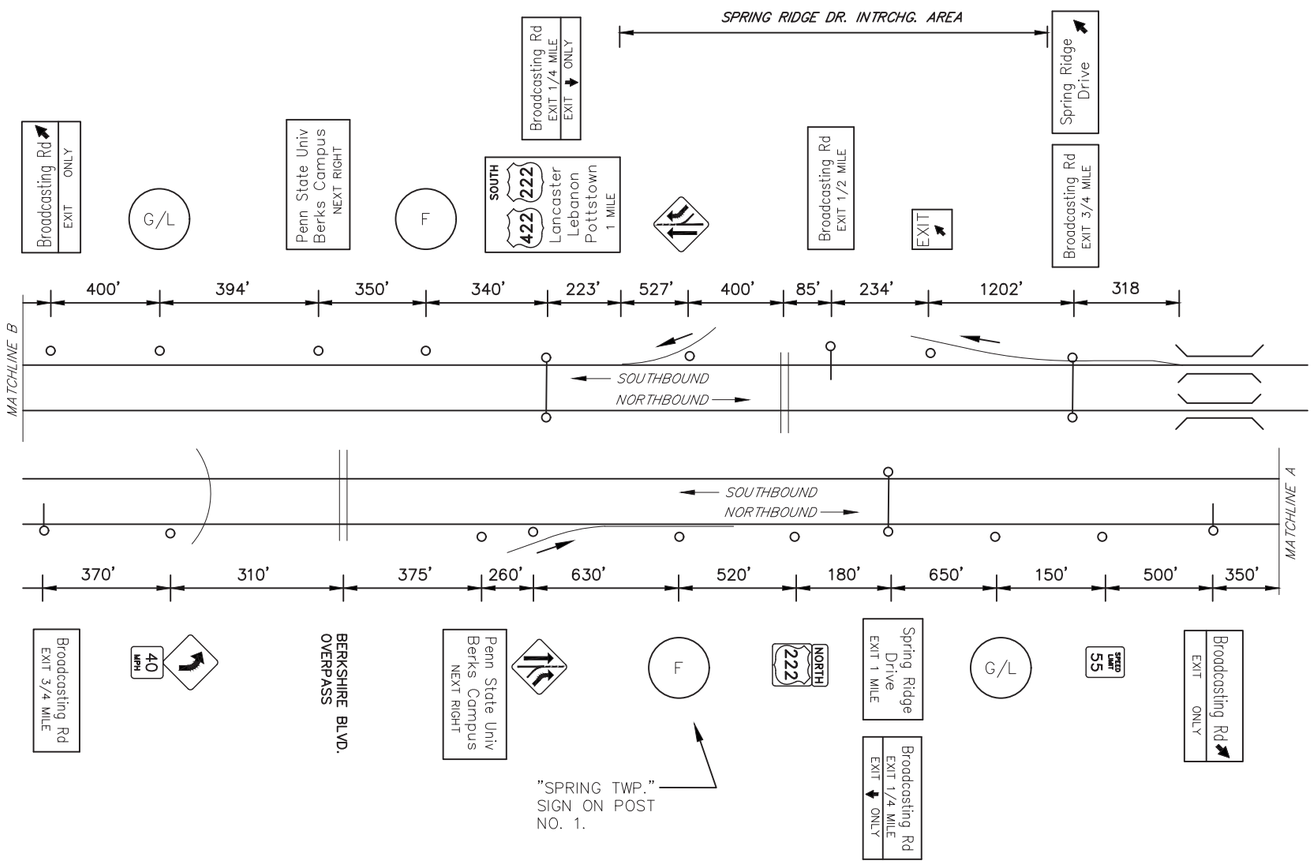

MAINLINE SCHEMATIC
NOT TO SCALE

TABULATION OF QUANTITIES		
ITEM	UNIT	QUANTITY
POST MOUNTED SIGNS, TYPE A, LOGO	SQ.FT.	
POST MOUNTED SIGNS, TYPE B, LOGO	SQ.FT.	
POST MOUNTED SIGNS, TYPE C, LOGO	SQ.FT.	
BREAKAWAY SYSTEMS	EACH	
* STEEL S OR W BEAM POSTS	LBS.	
LOGO SIGN MOUNTING	EACH	
REMOVAL OF POST MOUNTED MOTORIST SERVICE SIGNS, TYPES A & E	EACH	
REMOVAL OF POST MOUNTED MOTORIST SERVICE SIGNS, TYPES B, C & F	L.S.	–

* APPROXIMATE QUANTITY FOR INFORMATION ONLY

SYMBOLS

- ○ *Existing Sign to Remain*
- △ *Existing Sign to be Removed*
- □ *Existing Sign Reset as Shown*
- ● NEW SIGN
- × FUTURE SIGN
- Ø *Existing Utility Pole*

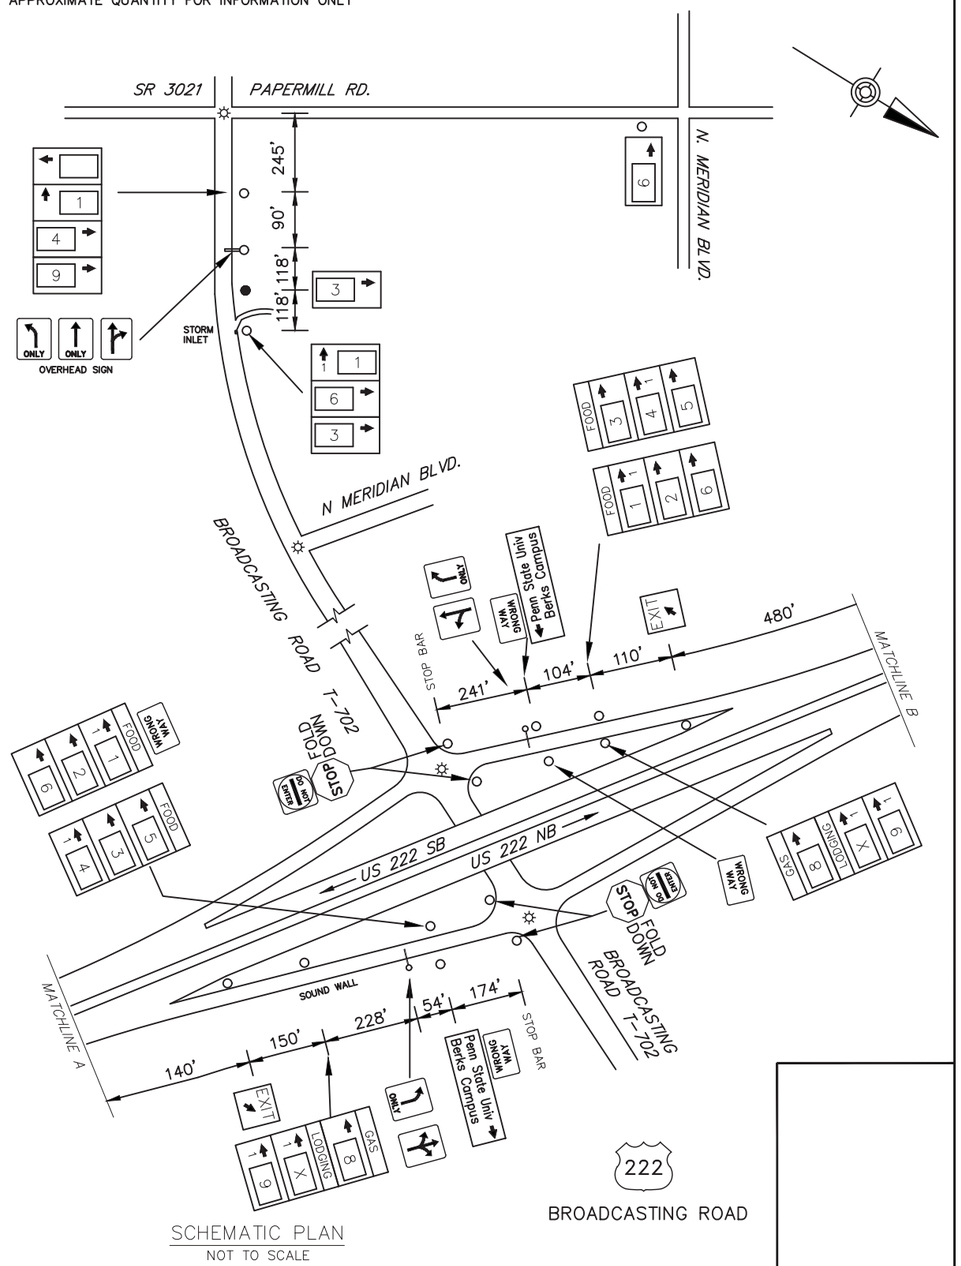

SCHEMATIC PLAN
NOT TO SCALE

DO NOT CLOSE OR RESTRICT TRAVEL LANES BETWEEN 6:00 AM & 9:00 AM, AND BETWEEN 3:00 PM & 6:00 PM MONDAY THRU FRIDAY. DO NOT WORK DURING HOLIDAY PERIODS.

BROADCASTING RD. EXIT SPECIFIC INFORMATION PANEL			
LEGEND	DIRECTION	BUSINESS	LOGO NO.
FOOD	NB/SB	ISSAC'S GRILLED SANDWICHES	1
		WENDY'S	2
		MCDONALD'S	3
		ARBY'S	4
		JERSEY MIKES	5
		CHICK-FIL-A (CLOSED SUNDAY)	6
LODGING	NB/SB		
		FAIRFIELD INN	9
GAS	NB/SB	WAWA (24 Hours/Diesel)	8

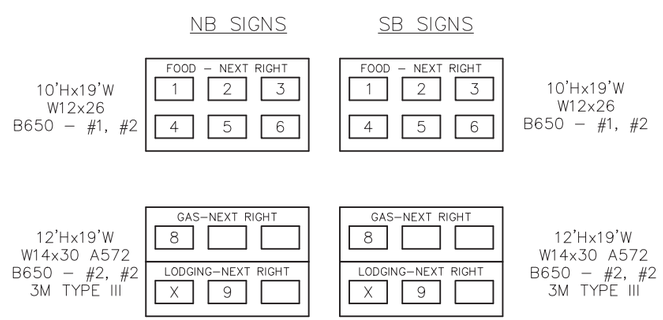

D:\2015JOBS\215076-01\HW\PSE\AS-BUILT DRAWINGS\PENNDOT DISTRICT 05\BERKS - 06\10-XX SHTXX-222_ EXIT BROADCASTING PLAN
July/23/2020 6:00 PM