DISTRICT	COUNTY	ROUTE	PROJECT	SHEET
5-0	MONROE	I-80		
STROUD TOWNSHIP				
REVISIONS				

TABULATION OF QUANTITIES		
ITEM	UNIT	QUANTITY
POST MOUNTED SIGNS, TYPE A, LOGO	SQ.FT.	
POST MOUNTED SIGNS, TYPE B, LOGO	SQ.FT.	
BREAKAWAY SYSTEMS	EACH	
* STEEL S OR W BEAM POSTS	LBS.	
LOGO SIGN MOUNTING	EACH	
REMOVAL OF POST MOUNTED MOTORIST SERVICE SIGNS, TYPES B, C & F	L.S.	

* APPROXIMATE QUANTITY FOR INFORMATION ONLY

SYMBOLS

- ○ *Existing Sign to Remain*
- △ *Existing Sign to be Removed*
- □ *Existing Sign Reset as Shown*
- ● NEW SIGN
- × FUTURE SIGN
- Ø *Existing Utility Pole*

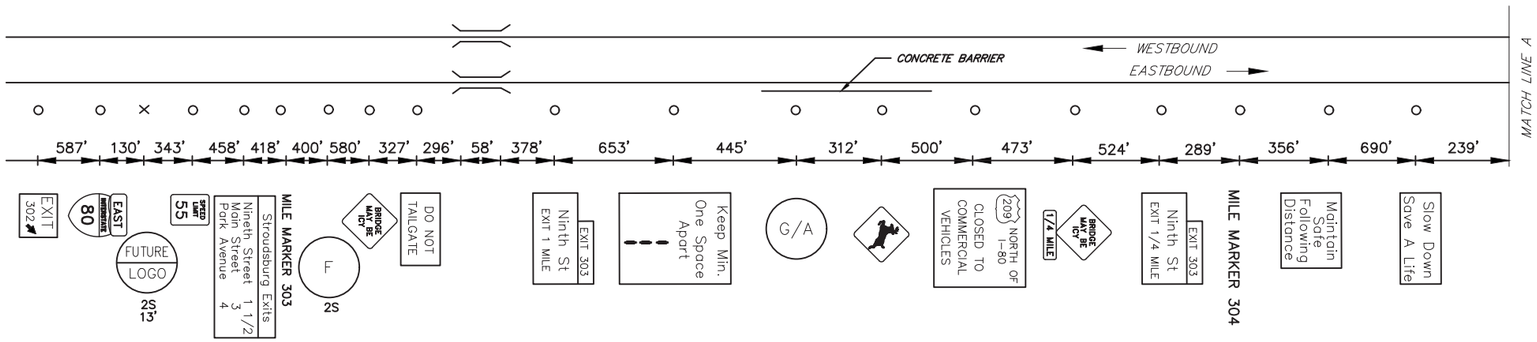

MAINLINE SCHEMATIC
NOT TO SCALE

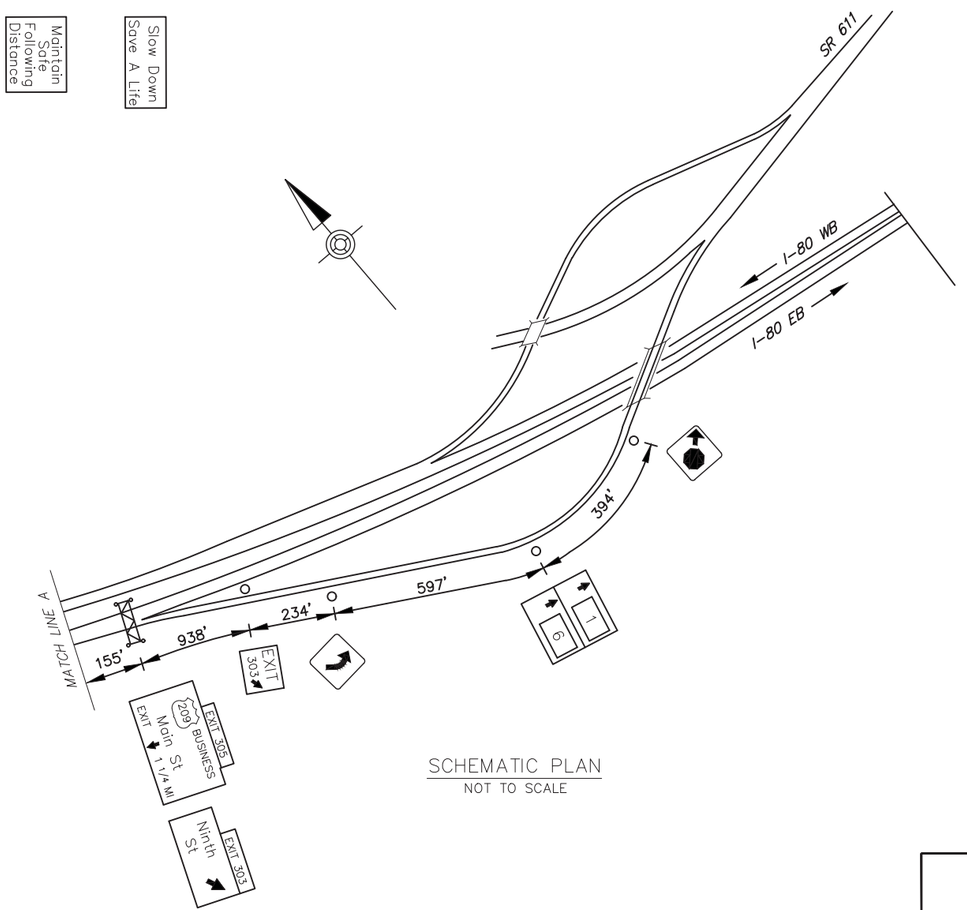

SCHEMATIC PLAN
NOT TO SCALE

LEGEND

2S – GUIDE RAIL

DO NOT CLOSE OR RESTRICT TRAVEL LANES
BETWEEN 6:00 AM AND 9:00 AM, AND
BETWEEN 3:00 PM AND 6:00 PM, MONDAY THRU FRIDAY.
DO NOT WORK DURING HOLIDAY PERIODS.

EXIT 303 SPECIFIC INFORMATION PANEL			
LEGEND	SIGN NUMBER	BUSINESS	LOGO NO.
FOOD	EB	McDONALD'S	1
		WENDY'S	2
		DUNKIN'	3
		RUBY TUESDAY	5
		BURGER KING	7
GAS	EB		
ATTRACTION	EB	STROUD MALL	6

EB SIGNS

12'Hx13'W
FUTURE 16'H
W10x26 A572
3M TYPE III
B650 – #2, #2

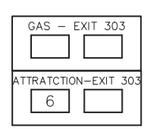

14'Hx13'W
W10x22 A572
B650 – #1, #1

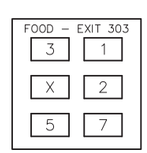

INTERSTATE 80

NINTH STREET
EXIT 303

D:\2015JOBS\215076-01\NV\PSE\AS-BUILT DRAWINGS\PENNDOT DISTRICT 05\MONROE - 45\US-XX SHTXX-180_EXIT 303 PLAN
July/21/2020 12:04 PM