DISTRICT	COUNTY	ROUTE	PROJECT	SHEET
8-0	YORK	I-83		

HOPEWELL & SHREWSBURY TOWNSHIP/
STEWARTSTOWN AND SHREWSBURY BOROUGHS
REVISIONS

TABULATION OF QUANTITIES		
ITEM	UNIT	QUANTITY
POST MOUNTED SIGNS, TYPE A, LOGO	SQ.FT.	–
POST MOUNTED SIGNS, TYPE B, LOGO	SQ.FT.	–
POST MOUNTED SIGNS, TYPE C, LOGO	SQ.FT.	–
BREAKAWAY SYSTEMS	EACH	–
* STEEL S OR W BEAM POSTS	LBS.	–
LOGO SIGN MOUNTING	EACH	–
EXTRUDED PANEL REPLACEMENT	SQ.FT.	
REMOVAL OF POST MOUNTED MOTORIST SERVICE SIGNS, TYPES B, C & F	L.S.	

* APPROXIMATE QUANTITY FOR INFORMATION ONLY

SYMBOLS

- ○ *Existing Sign to Remain*
- △ *Existing Sign to be Removed*
- □ *Existing Sign Reset as Shown*
- ● NEW SIGN
- × FUTURE SIGN
- Ø *Existing Utility Pole*

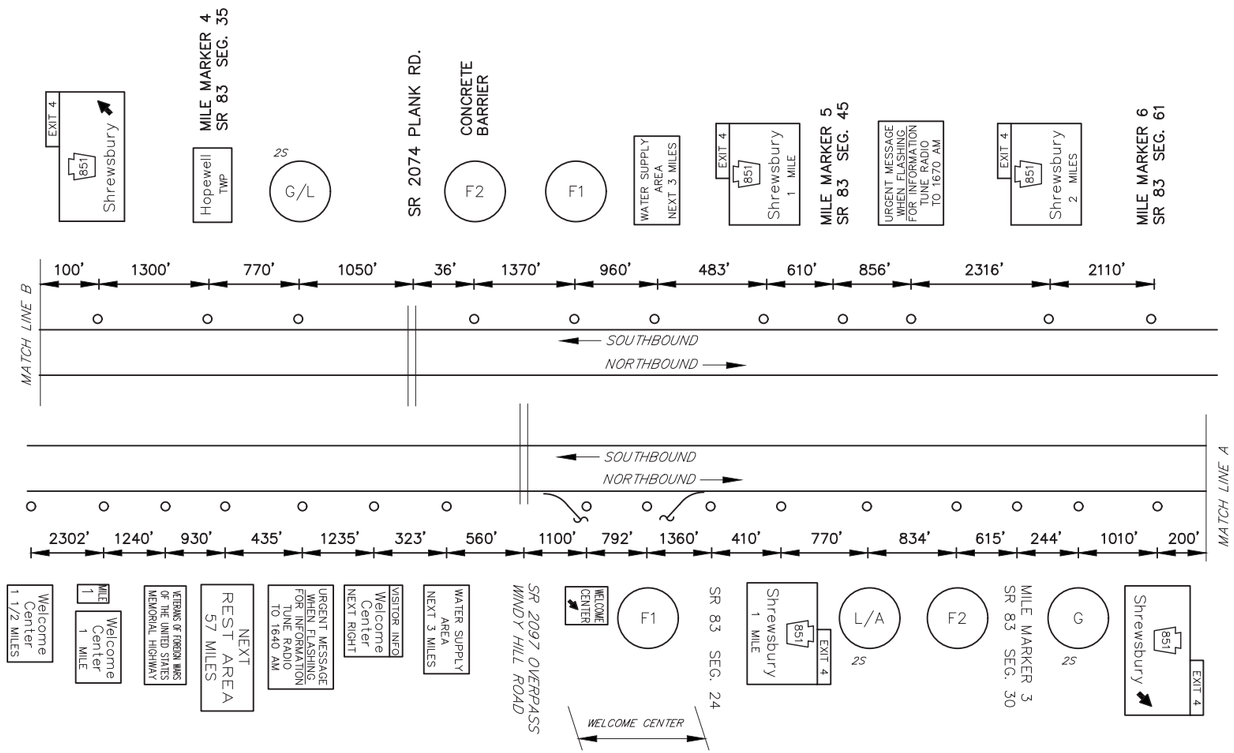

MAINLINE SCHEMATIC
NOT TO SCALE

LEGEND

2S – GUIDE RAIL

EXIT 4 SPECIFIC INFORMATION PANEL			
LEGEND	DIRECTION	BUSINESS	LOGO NO.
FOOD	NB/SB	WENDY'S	3
		McDONALD'S (24 HRS)	4
		ARBY'S	6
		TACO BELL	8
		SUBWAY	9
		STARBUCK'S COFFEE	11
		CHICK-FIL-A (CLOSED SUNDAY)	12
		CRACKER BARREL	13
		PANERA BREAD	5
		BURGER KING	15
GAS	NB/SB		
		TOM'S	2
ATTRACTION	NB		
		ALLEGRO WINERY & VINEYARDS	7
		MARKETS AT SHREWSBURY	1
LODGING	NB/SB		
		HAMPTON INN	10

NB SIGNS

6'Hx16'W 48"W LOGO W6x15 STIM. TYPE III B525 – #1, #1

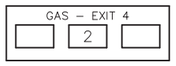

F2 14'Hx13'W W10x22 A572 STIM. TYPE III B650 – #1, #2

12'Hx13'W W14x30 A572 3M TYPE III B650 – #1, #1

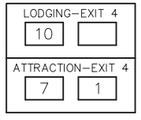

F1 10'Hx19'W FUTURE 16H W18x40 A572 TYPE IX LEGEND TYPE III BACKGROUND B650 – #2 #3

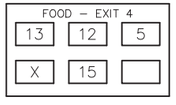

SB SIGNS

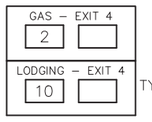

12'Hx13'W FUTURE 16'H W10x26 A572 TYPE IX LEGEND TYPE III BACKGROUND B650 – #1, #1

F2 14'Hx13'W W10x26 3M TYPE III B650 – #2, BURIED

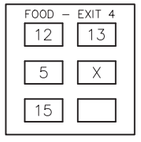

F1 14'Hx13'W FUTURE 16'H W18x35 B650 – #2, #3

D:\2015_JOBS\215076-01\WV\PSE\AS-BUILT DRAWINGS\PENNDOT DISTRICT 08\YORK - 66\10-XX SHT\IX-183_EXIT 4 PLAN
July/02/2020 12:08 PM