DISTRICT	COUNTY	ROUTE	PROJECT	SHEET
5-0	BERKS	I-78		
TILDEN TOWNSHIP				
REVISIONS				

TABULATION OF QUANTITIES		
ITEM	UNIT	QUANTITY
POST MOUNTED SIGNS, TYPE A, LOGO	SQ.FT.	X
POST MOUNTED SIGNS, TYPE B, LOGO	SQ.FT.	X
POST MOUNTED SIGNS, TYPE C, LOGO	SQ.FT.	X
BREAKAWAY SYSTEMS	EACH	X
* STEEL S OR W BEAM POSTS	LBS.	X
LOGO SIGN MOUNTING	EACH	X
RESET OF POST MOUNTED SIGN, TYPE A	EACH	
REMOVAL OF POST MOUNTED MOTORIST SERVICE SIGNS, TYPES B, C & F	L.S.	

* APPROXIMATE QUANTITY FOR INFORMATION ONLY

SYMBOLS

- ○ *Existing Sign to Remain*
- △ *Existing Sign to be Removed*
- □ *Existing Sign Reset as Shown*
- ● NEW SIGN
- × FUTURE SIGN
- Ø *Existing Utility Pole*

WB NOT ELIGIBLE – INSUFFICIENT SPACE

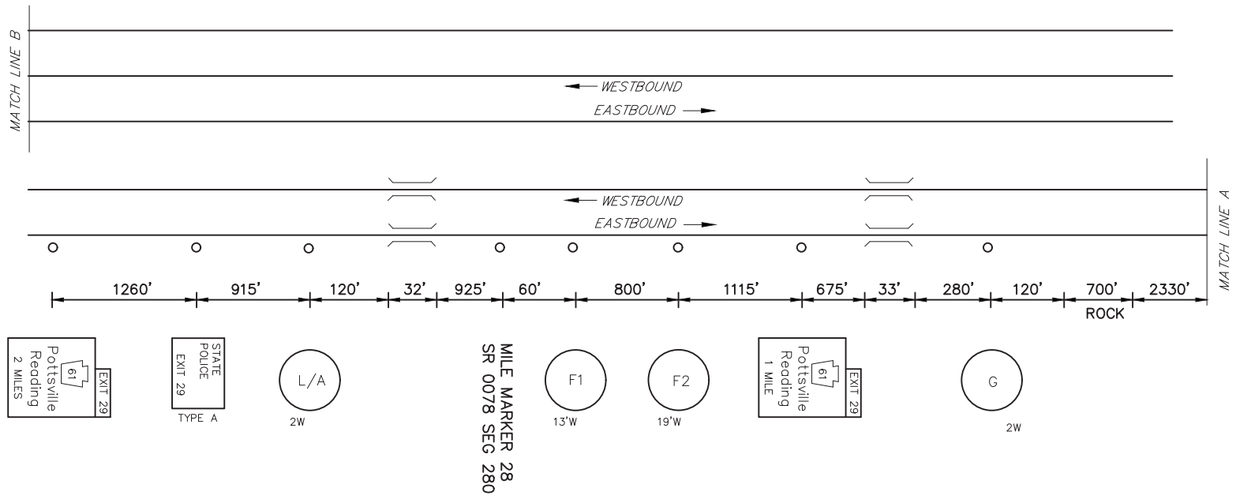

MAINLINE SCHEMATIC
NOT TO SCALE

NO LANE CLOSURES OR RESTRICTIONS PERMITTED
BETWEEN 6:00 AM & 9:00 AM AND BETWEEN
3:00 PM & 6:00 PM MONDAY THRU FRIDAY.
NO WORK PERMITTED DURING HOLIDAY PERIODS.

EXIT 29 SPECIFIC INFORMATION PANEL			
LEGEND	DIRECTION	BUSINESS	LOGO NO.
FOOD	EB	WENDY'S	1
		TACO BELL	2
		BURGER KING	5
		RED ROBIN GOURMET BURGERS	15
		DUNKIN' DONUTS (24 HOURS)	9
		McDONALD'S	11
		ARBY'S	12
		RUTTER'S	18
		LONG JOHN SILVER'S	13
		CRACKER BARREL	14
GAS	EB	SHELL (DIESEL)	3
		WAWA (DIESEL)	8
		RUTTER'S (24 HR/DIESEL)	17
ATTRACTION	EB	HAWK MOUNTAIN	4
LODGING	EB		

EB SIGNS

12'Hx13'W
FUTURE 16'H
W12x26
3M TYPE III
B650 – #1, #1

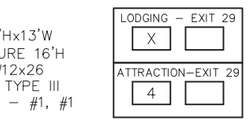

F1
16'Hx13'W
2' EXTRA PANEL
FUTURE 16'H
W12x26 A572
3M TYPE III
B650 – #1, #1

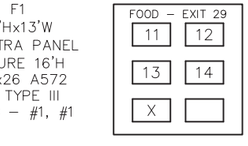

F2
10'Hx19'W
FUTURE 12'H
W14x30 A572
STIM. TYPE IV
B650 – #2, #2

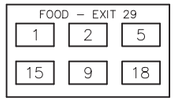

10'Hx13'W
FUTURE 16'H
W14x30 A572
3M TYPE III
B650 – #1, #1

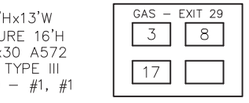

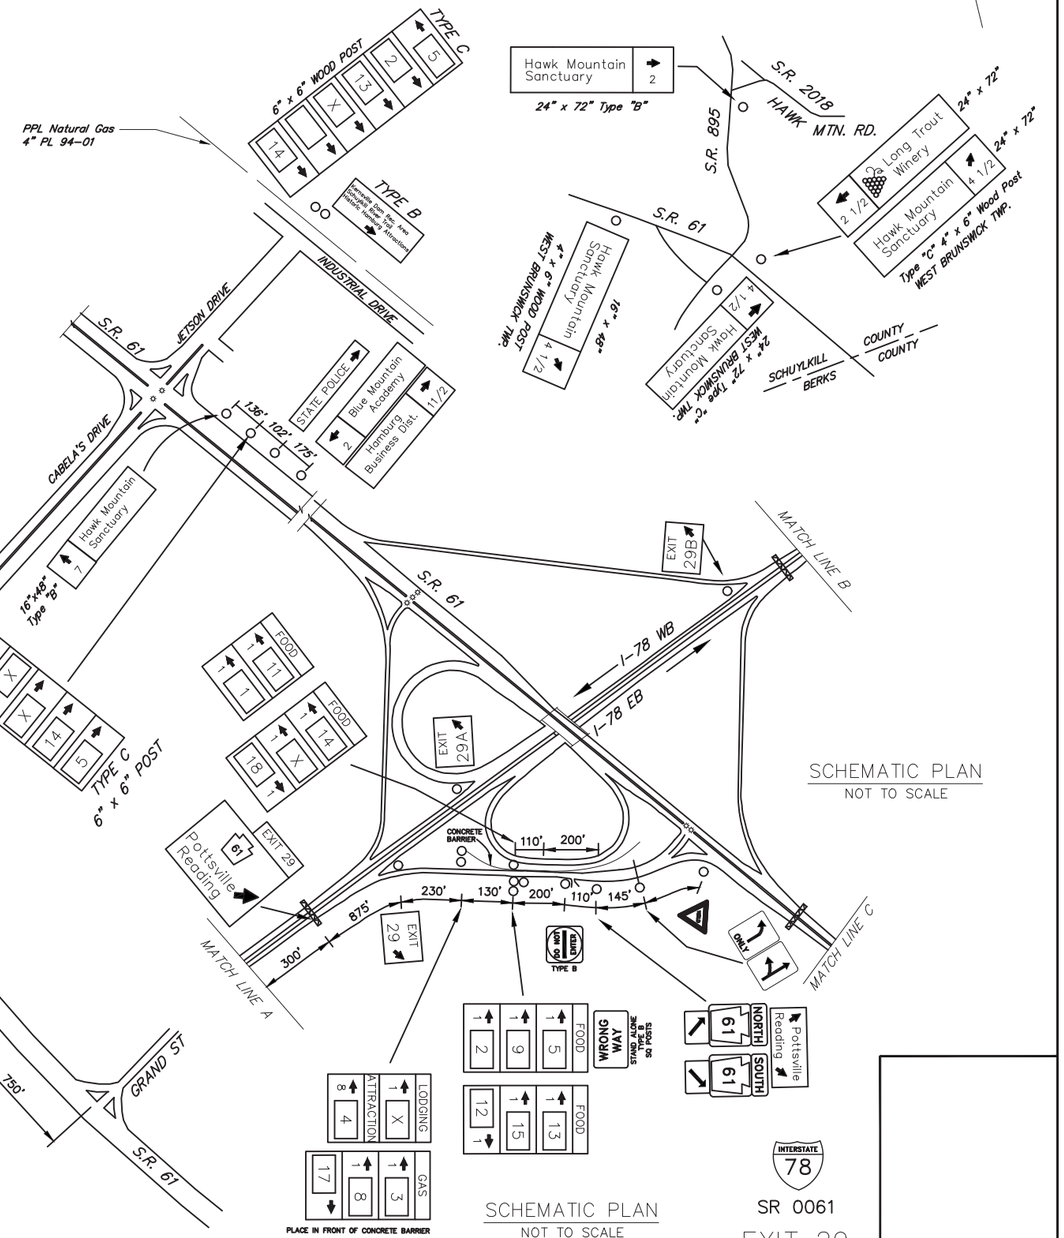

SCHEMATIC PLAN
NOT TO SCALE

SCHEMATIC PLAN
NOT TO SCALE

D:\2015_JOBS\215076-01\WW\PSE\AS-BUILT DRAWINGS\PENNDOT DISTRICT 05\BERKS - 06\10-XX SHTXX-178_EXIT 29 PLAN
July/22/2020 10:54 AM