DISTRICT	COUNTY	ROUTE	PROJECT	SHEET
3-0	TIOGA	US 15		

TIOGA & LAWRENCE TOWNSHIPS

REVISIONS

TABULATION OF QUANTITIES		
ITEM	UNIT	QUANTITY
POST MOUNTED SIGNS, TYPE A, LOGO	SQ.FT.	—
POST MOUNTED SIGNS, TYPE B, LOGO	SQ.FT.	—
POST MOUNTED SIGNS, TYPE C, LOGO	SQ.FT.	—
BREAKAWAY SYSTEMS	EACH	—
* STEEL S OR W BEAM POSTS	LBS.	—
LOGO SIGN MOUNTING	EACH	—
FLAT SHEET PANEL REPLACEMENT	SQ.FT.	
EXTRUDED PANEL REPLACEMENT	SQ.FT.	—
REMOVAL OF POST MOUNTED MOTORIST SERVICE SIGNS, TYPES B, C & F	L.S.	

* APPROXIMATE QUANTITY FOR INFORMATION ONLY

SYMBOLS

- ○ *Existing Sign to Remain*
- △ *Existing Sign to be Removed*
- □ *Existing Sign Reset as Shown*
- ● NEW SIGN
- × FUTURE SIGN
- Ø *Existing Utility Pole*

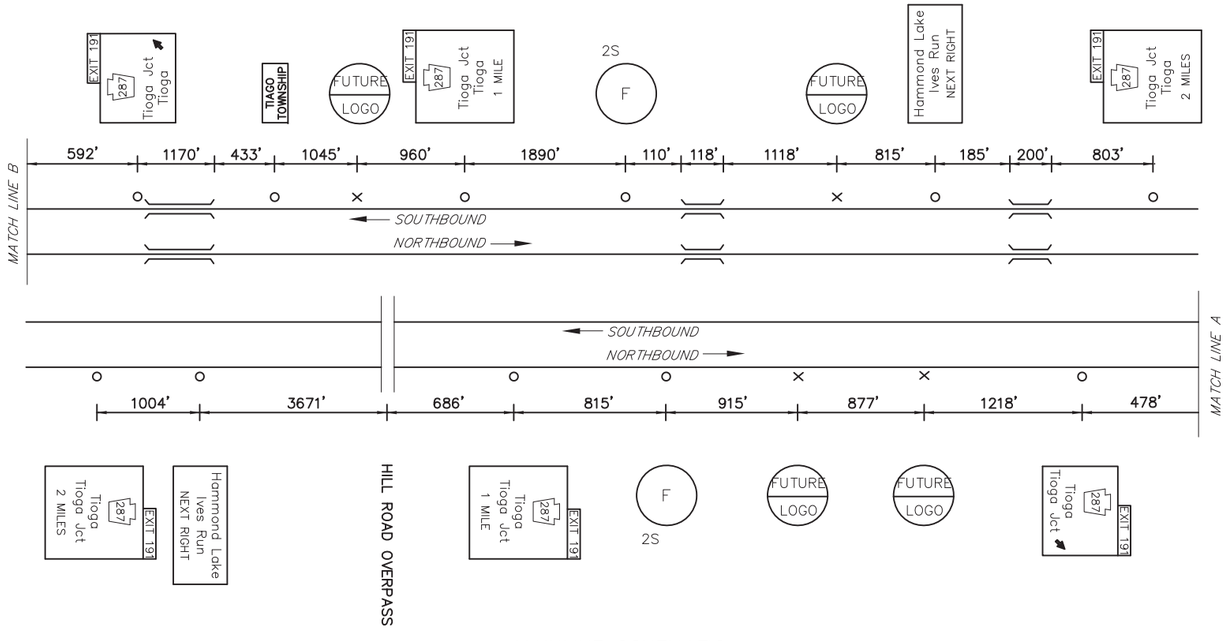

MAINLINE SCHEMATIC
NOT TO SCALE

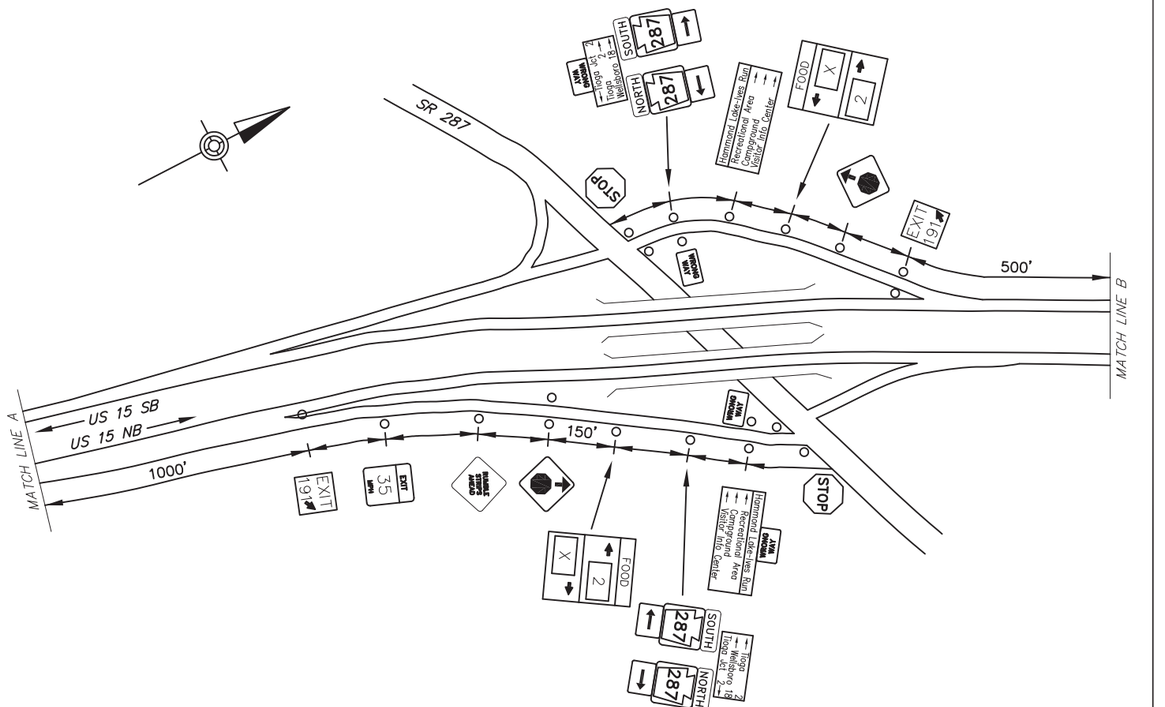

SCHEMATIC PLAN
NOT TO SCALE

LEGEND

2S – GUIDE RAIL

DO NOT CLOSE OR RESTRICT TRAVEL LANES DURING RUSH HOUR.
WORK ALONG FREEWAY PERMITTED BETWEEN 9:00 AM AND 2:30 PM,
UNLESS OTHERWISE APPROVED BY ENGINEERING DISTRICT.
DO NOT WORK DURING HOLIDAY PERIODS.
IF APPLICABLE, REINSTALL GUIDERAIL AT END OF EACH DAY.

EXIT 191 SPECIFIC INFORMATION PANEL			
LEGEND	DIRECTION	BUSINESS	LOGO NO.
FOOD	NB/SB		
		FLORIDA FRYED CHICKEN	2

NB SIGNS

6'Hx13'W
FUTURE 12'H
W8x21 A572
TYPE IX LEGEND
TYPE III
BACKGROUND
B525 – #1, #1

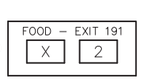

SB SIGNS

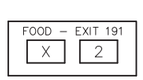

6'Hx13'W
FUTURE 10'H
W8x18 A572
TYPE IX LEGEND
TYPE III
BACKGROUND
B525 – #1, #1

15
SR 287
TIOGA
EXIT 191

\\DAV2DOT\DATA\PROJECTS\0015.0B83\D015076-01\VA\PSE\AS-BUILT DRAWINGS\PENNDOT DISTRICT 03\TIOGA - SR\15-XX SHT XX-I615_EXIT 191 (TIOGA) PLAN
May/3/2021 3:37 PM