DISTRICT	COUNTY	ROUTE	PROJECT	SHEET
12-0	WASHINGTON	I-70	XXX-XX	X OF X
CANTON AND NORTH FRANKLIN TOWNSHIP				
REVISIONS				

TABULATION OF QUANTITIES		
ITEM	UNIT	QUANTITY
POST MOUNTED SIGNS, TYPE A, LOGO	SQ.FT.	--
POST MOUNTED SIGNS, TYPE A, LOGO (MODIFIED)	SQ.FT.	--
POST MOUNTED SIGNS, TYPE B, LOGO	SQ.FT.	--
BREAKAWAY SYSTEMS	EACH	--
* STEEL S OR W BEAM POSTS	LBS.	--
LOGO SIGN MOUNTING	EACH	--
LOGO SIGN MOUNTING, RESET	EACH	--
REMOVE POST MOUNTED SIGNS, TYPE A LOGO (MODIFIED)	EACH	--
REMOVE POST MOUNTED SIGNS, TYPE E SERVICE SIGNS, TYPES B, C & F	EACH	--

* APPROXIMATE QUANTITY FOR INFORMATION ONLY

SYMBOLS

- *Existing Sign to Remain*
- *Existing Sign to be Removed*
- *Existing Sign Reset as Shown*
- NEW SIGN
- FUTURE SIGN
- *Existing Utility Pole*

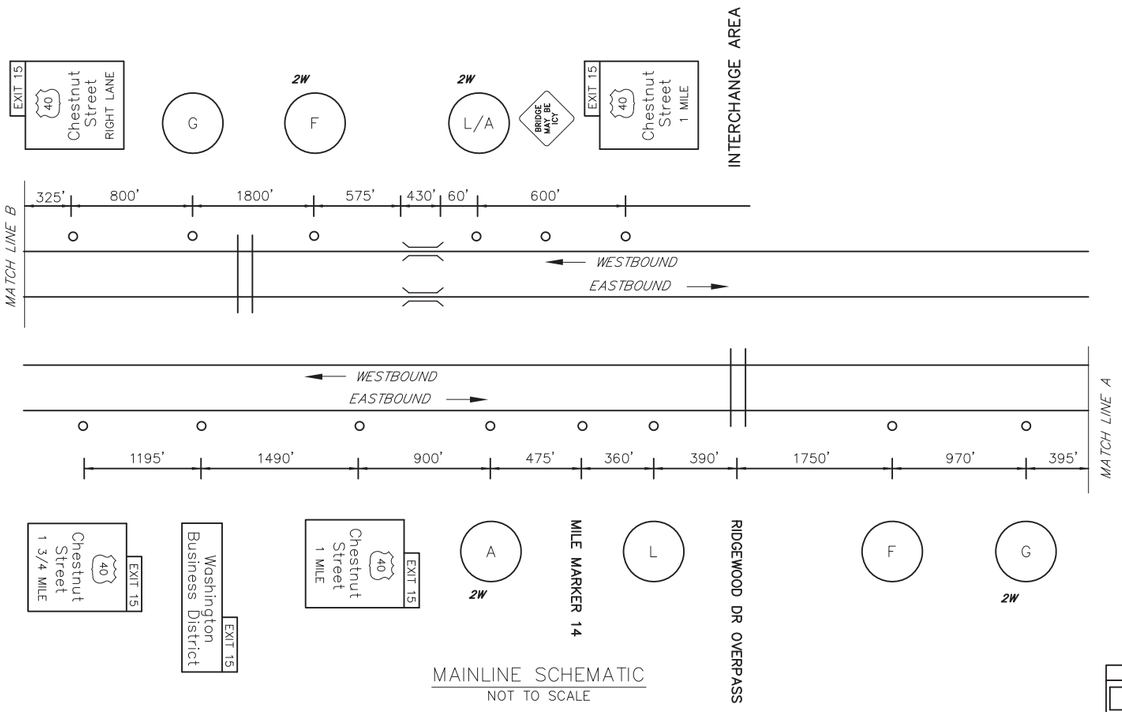

MAINLINE SCHEMATIC
NOT TO SCALE

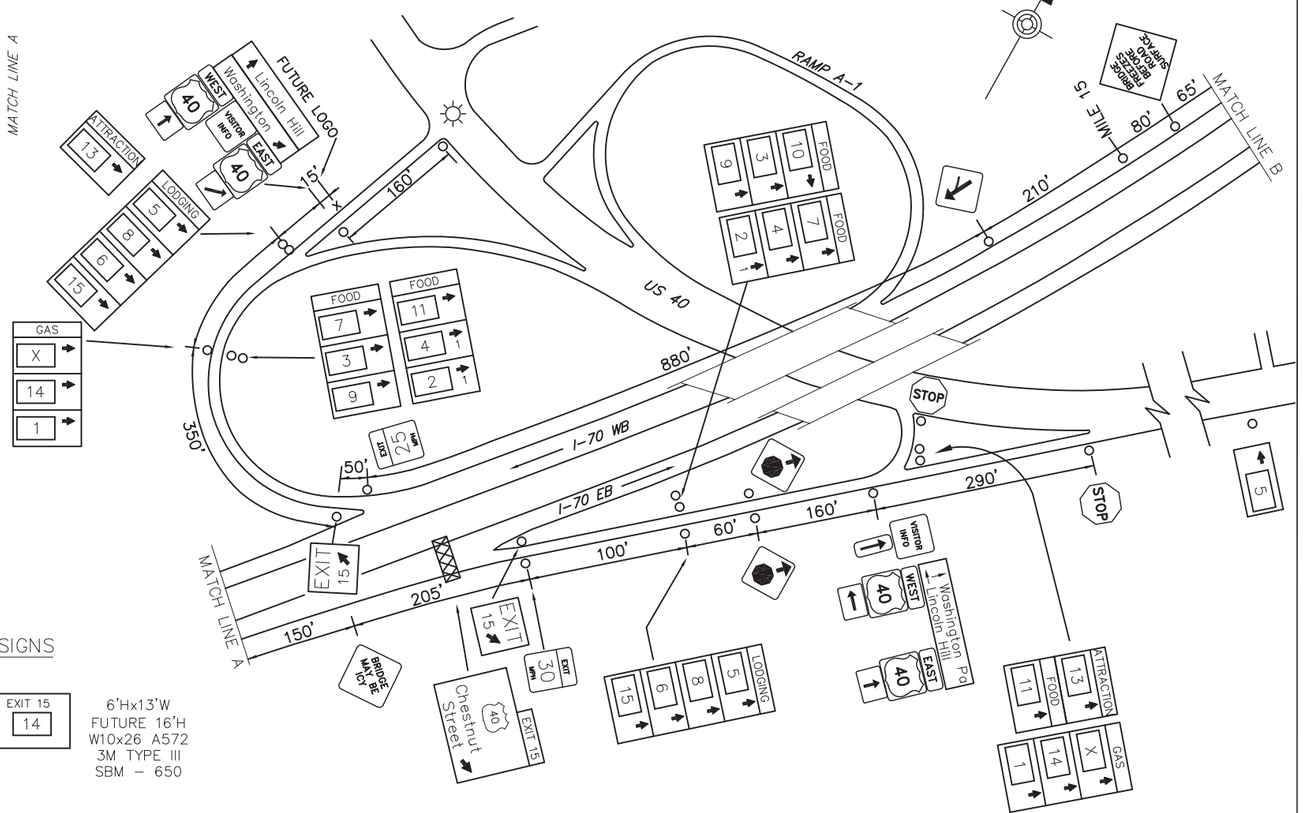

SCHEMATIC PLAN
NOT TO SCALE

LEGEND

2W – GUIDE RAIL

EXIT 15 SPECIFIC INFORMATION PANEL			
LEGEND	DIRECTION	BUSINESS	LOGO NO.
GAS	EB/WB	EXXON (DIESEL)	1
		AMOCO (DIESEL)	14
FOOD	EB/WB	McDONALD'S (24 HRS)	2
		WENDY'S	3
		BOB EVANS RESTAURANT	4
		DUNKIN' DONUTS	7
		BURGER KING	11
	EB	GARFIELD'S RESTAURANT–PUB	10
LODGING	EB/WB	RED ROOF INN	5
		DAYS INN	6
		AMERICA'S BEST VALUE INN & SUITES	8
		MOTEL 6	15
ATTRACTION	EB/WB	WASHINGTON CROWN CENTER	13

EB SIGNS

12'Hx13'W
FUTURE 16'H
W14x30 A572
3M TYPE III
SBM – 650

GAS – EXIT 15: 1 | 14
FOOD – EXIT 15: 11 |

14'Hx13'W
FUTURE 16'H
W10x26
TYPE IV
BACKGROUND
TYPE IX LEGEND
B650 – #1, #1

FOOD – EXIT 15: 3 9 / 4 7 / 2 10

10'Hx13'W
FUTURE 12'H
W6x15 A572
B525 – #2, #2

LODGING – EXIT 15: 5 6 / 8 15

6'Hx13'W
FUTURE 16'H
W14x30 A572
3M TYPE III
SBM – 650

ATTRACTION–EXIT 15: 13 |

WB SIGNS

GAS – EXIT 15: 1 | 14
VISITOR INFO

6'Hx13'W
FUTURE 16'H
W10x26 A572
3M TYPE III
SBM – 650

FOOD – EXIT 15: 3 9 / 7 4 / 11 2

14'Hx13'W
W8x21
TYPE IV
BACKGROUND
TYPE IX LEGEND
B525 – #2, #2

LODGING – EXIT 15: 5 8 / 6 15

ATTRACTION–EXIT 15: 13 |

16'Hx13'W
W14x30 A572
B650 – #2, #1

FREEWAY LANE CLOSURES & RESTRICTIONS ONLY PERMITTED BETWEEN 9:00 PM AND 6:00 AM MONDAY THRU FRIDAY.
WORK ALONG FREEWAY PERMITTED BETWEEN 9:00 AM AND 2:30 PM, UNLESS OTHERWISE APPROVED BY ENGINEERING DISTRICT.
DO NOT WORK DURING HOLIDAY PERIODS.
IF APPLICABLE, REINSTALL GUIDERAIL AT END OF EACH DAY.

INTERSTATE 70

US 40 / CHESTNUT ST

EXIT 15

D:\2015_ADES\215076-01\WK\PSE\AS-BUILT DRAWINGS\PENNDOT DISTRICT 12\WASHINGTON - 68\10-XX SHTXX-170_EXIT 15 PLAN
May/21/2021 11:07 AM