DISTRICT	COUNTY	ROUTE	PROJECT	SHEET
12-0	WESTMORELAND	I-70	XXX-XX	X OF X
ROSTRAVER TOWNSHIP				
REVISIONS				

TABULATION OF QUANTITIES		
ITEM	UNIT	QUANTITY
POST MOUNTED SIGNS, TYPE A, LOGO	SQ.FT.	--
POST MOUNTED SIGNS, TYPE A, LOGO (MODIFIED)	SQ.FT.	--
POST MOUNTED SIGNS, TYPE C, LOGO	SQ.FT.	--
BREAKAWAY SYSTEMS	EACH	--
* STEEL S OR W BEAM POSTS	LBS.	--
LOGO SIGN MOUNTING	EACH	--
LOGO SIGN MOUNTING, RESET	EACH	--
REMOVE POST MOUNTED SIGNS, TYPE A LOGO (MODIFIED)	EACH	--
REMOVE POST MOUNTED SIGNS, TYPE A, LOGO	EACH	--

* APPROXIMATE QUANTITY FOR INFORMATION ONLY

SYMBOLS

- Existing Sign to Remain
- Existing Sign to be Removed
- Existing Sign Reset as Shown
- NEW SIGN
- FUTURE SIGN
- Existing Utility Pole

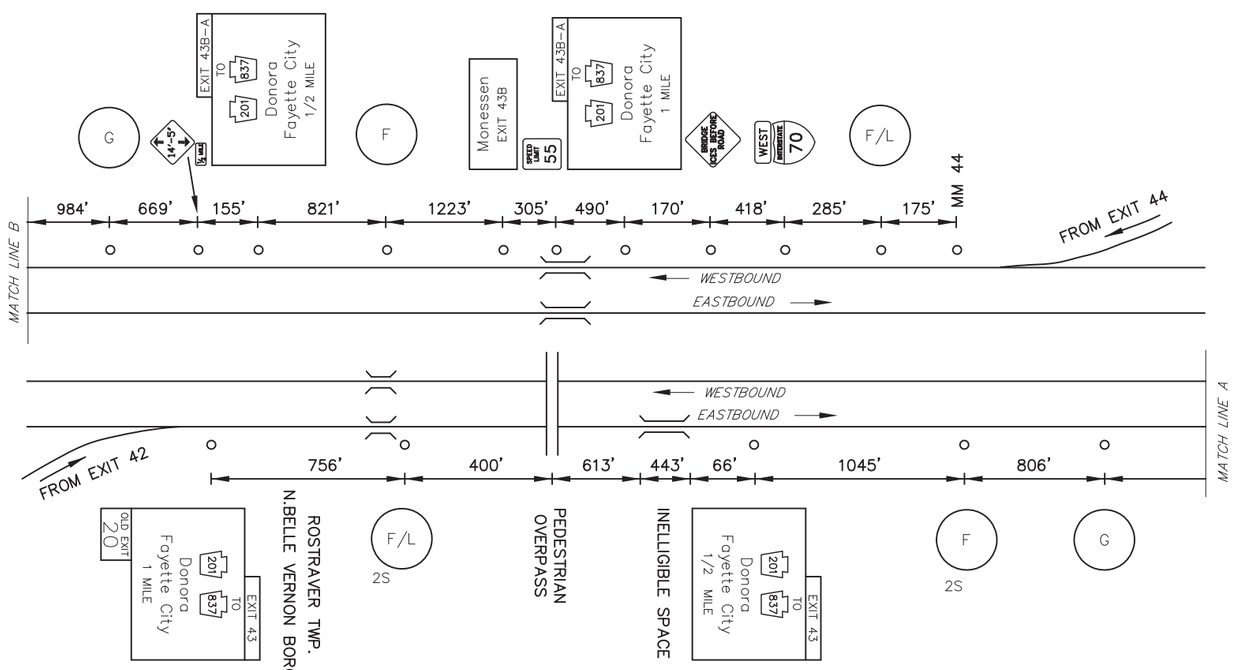

MAINLINE SCHEMATIC
NOT TO SCALE

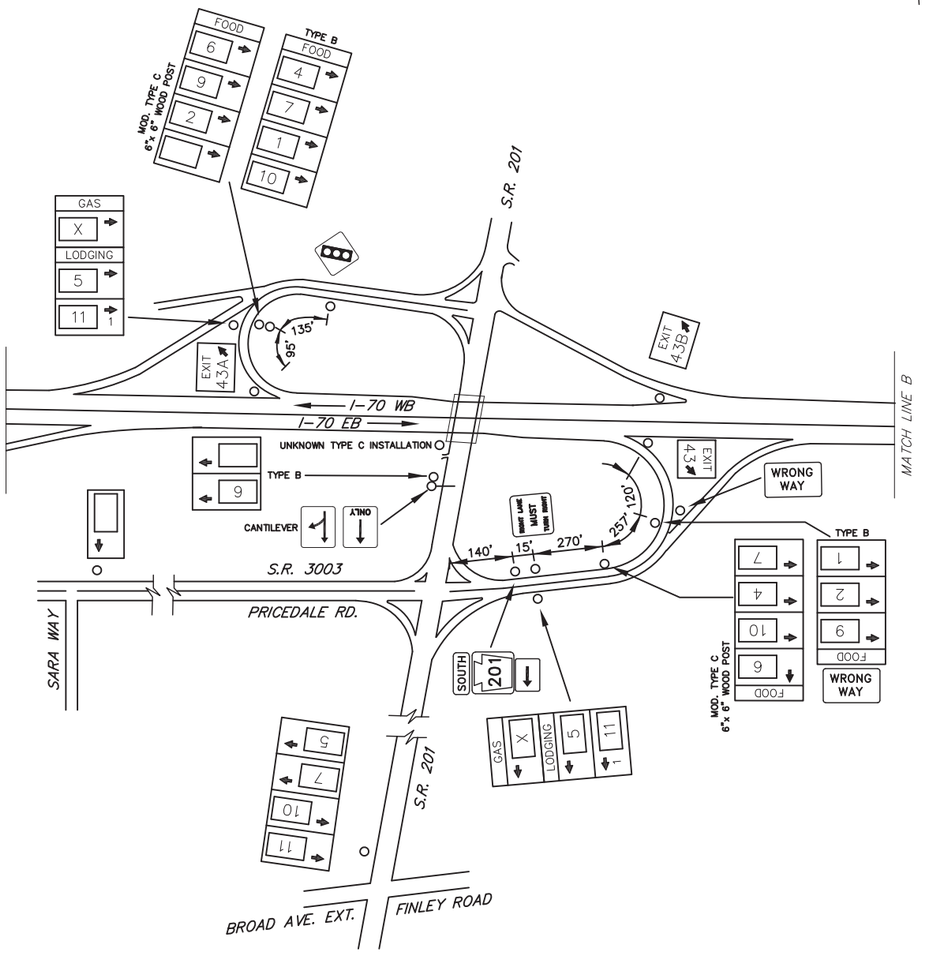

SCHEMATIC PLAN
NOT TO SCALE

LEGEND

2S – GUIDE RAIL

FREEWAY LANE CLOSURES & RESTRICTIONS ONLY PERMITTED BETWEEN 9:00 PM AND 6:00 AM MONDAY THRU FRIDAY. WORK ALONG FREEWAY PERMITTED BETWEEN 9:00 AM AND 2:30 PM, UNLESS OTHERWISE APPROVED BY ENGINEERING DISTRICT. DO NOT WORK DURING HOLIDAY PERIODS. IF APPLICABLE, REINSTALL GUIDERAIL AT END OF EACH DAY.

EXIT 43/43A SPECIFIC INFORMATION PANEL			
LEGEND	DIRECTION	BUSINESS	LOGO NO.
GAS	EB/WB		
FOOD	EB/WB	BURGER KING	1
		DENNY'S	2
		WENDY'S	4
		EAT'N PARK (24-HOUR)	7
		SUBWAY	9
		HOSS'S FAMILY STEAK & SEA	10
		STARBUCKS COFFEE	6
LODGING	EB/WB	HAMPTON INN	5
		HOLIDAY INN EXPRESS & SUITES	11

EB SIGNS

6'Hx13'W
FUTURE 16'H
W10x26 A572
TYPE IV
BACKGROUND
TYPE IX LEGEND
SBM – 650

GAS – EXIT 43
X

14'Hx13'W
W12x26
TYPE IV
BACKGROUND
TYPE IX LEGEND
B650 – #2, #1

FOOD – EXIT 43
6 9
2 4
7 1

12'Hx13'W
14' TOP SECTION
W8x21
3M TYPE IX LEGEND
TYPE III BACKGROUND
B525 – #2, #2

FOOD – EXIT 43
10
LODGING – EXIT 43
5 11

WB SIGNS

GAS – EXIT 43A
X

6'Hx13'W
FUTURE 16'H
W14x30 A572
TYPE IV
BACKGROUND
TYPE IX LEGEND
SBM – 650

FOOD – EXIT 43A
1 2
7
4 9

14'Hx13'W
FUTURE 16'H
W10x22
3M TYPE III
B650 – #1, #2

FOOD – EXIT 43A
6 10
LODGING – EXIT 43A
5 11

12'Hx13'W
FUTURE 15'H
W14x30
3M TYPE IX LEGEND
TYPE III BACKGROUND
B650 – #2, #1

INTERSTATE 70

FAYETTE CITY

EXIT 43/43A

\\DAVIDDC\DATA\PROJECTS\2015_ADB'S\215076-01\WV\PSE\AS-BUILT DRAWINGS\PENNDOT DISTRICT 12\WESTMORELAND - 6410-XX SHTXX-170_EXIT 43 PLAN
May/5/2021 9:59 AM