DISTRICT	COUNTY	ROUTE	PROJECT	SHEET
12-0	WASHINGTON	I-79		
CECIL TOWNSHIP				
REVISIONS				

TABULATION OF QUANTITIES		
ITEM	UNIT	QUANTITY
POST MOUNTED SIGNS, TYPE A, LOGO	S.F.	
POST MOUNTED SIGNS, TYPE B, LOGO	S.F.	
POST MOUNTED SIGNS, TYPE C, LOGO	S.F.	
BREAKAWAY SYSTEMS	EACH	
* STEEL S OR W BEAM POSTS	LBS	
LOGO SIGN MOUNTING	EACH	
REMOVAL OF POST MOUNTED MOTORIST SERVICE SIGNS, TYPES A & E	EACH	
REMOVAL OF POST MOUNTED MOTORIST SERVICE SIGNS, TYPES B, C & F	L.S.	–

* APPROXIMATE QUANTITY FOR INFORMATION ONLY

SYMBOLS

- ○ *Existing Sign to Remain*
- △ *Existing Sign to be Removed*
- □ *Existing Sign Reset as Shown*
- ● NEW SIGN
- × FUTURE SIGN
- Ø *Existing Utility Pole*

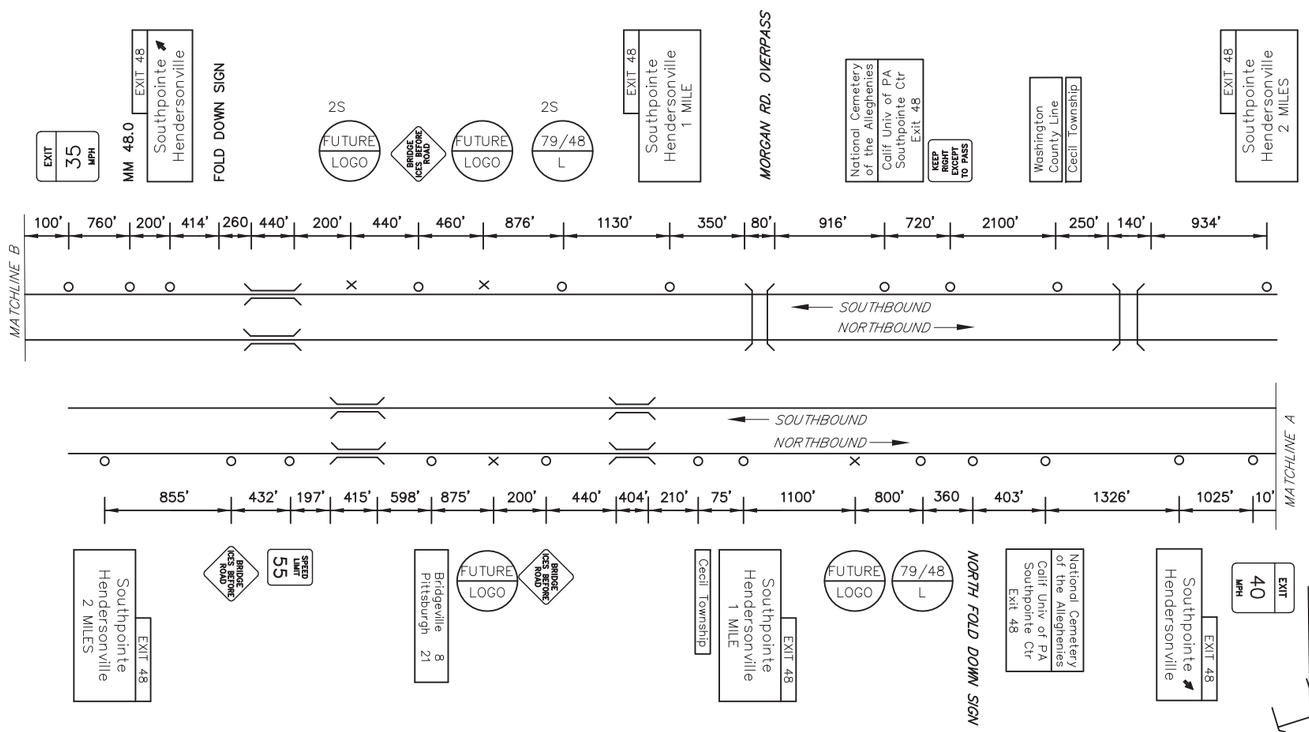

MAINLINE SCHEMATIC
NOT TO SCALE

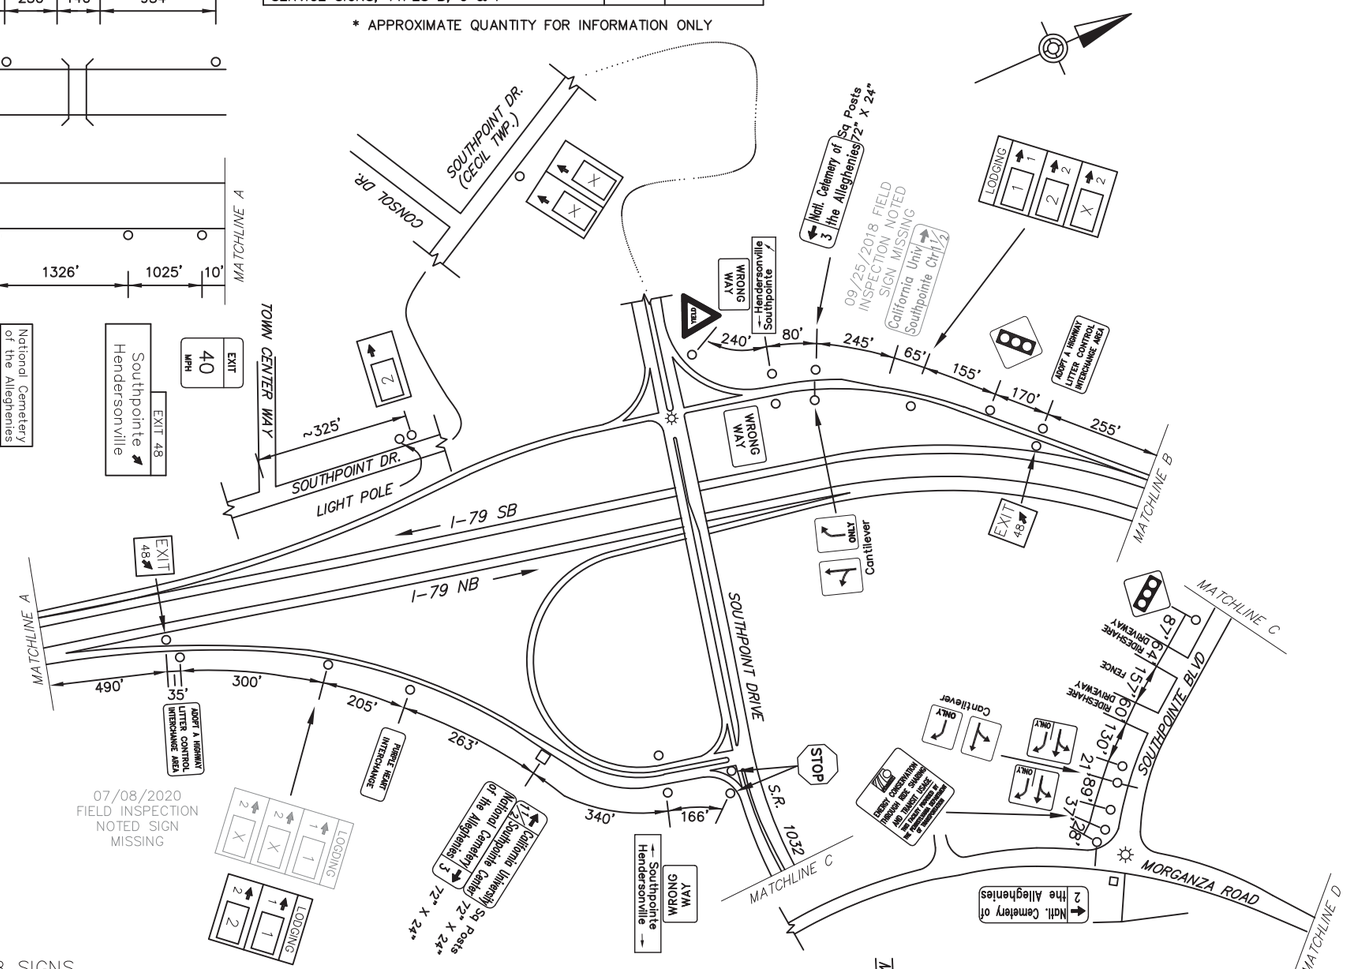

SCHEMATIC PLAN
NOT TO SCALE

EXIT 48 SPECIFIC INFORMATION PANEL			
LEGEND	DIRECTION	BUSINESS	LOGO NO.
LODGING	NB/SB	HILTON GARDEN INN	1
		AC HOTEL – PITTSBURGH	2

NB SIGNS

10'Hx13'W
W14x30
B650 – #2, #2

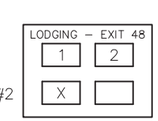

SB SIGNS

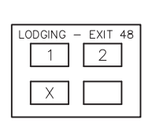

10'Hx13'W
W14x30
B650 – #2, #1

D:\2015JOBS\215276-01\WV\PSE\AS-BUILT DRAWINGS\PENNDOT DISTRICT 12\WASHINGTON - 68\10-XX SHTXX-I79_EXIT 48 PLAN
May/31/2021 11:02 AM