DISTRICT	COUNTY	ROUTE	PROJECT	SHEET
3-0	MONTOUR	I-80		

VALLEY TOWNSHIP

REVISIONS

TABULATION OF QUANTITIES		
ITEM	UNIT	QUANTITY
POST MOUNTED SIGNS, TYPE A, LOGO	SQ.FT.	—
POST MOUNTED SIGNS, TYPE B, LOGO	SQ.FT.	—
POST MOUNTED SIGNS, TYPE C, LOGO	SQ.FT.	—
BREAKAWAY SYSTEMS	EACH	—
* STEEL S OR W BEAM POSTS	LBS.	—
LOGO SIGN MOUNTING	EACH	—
FLAT SHEET PANEL REPLACEMENT	SQ.FT.	
EXTRUDED PANEL REPLACEMENT	SQ.FT.	
REMOVAL OF POST MOUNTED MOTORIST SERVICE SIGNS, TYPES B, C & F	L.S.	—

* APPROXIMATE QUANTITY FOR INFORMATION ONLY

SYMBOLS

- *Existing Sign to Remain*
- *Existing Sign to be Removed*
- *Existing Sign Reset as Shown*
- NEW SIGN
- FUTURE SIGN
- *Existing Utility Pole*

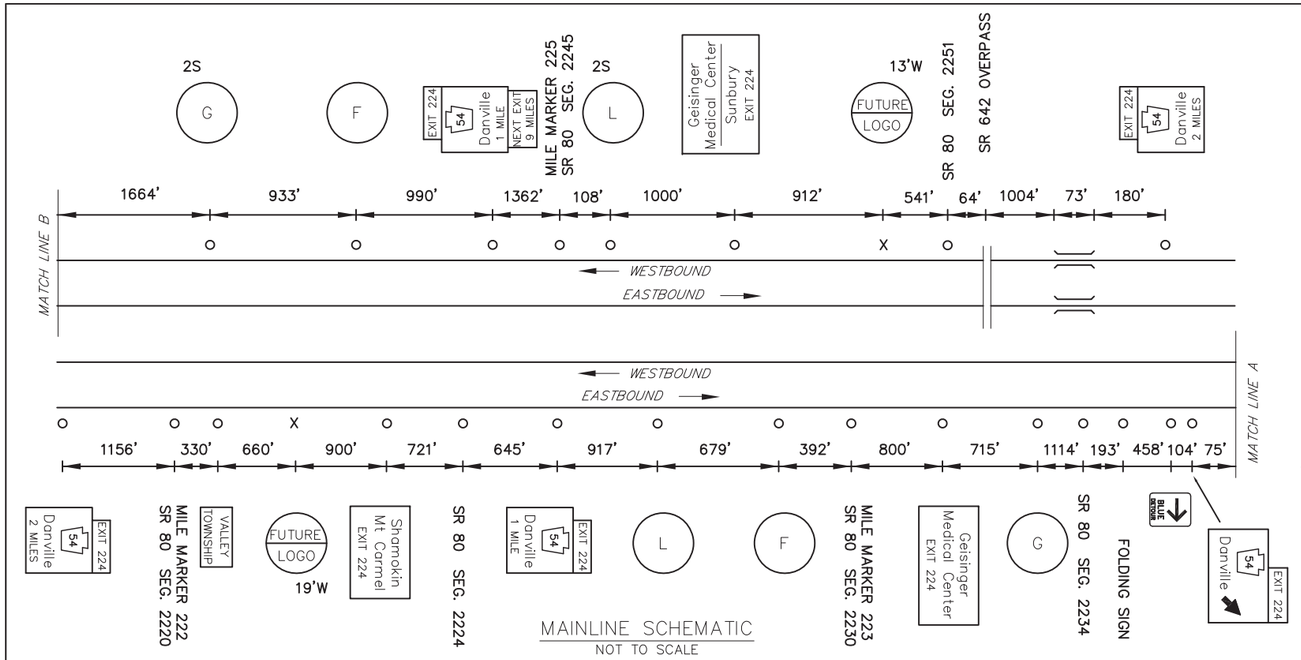

MAINLINE SCHEMATIC

NOT TO SCALE

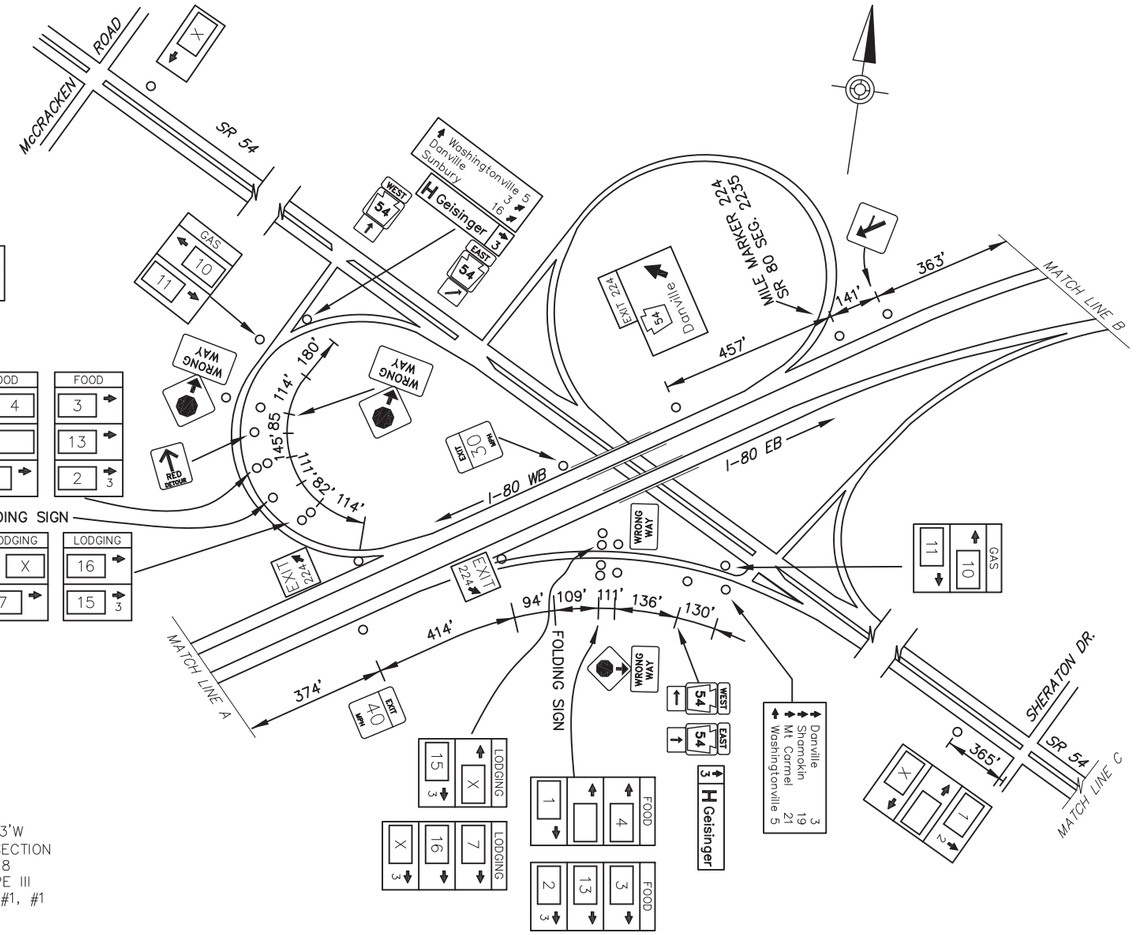

LEGEND

2S – GUIDE RAIL

EXIT 224 SPECIFIC INFORMATION PANEL			
LEGEND	DIRECTION	BUSINESS	LOGO NO.
GAS	EB/WB	EXXON (DIESEL)	10
		MOBIL (DIESEL)	11
FOOD	EB/WB	McDONALD'S	3
		SUBWAY	4
		PERKIN'S RESTAURANT & BAKERY	1
		FRIENDLY'S	13
		TACO BELL	2
LODGING	EB/WB	RED ROOF INN	7
		SUPER 8	16
		PINE BARN INN	15

ONE MILE EXTENSION ALLOWANCE APPLIES AT THIS INTERCHANGE

EB SIGNS

WB SIGNS

10'Hx13'W
FUTURE 12'H
W8x18
3M TYPE III
B525 – #1, #2

GAS – EXIT 224: 10 | 11

GAS – EXIT 224: 10 | 11

10'Hx13'W
12' TOP SECTION
W8x18
3M TYPE III
B525 – #1, #1

10'Hx19'W
W10x26
3M TYPE III
B650 – #1, #2

FOOD – EXIT 224: 3 | 4 | 2 / | 13 | 1

FOOD – EXIT 224: 3 | 13 | 4 / 1 | 2 | X

**
10'Hx19'W
W10x22 A441
3M TYPE III
B650 – #1, #1

10'Hx19'W
W10x26
3M TYPE III
B650 – #2, #2

LODGING – EXIT 224: X | 7 | 16 / X | X | 15

LODGING – EXIT 224: X | X | 7 / 16 | X | 15

**
10'Hx19'W
W8x18 A441
3M TYPE III
B525 – #1, #1

** RESET BY PENNDOT 1994

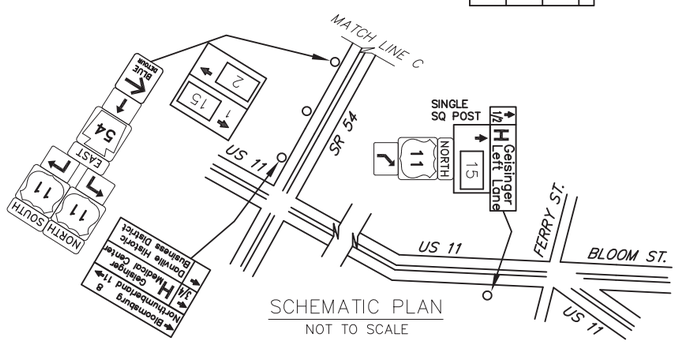

SCHEMATIC PLAN

NOT TO SCALE

INTERSTATE 80

S.R. 54 DANVILLE

EXIT 224

\\DAVID2\CC\DATA\PROJECTS\0015\JOBS\015976-01\HVA\PSE\AS-BUILT DRAWINGS\PENNDOT DISTRICT 03\MONTOUR - 47-18-XX SHTXX-180_EXIT 224 PLAN
May/5/2021 2:42 PM