DISTRICT	COUNTY	ROUTE	PROJECT	SHEET
8-0	CUMBERLAND	I-81		
MIDDLESEX TOWNSHIP				
REVISIONS				

TABULATION OF QUANTITIES		
ITEM	UNIT	QUANTITY
POST MOUNTED SIGNS, TYPE A, LOGO	SQ.FT.	–
POST MOUNTED SIGNS, TYPE A, LOGO (MODIFIED)	SQ.FT.	–
POST MOUNTED SIGNS, TYPE C, LOGO	SQ.FT.	
BREAKAWAY SYSTEMS	EACH	–
* STEEL S OR W BEAM POSTS	LBS.	–
LOGO SIGN MOUNTING	EACH	–
LOGO SIGN MOUNTING, RESET	EACH	–
REMOVAL OF POST MOUNTED MOTORIST SERVICE SIGNS, TYPES A & E	EACH	
REMOVAL OF POST MOUNTED MOTORIST SERVICE SIGNS, TYPES B, C & F	L.S.	

* APPROXIMATE QUANTITY FOR INFORMATION ONLY

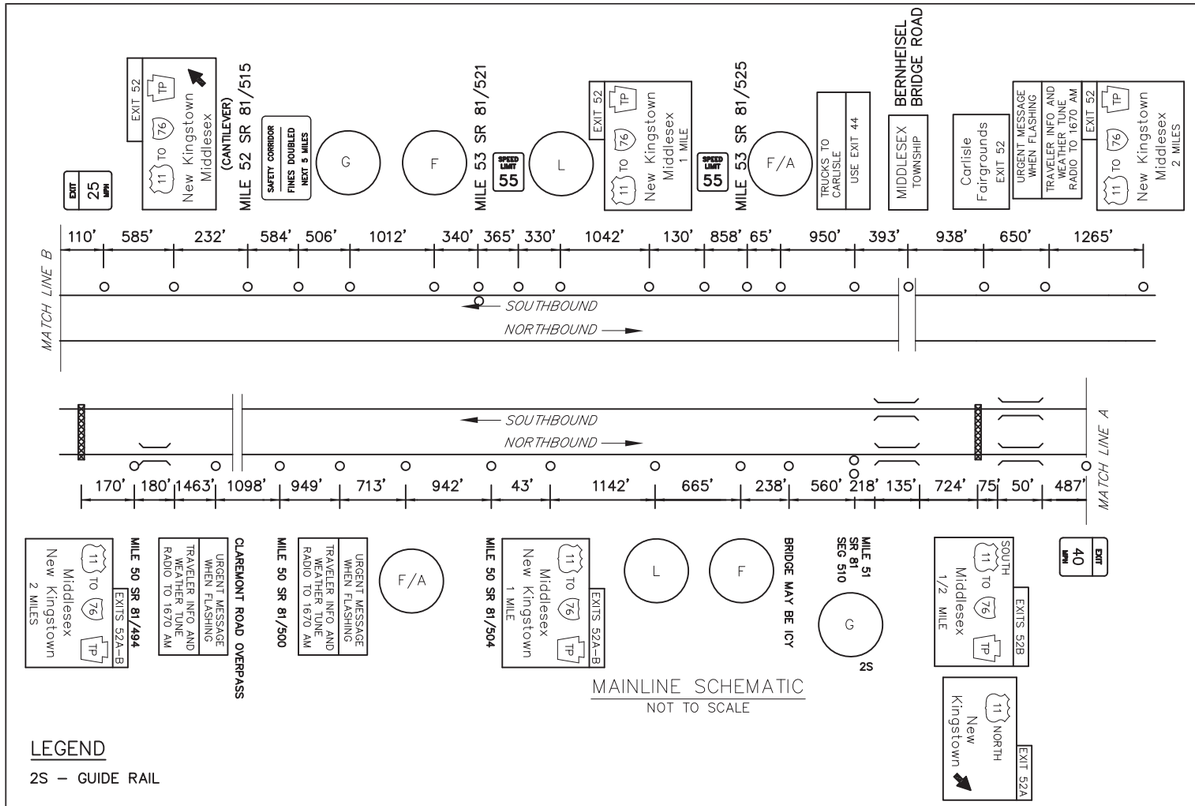

MAINLINE SCHEMATIC
NOT TO SCALE

LEGEND

2S – GUIDE RAIL

FREEWAY LANE CLOSURES & RESTRICTIONS ONLY PERMITTED BETWEEN 9:00 PM AND 6:00 AM MONDAY THRU FRIDAY. WORK ALONG FREEWAY PERMITTED BETWEEN 9:00 AM AND 2:30 PM, UNLESS OTHERWISE APPROVED BY ENGINEERING DISTRICT. DO NOT WORK DURING HOLIDAY PERIODS. IF APPLICABLE, REINSTALL GUIDERAIL AT END OF EACH DAY.

SYMBOLS

- ○ *Existing Sign to Remain*
- △ *Existing Sign to be Removed*
- □ *Existing Sign Reset as Shown*
- ● NEW SIGN
- × FUTURE SIGN
- Ø *Existing Utility Pole*

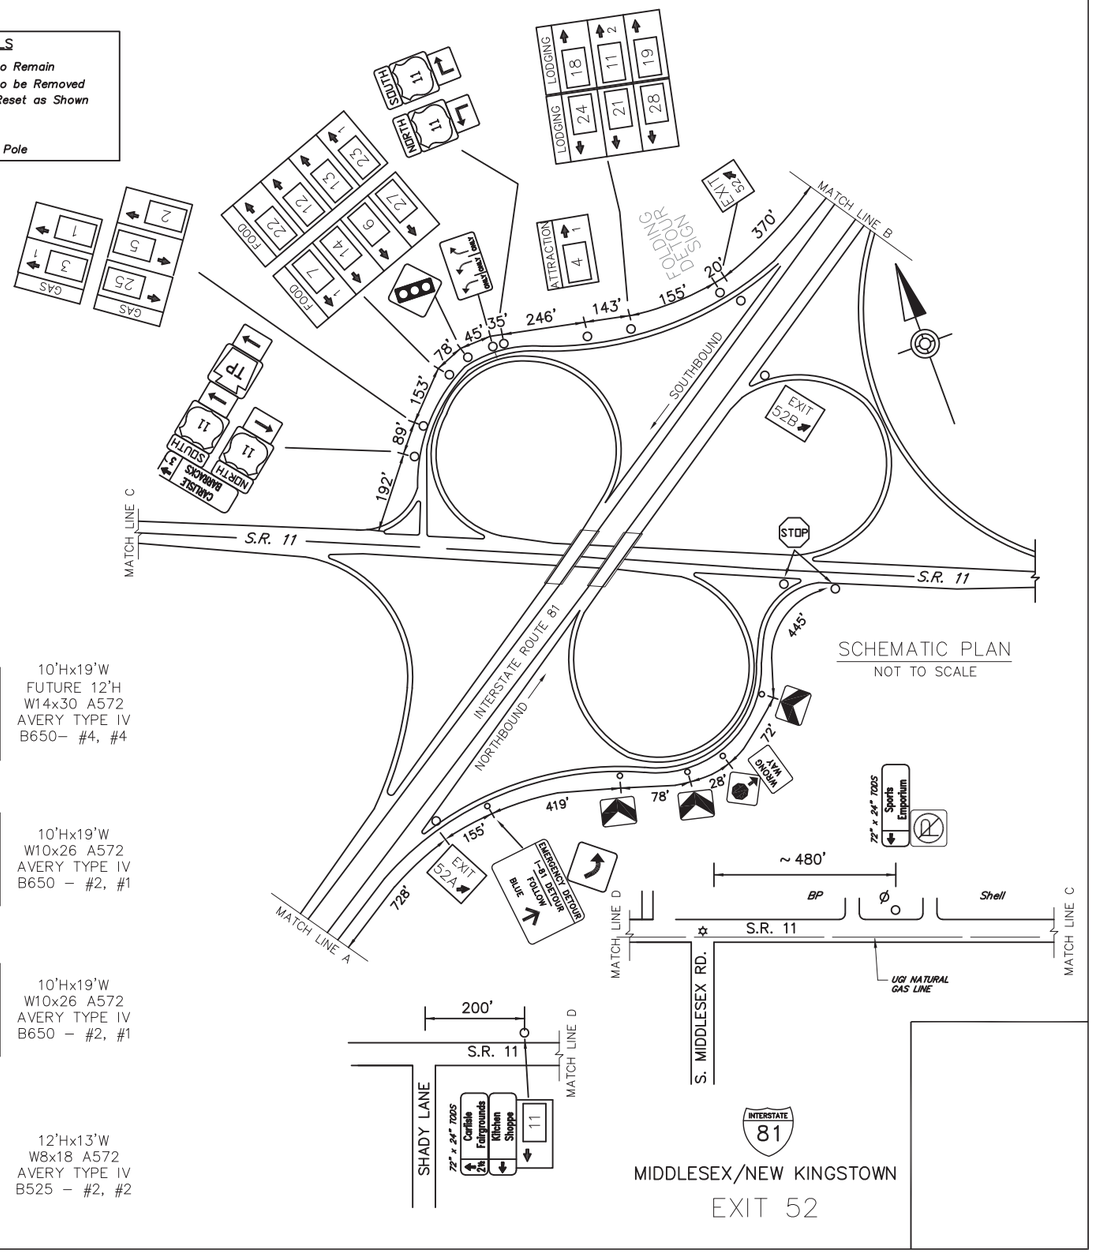

SCHEMATIC PLAN
NOT TO SCALE

MIDDLESEX/NEW KINGSTOWN
EXIT 52

EXIT 52 SPECIFIC INFORMATION PANEL			
LEGEND	DIRECTION	BUSINESS	LOGO NO.
GAS	NB/SB	GULF (DIESEL)	1
		SUNOCO (24HRS/DIESEL)	2
		FLYING J (24 HRS)	5
		LOVE TRAVEL STOPS	3
		SHEETZ (DIESEL)	25
FOOD	NB/SB	DUNKIN'	6
		SUBWAY	13
		DENNY'S	14
		WAFFLE HOUSE (24 HRS)	22
		McDONALD'S	23
		HICKORY RIDGE RESTAURANT	27
	SB	MIDDLESEX DINER (24 HRS)	7
		ARBY'S	12
LODGING	NB/SB	MOTEL 6	28
		DAYS INN – WYNDHAM	18
		ECONO LODGE	19
		RED ROOF	24
		COMFORT INN	11
	SB	SUPER 8	21
ATTRACTION	NB/SB	SPORTS EMPORIUM	4

	NB SIGNS	SB SIGNS	
16'Hx13'W W14x30 A572 STIM. TYPE IV B650 – #1, #1	GAS – EXIT 52A: 25 5 / GAS – EXIT 52B: 2 1 / 3	GAS – EXIT 52: 2 1 5 / 25 3	10'Hx19'W FUTURE 12'H W14x30 A572 AVERY TYPE IV B650– #4, #4
12'Hx19'W FUTURE 16'H W14x30 AVERY TYPE IV B650 – #2, #2	FOOD – EXIT 52A: 27 14 / FOOD – EXIT 52B: 13 22 23	FOOD – EXIT 52: 13 22 6 / 14 12 7	10'Hx19'W W10x26 A572 AVERY TYPE IV B650 – #2, #1
16'Hx13'W W10x26 AVERY TYPE IV B650 – #1, #1	LODGING – EXIT 52A: 28 24 / LODGING – EXIT 52B: 18 19 / 11	LODGING – EXIT 52: 18 19 11 / 24 21 28	10'Hx19'W W10x26 A572 AVERY TYPE IV B650 – #2, #1
12'Hx13'W W8x21 AVERY TYPE IV B525 – #1, #1	FOOD–EXIT 52B: X / ATTRACTION–EXIT 52B: 4	FOOD–EXIT 52: 23 27 / ATTRACTION–EXIT 52: 4	12'Hx13'W W8x18 A572 AVERY TYPE IV B525 – #2, #2

D:\2015_ED\ES\215076-01\WW\PSE\AS-BUILT DRAWINGS\PENNDOT DISTRICT 08\CUMBERLAND - 21\10-XX SHTXX 181_EXIT 52 PLAN
May/21/2021 11:44 AM