DISTRICT	COUNTY	ROUTE	PROJECT	SHEET
8-0	DAUPHIN	I-81		
EAST & WEST HANOVER TOWNSHIPS				
REVISIONS				

TABULATION OF QUANTITIES		
ITEM	UNIT	QUANTITY
POST MOUNTED SIGNS, TYPE A, LOGO	SQ.FT.	
POST MOUNTED SIGNS, TYPE A, LOGO (MODIFIED)	SQ.FT.	
POST MOUNTED SIGNS, TYPE C, LOGO	SQ.FT.	
BREAKAWAY SYSTEMS	EACH	
* STEEL S OR W BEAM POSTS	LBS.	
LOGO SIGN MOUNTING	EACH	
LOGO SIGN MOUNTING, RESET	EACH	
REMOVAL OF POST MOUNTED MOTORIST SERVICE SIGNS, TYPES A & E	EACH	–
REMOVAL OF POST MOUNTED MOTORIST SERVICE SIGNS, TYPES B, C & F	L.S.	

* APPROXIMATE QUANTITY FOR INFORMATION ONLY

SYMBOLS

- ○ *Existing Sign to Remain*
- △ *Existing Sign to be Removed*
- □ *Existing Sign Reset as Shown*
- ● NEW SIGN
- × FUTURE SIGN
- Ø *Existing Utility Pole*

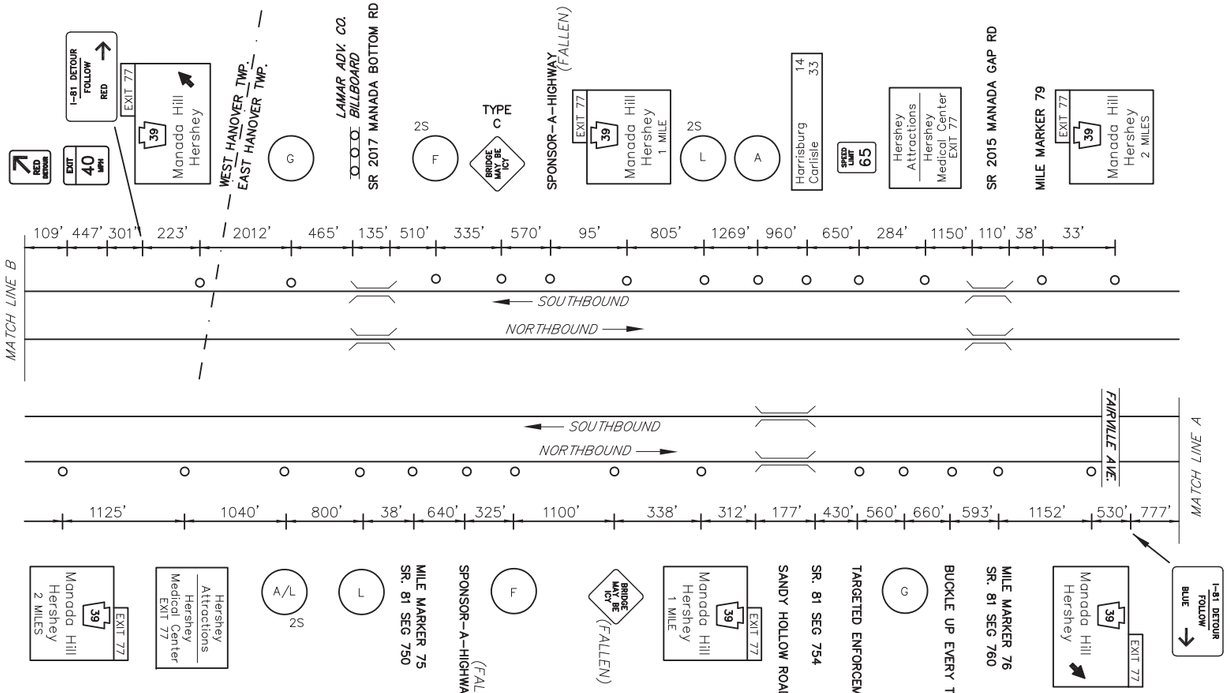

MAINLINE SCHEMATIC
NOT TO SCALE

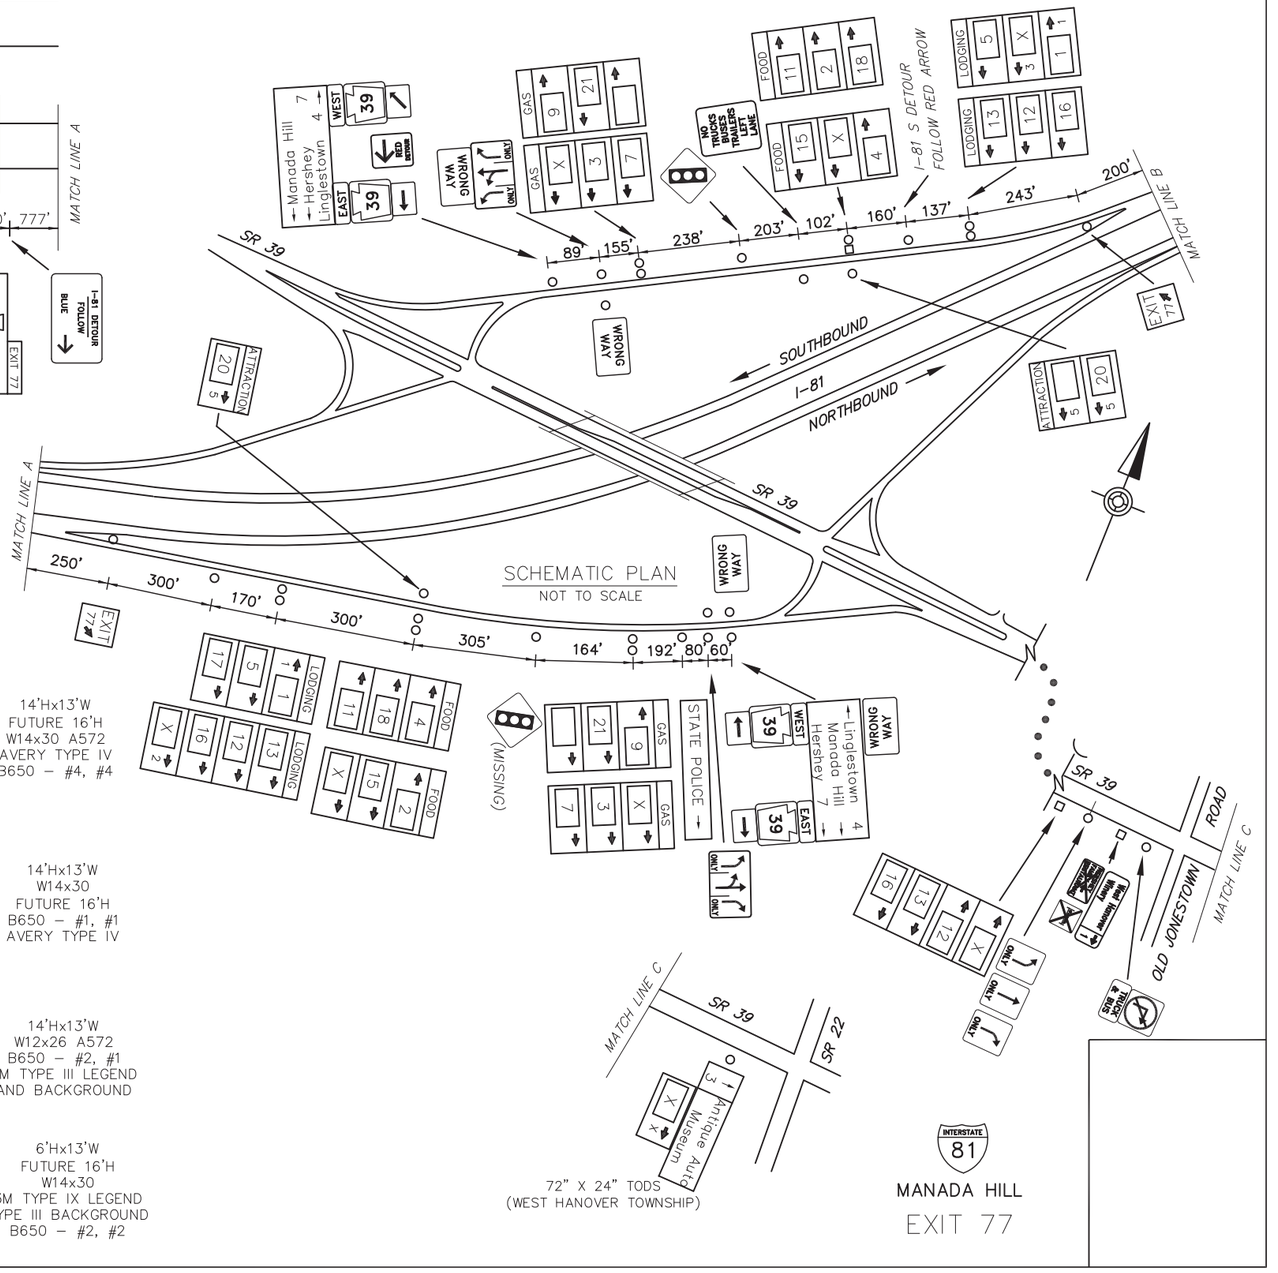

LEGEND

2S – GUIDE RAIL

FREEWAY LANE CLOSURES & RESTRICTIONS ONLY PERMITTED BETWEEN 9:00 PM AND 6:00 AM MONDAY THRU FRIDAY.
WORK ALONG FREEWAY PERMITTED BETWEEN 9:00 AM AND 2:30 PM, UNLESS OTHERWISE APPROVED BY ENGINEERING DISTRICT.
DO NOT WORK DURING HOLIDAY PERIODS.
IF APPLICABLE, REINSTALL GUIDERAIL AT END OF EACH DAY.

EXIT 77 SPECIFIC INFORMATION PANEL			
LEGEND	DIRECTION	BUSINESS	LOGO NO.
GAS	NB/SB	SHEETZ (24 HRS/DIESEL)	21
		PILOT (24 HRS)	7
		FLYING J (24 HRS)	9
FOOD	NB/SB	McDONALD'S	18
		COUNTRY PRIDE RESTAURANT	4
		DUNKIN' DONUTS	2
		PERKIN'S FAMILY RESTAURANT	11
LODGING	NB/SB	LA QUINTA INNS & SUITES	5
		HOLIDAY INN EXPRESS	1
		COUNTRY INN & SUITES	12
		MOTEL 6	13
		SUPER 8	16
	NB	ECONO LODGE	17
ATTRACTION	NB/SB	ANTIQUE AUTO MUSEUM AT HERSHEY	20

NB SIGNS			SB SIGNS		
14'Hx13'W FUTURE 16'H W10x26 A572 AVERY TYPE IV SBM – 650	GAS – EXIT 77 7 21 9		GAS – EXIT 77 9 7 21	14'Hx13'W FUTURE 16'H W14x30 A572 AVERY TYPE IV B650 – #4, #4	
14'Hx13'W W12x26 FUTURE 16'H B650 – #1, #1 3M TYPE III LEGEND AND BACKGROUND	FOOD – EXIT 77 4 2 18 11 X X		FOOD – EXIT 77 18 11 2 4 X	14'Hx13'W W14x30 FUTURE 16'H B650 – #1, #1 AVERY TYPE IV	
14'Hx13'W W12x26 A572 B650 – #2, #2 AVERY TYPE IV	LODGING – EXIT 77 17 16 13 5 12 1		LODGING – EXIT 77 5 1 13 12 16 X	14'Hx13'W W12x26 A572 B650 – #2, #1 3M TYPE III LEGEND AND BACKGROUND	
12'Hx13'W FUTURE 16'H W18x40 3M TYPE IX LEGEND TYPE III BACKGROUND B650 – #2, #1	ATTRACTION–EXIT 77 20 LODGING – EXIT 77 X		ATTRACTION–EXIT 77 20	6'Hx13'W FUTURE 16'H W14x30 3M TYPE IX LEGEND TYPE III BACKGROUND B650 – #2, #2	

\\DAWGIS\CC\DATA\PROJECTS\2015_ADBS\215076-01\MXD\PSE\AS-BUILT DRAWINGS\PENNDOT DISTRICT 08\DAUPHIN - 22\SHTXX-I81_EXIT 77 PLAN
May/6/2021 3:08 PM