DISTRICT	COUNTY	ROUTE	PROJECT	SHEET
8-0	YORK	I-83		

YORK TOWNSHIP
REVISIONS

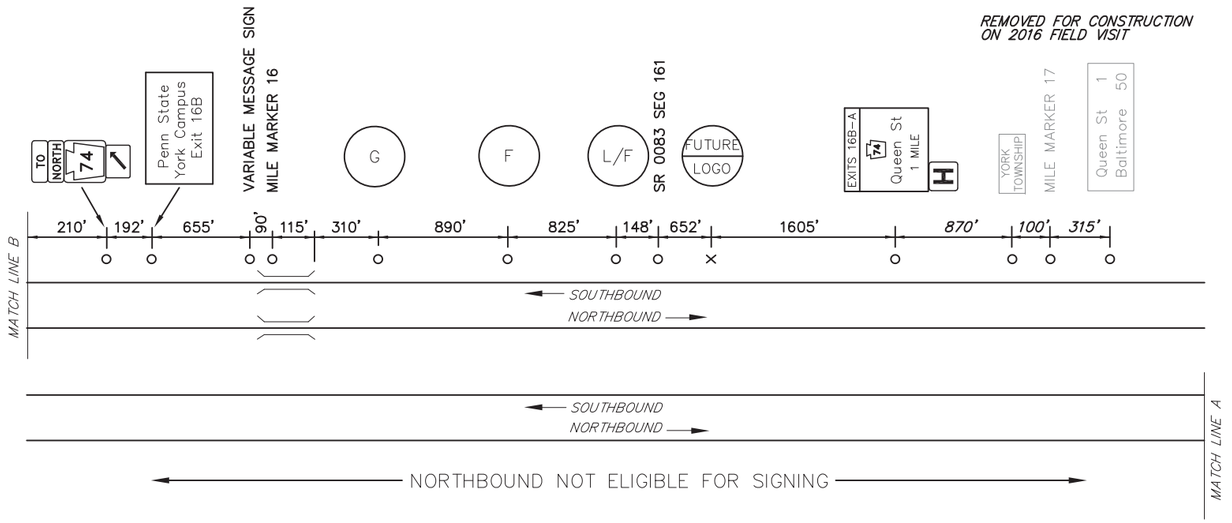

MAINLINE SCHEMATIC
NOT TO SCALE

TABULATION OF QUANTITIES		
ITEM	UNIT	QUANTITY
POST MOUNTED SIGNS, TYPE A, LOGO	SQ.FT.	–
POST MOUNTED SIGNS, TYPE B, LOGO	SQ.FT.	–
POST MOUNTED SIGNS, TYPE C, LOGO	SQ.FT.	–
BREAKAWAY SYSTEMS	EACH	–
* STEEL S OR W BEAM POSTS	LBS.	–
LOGO SIGN MOUNTING	EACH	–
FLAT SHEET PANEL REPLACEMENT	SQ.FT.	
EXTRUDED PANEL REPLACEMENT	SQ.FT.	–
REMOVAL OF POST MOUNTED MOTORIST SERVICE SIGNS, TYPES B, C & F	L.S.	–

* APPROXIMATE QUANTITY FOR INFORMATION ONLY

SYMBOLS

- ○ *Existing Sign to Remain*
- △ *Existing Sign to be Removed*
- □ *Existing Sign Reset as Shown*
- ● NEW SIGN
- × FUTURE SIGN
- Ø *Existing Utility Pole*

FREEWAY LANE CLOSURES & RESTRICTIONS
ONLY PERMITTED BETWEEN 9:00 PM AND
6:00 AM MONDAY THRU FRIDAY.
DO NOT WORK DURING HOLIDAY PERIODS.

EXIT 16 SPECIFIC INFORMATION PANEL			
LEGEND	DIRECTION	BUSINESS	LOGO NO.
GAS	16B SB	SHEETZ (DIESEL)	8
	16A SB	SUNOCO (24 HRS)	3
FOOD	16B SB	McDONALD'S	1
		SUBWAY	4
		TACO BELL	6
		PANERA BREAD	12
	16A SB	MAPLE DONUTS	2
		CRACKER BARREL	7
LODGING	16A SB	COUNTRY INN & SUITES	9
		HAMPTON INN AND SUITES	13
		HOME 2 SUITES HILTON	14

SB SIGNS

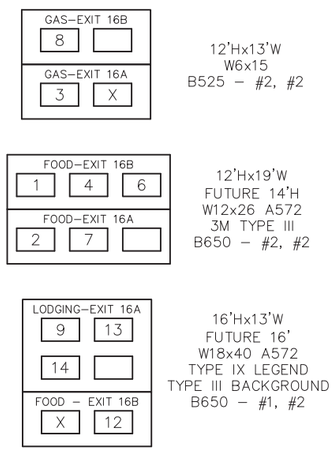

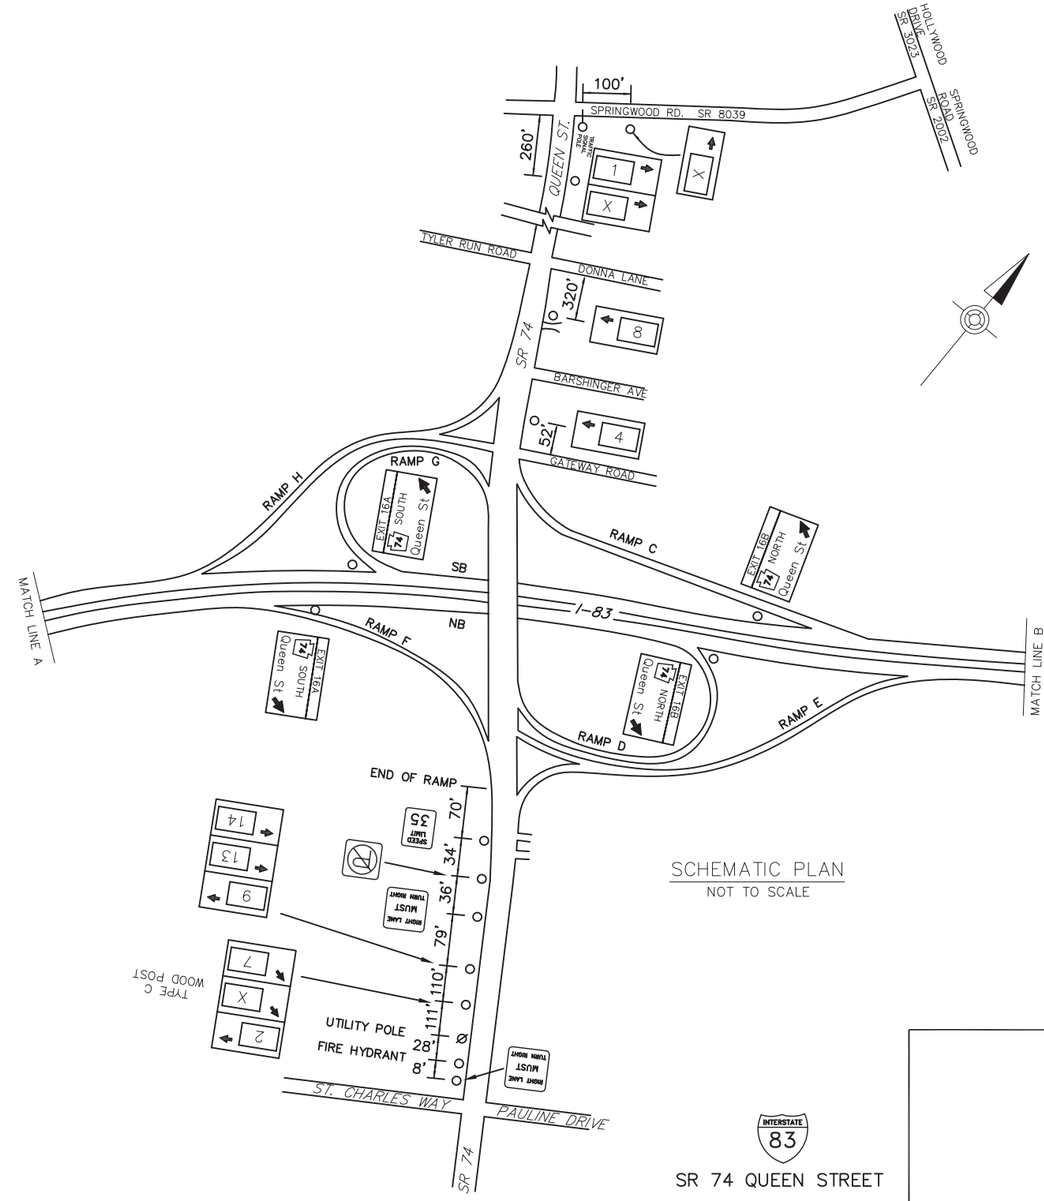

SCHEMATIC PLAN
NOT TO SCALE

INTERSTATE 83

SR 74 QUEEN STREET
EXIT 16

\\DAVIDECC\DATA\PROJECTS\8015\08153215076-16\HV\PSE\AS-BUILT DRAWINGS\PENNDOT DISTRICT 08\YORK - 66\10-XX SHT0X-I83_EXIT 16 PLAN
May/6/2021 3:30 PM