DISTRICT	COUNTY	ROUTE	PROJECT	SHEET
6-0	CHESTER	SR 202		

EAST WHITELAND & TREDYFFRIN TOWNSHIPS

REVISIONS

TABULATION OF QUANTITIES		
ITEM	UNIT	QUANTITY
POST MOUNTED SIGNS, TYPE A, LOGO	SQ.FT.	
POST MOUNTED SIGNS, TYPE B, LOGO	SQ.FT.	
POST MOUNTED SIGNS, TYPE C, LOGO	SQ.FT.	–
BREAKAWAY SYSTEMS	EACH	–
* STEEL S OR W BEAM POSTS	LBS.	
LOGO SIGN MOUNTING	EACH	
REMOVAL OF POST MOUNTED MOTORIST SERVICE SIGNS, TYPES A & E	EACH	–
REMOVAL OF POST MOUNTED MOTORIST SERVICE SIGNS, TYPES B, C & F	L.S.	–

* APPROXIMATE QUANTITY FOR INFORMATION ONLY

SYMBOLS

- ○ *Existing Sign to Remain*
- △ *Existing Sign to be Removed*
- □ *Existing Sign Reset as Shown*
- ● NEW SIGN
- × FUTURE SIGN
- Ø *Existing Utility Pole*

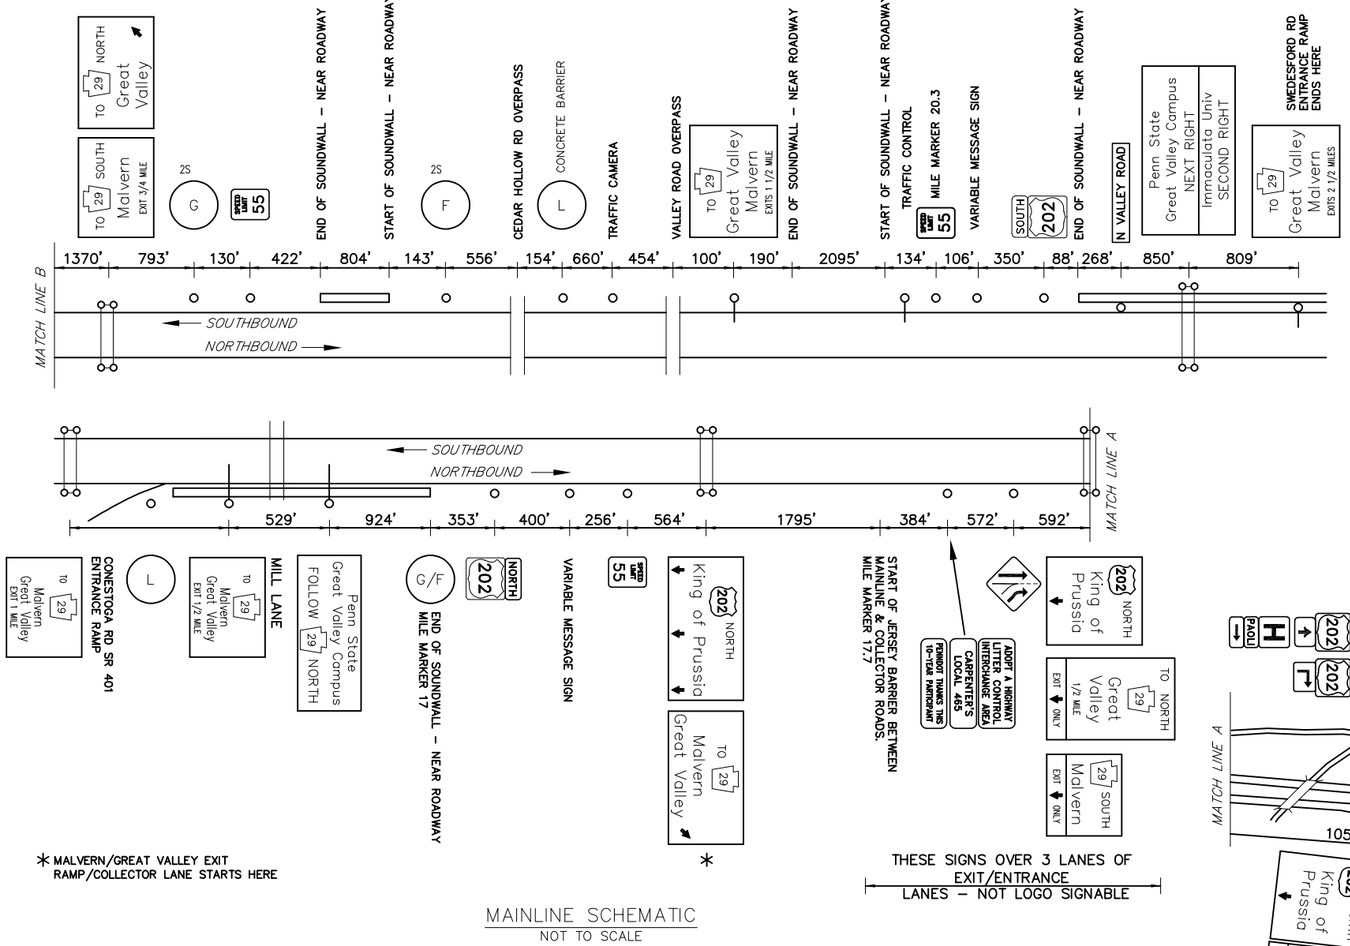

* MALVERN/GREAT VALLEY EXIT RAMP/COLLECTOR LANE STARTS HERE

THESE SIGNS OVER 3 LANES OF EXIT/ENTRANCE LANES – NOT LOGO SIGNABLE

MAINLINE SCHEMATIC
NOT TO SCALE

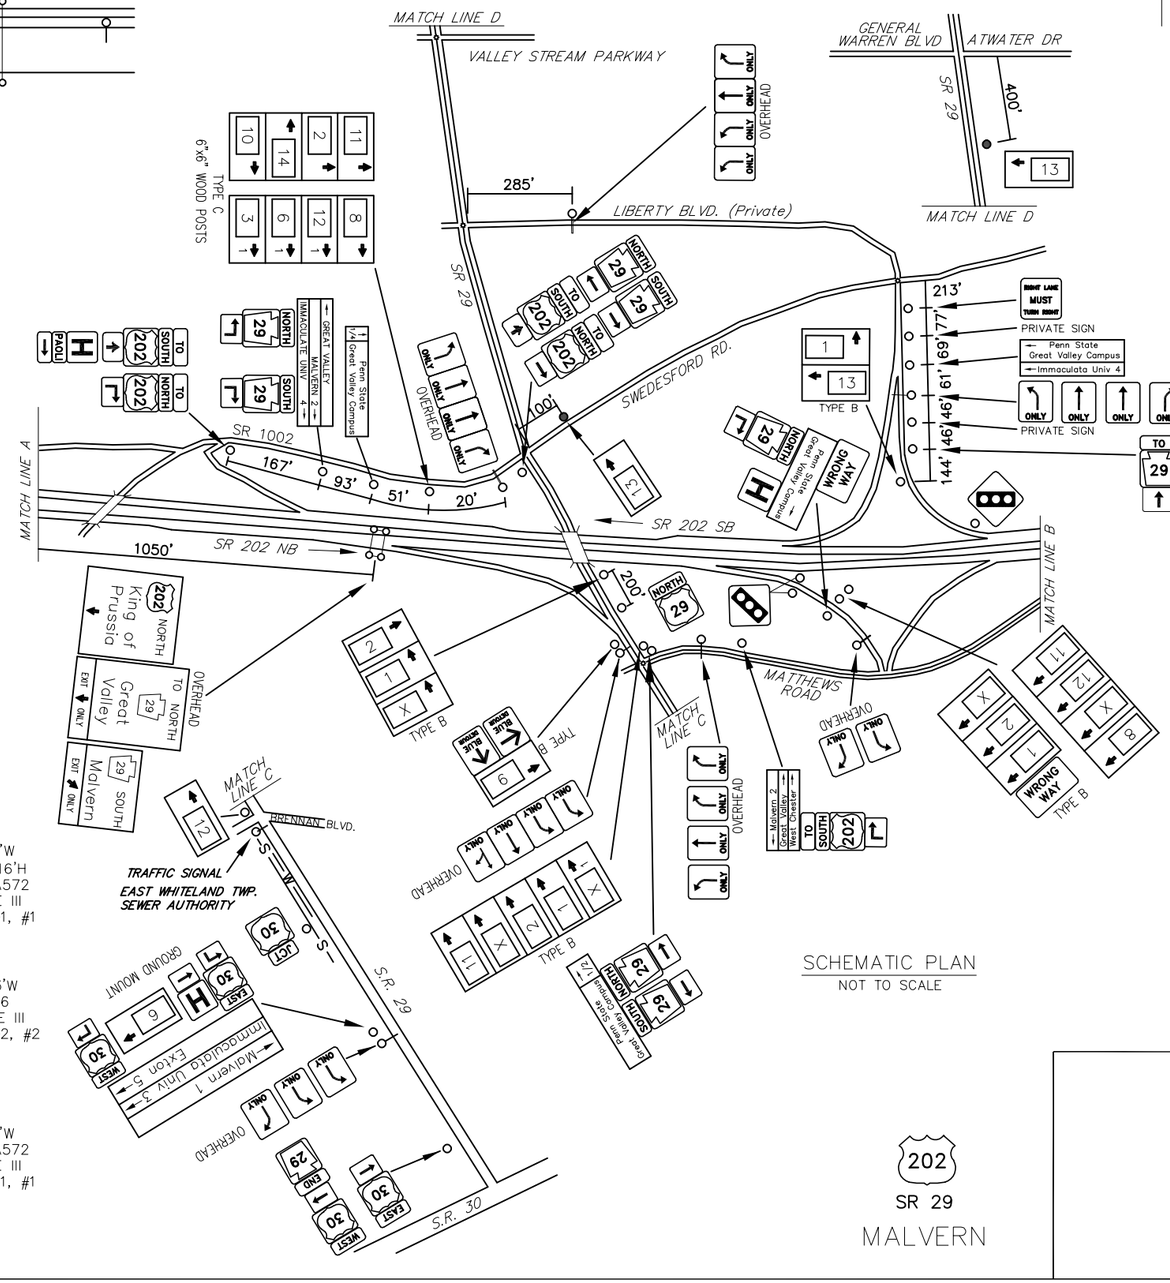

SCHEMATIC PLAN
NOT TO SCALE

LEGEND

2S – GUIDE RAIL

MALVERN EXIT SPECIFIC INFORMATION PANEL			
LEGEND	DIRECTION	BUSINESS	LOGO NO.
GAS	NB/SB	WAWA (DIESEL)	8
FOOD	NB/SB	FRIENDLY'S	6
		WEGMANS MARKET CAFE	10
	SB	PANERA BREAD	12
		CHIK-FIL-A (CLOSED SUNDAY)	14
LODGING	NB/SB	THE DESMOND	1
		HOMEWOOD SUITES – HILTON	2
		HOLIDAY INN EXPRESS	3
		EXTENDED STAY AMERICA	11
	SB	RESIDENCE INN	13

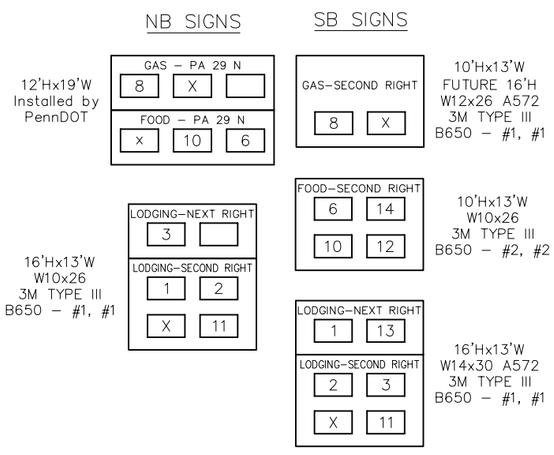

202
SR 29
MALVERN

\\DAVOSD1\CC\DATA\PROJECTS\0015\0385\215076-01\MKV\PSE\AS-BUILT DRAWINGS\PENNDOT DISTRICT 06\CHESTER - 15\01-XX_SHTXX US202_MALVERN PLAN
January/18/2022 11:40 AM