DISTRICT	COUNTY	ROUTE	PROJECT	SHEET
8-0	YORK	US-30		

SPRINGETTSBURY & HELLAM TOWNSHIPS

REVISIONS

TABULATION OF QUANTITIES		
ITEM	UNIT	QUANTITY
POST MOUNTED SIGNS, TYPE A, LOGO	SQ.FT.	–
POST MOUNTED SIGNS, TYPE B, LOGO	SQ.FT.	–
POST MOUNTED SIGNS, TYPE C, LOGO	SQ.FT.	–
BREAKAWAY SYSTEMS	EACH	–
* STEEL S OR W BEAM POSTS	LBS.	–
LOGO SIGN MOUNTING	EACH	–
REMOVAL OF POST MOUNTED MOTORIST SERVICE SIGNS, TYPES A & E	EACH	–
REMOVAL OF POST MOUNTED MOTORIST SERVICE SIGNS, TYPES B, C & F	L.S.	

* APPROXIMATE QUANTITY FOR INFORMATION ONLY

SYMBOLS

- ○ *Existing Sign to Remain*
- △ *Existing Sign to be Removed*
- □ *Existing Sign Reset as Shown*
- ● NEW SIGN
- × FUTURE SIGN
- Ø *Existing Utility Pole*

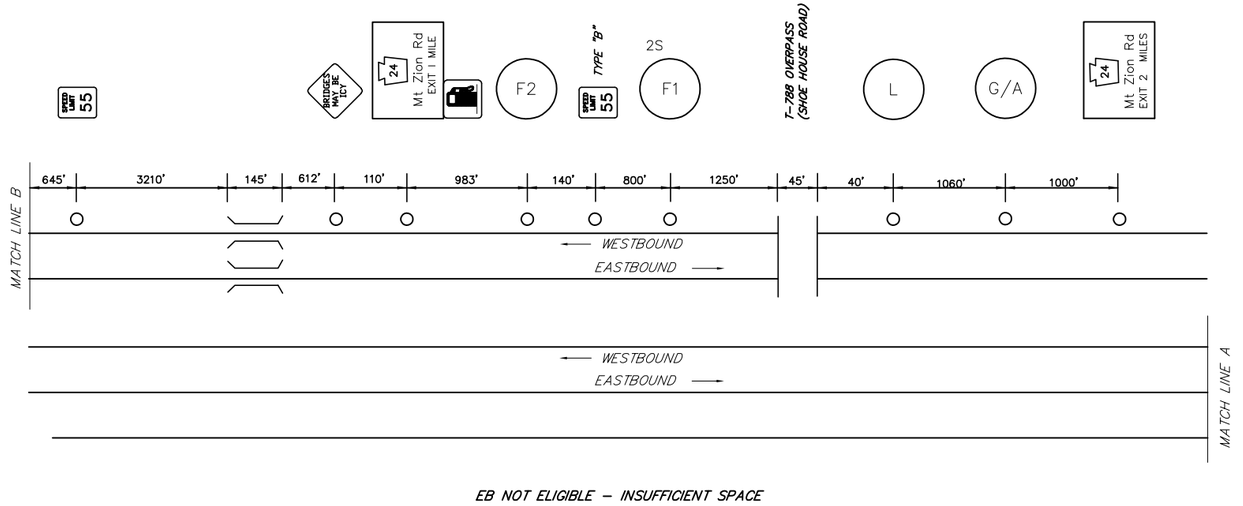

EB NOT ELIGIBLE – INSUFFICIENT SPACE

MAINLINE SCHEMATIC
NOT TO SCALE

LEGEND

2S – GUIDE RAIL

FREEWAY LANE CLOSURES & RESTRICTIONS
ONLY PERMITTED BETWEEN 9:00 PM AND
6:00 AM MONDAY THRU FRIDAY.
DO NOT WORK DURING HOLIDAY PERIODS.

MT ZION ROAD SPECIFIC INFORMATION PANEL			
LEGEND	DIRECTION	BUSINESS	LOGO NO.
GAS	WB	RUTTER'S (24 HRS)	9
FOOD	WB	ISAAC'S GRILLED SANDWICHES	2
		RED ROBIN GOURMET BURGERS	3
		HOSS'S FAMILY STEAK & SEA	4
		APPLEBEE'S	5
		PANERA BREAD	7
		MAPLE DONUTS	8
		CHICK-FIL-A (CLOSED SUNDAY)	11
		BURGER KING	12
LODGING	WB	HAMPTON INN	6
		COURTYARD BY MARRIOTT	10
ATTRACTION	WB	YORK GALLERIA	1

WB SIGNS

F2
6'Hx19'W
FUTURE 12'H
W10x26 A572
3M TYPE IV
SBM-650-#1, #1

F1
10'Hx19'W
W8x21 A572
3M TYPE III
B525 – NOT STAMPED

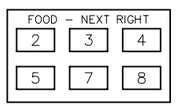

6'Hx19'W
FUTURE 10'H
W8x21 A572
3M TYPE III
B525 – #1, #1

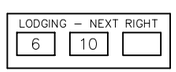

12'Hx19'W
W14x30 A572
3M TYPE III
B650 – #2, #2

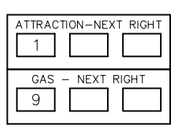

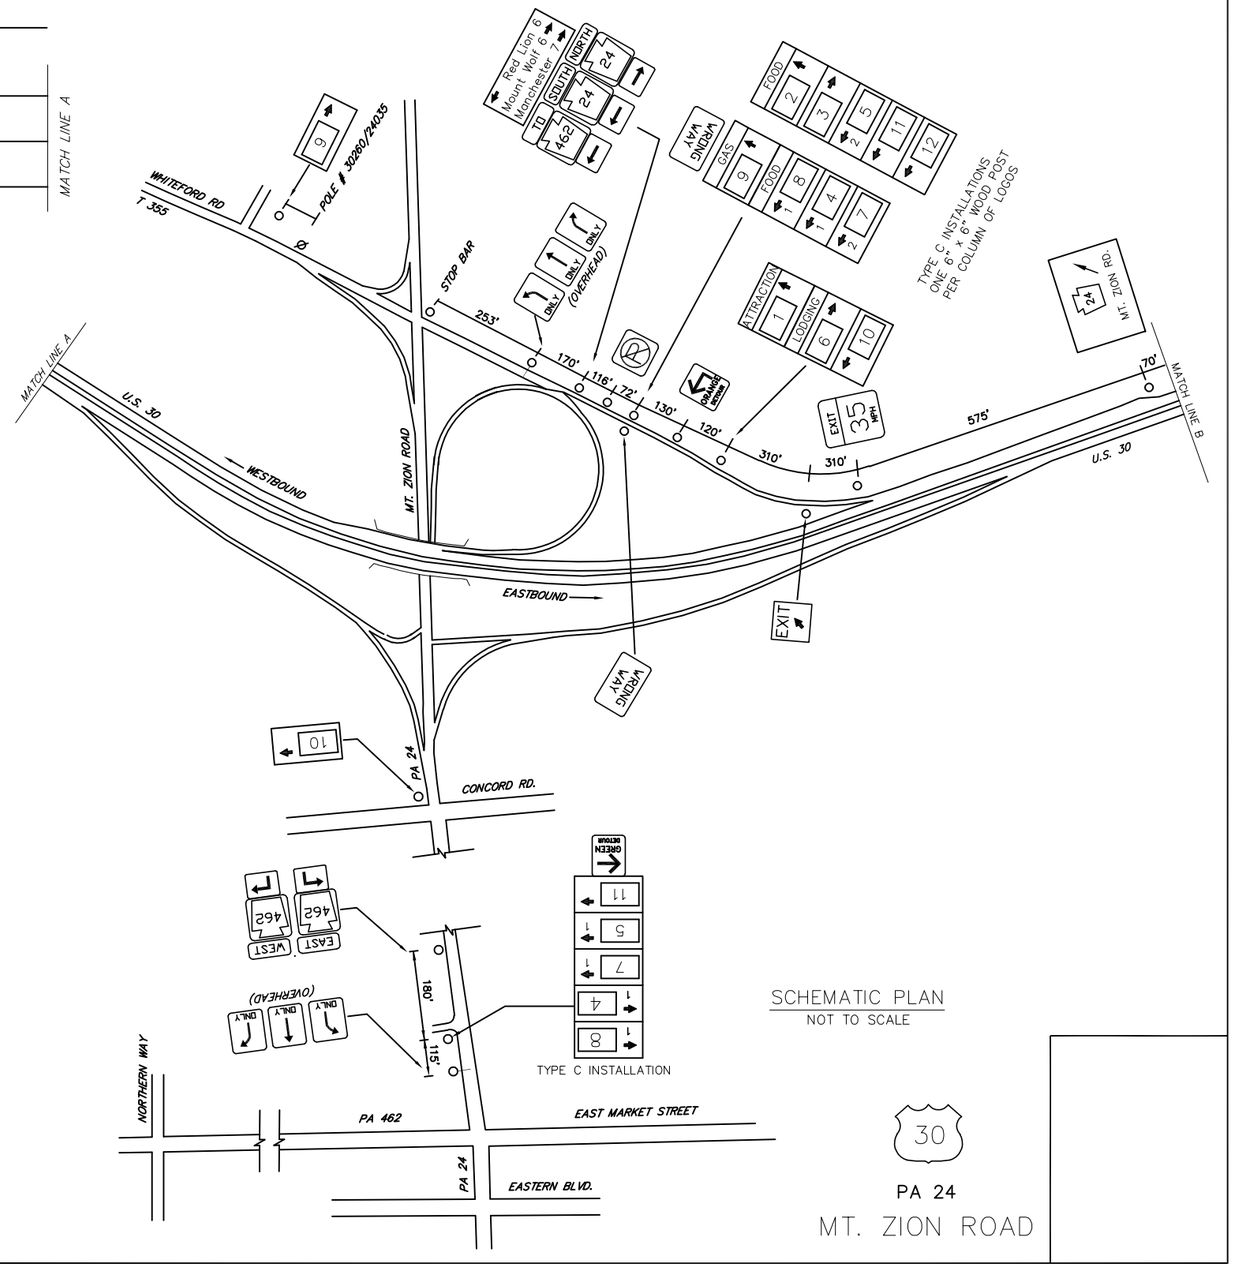

SCHEMATIC PLAN
NOT TO SCALE

30
PA 24
MT. ZION ROAD

\\DAVIDDJC\DATA\PROJECTS\2015\8B15\215976-01\HV\PSE\AS-BUILT DRAWINGS\PENNDOT DISTRICT 08\YORK - 6X10-XX SHTXX-US30_MT ZION PLAN
January/18/2022 4:09 PM