DISTRICT	COUNTY	ROUTE	PROJECT	SHEET
5-0	MONROE	I-380		
	COOLBAUGH TOWNSHIP			
4-0	LACKAWANNA			
	CLIFTON TOWNSHIP			
	REVISIONS			

TABULATION OF QUANTITIES		
ITEM	UNIT	QUANTITY
POST MOUNTED SIGNS, TYPE A, LOGO	SQ.FT.	
POST MOUNTED SIGNS, TYPE B, LOGO	SQ.FT.	
POST MOUNTED SIGNS, TYPE C, LOGO	SQ.FT.	——
BREAKAWAY SYSTEMS	EACH	
* STEEL S OR W BEAM POSTS	LBS.	
LOGO SIGN MOUNTING	EACH	
REMOVAL OF POST MOUNTED MOTORIST SERVICE SIGNS, TYPES A & E	EACH	
REMOVAL OF POST MOUNTED MOTORIST SERVICE SIGNS, TYPES B, C & F	L.S.	——

* APPROXIMATE QUANTITY FOR INFORMATION ONLY

SYMBOLS

- ○ *Existing Sign to Remain*
- △ *Existing Sign to be Removed*
- □ *Existing Sign Reset as Shown*
- ● NEW SIGN
- × FUTURE SIGN
- Ø *Existing Utility Pole*

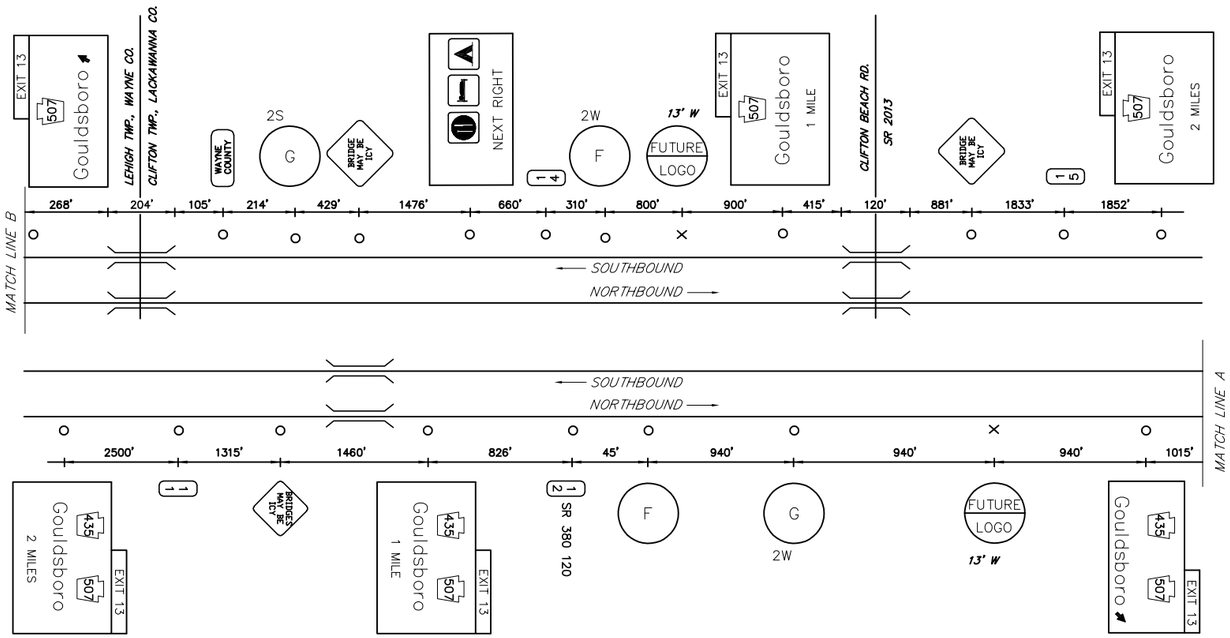

MAINLINE SCHEMATIC
NOT TO SCALE

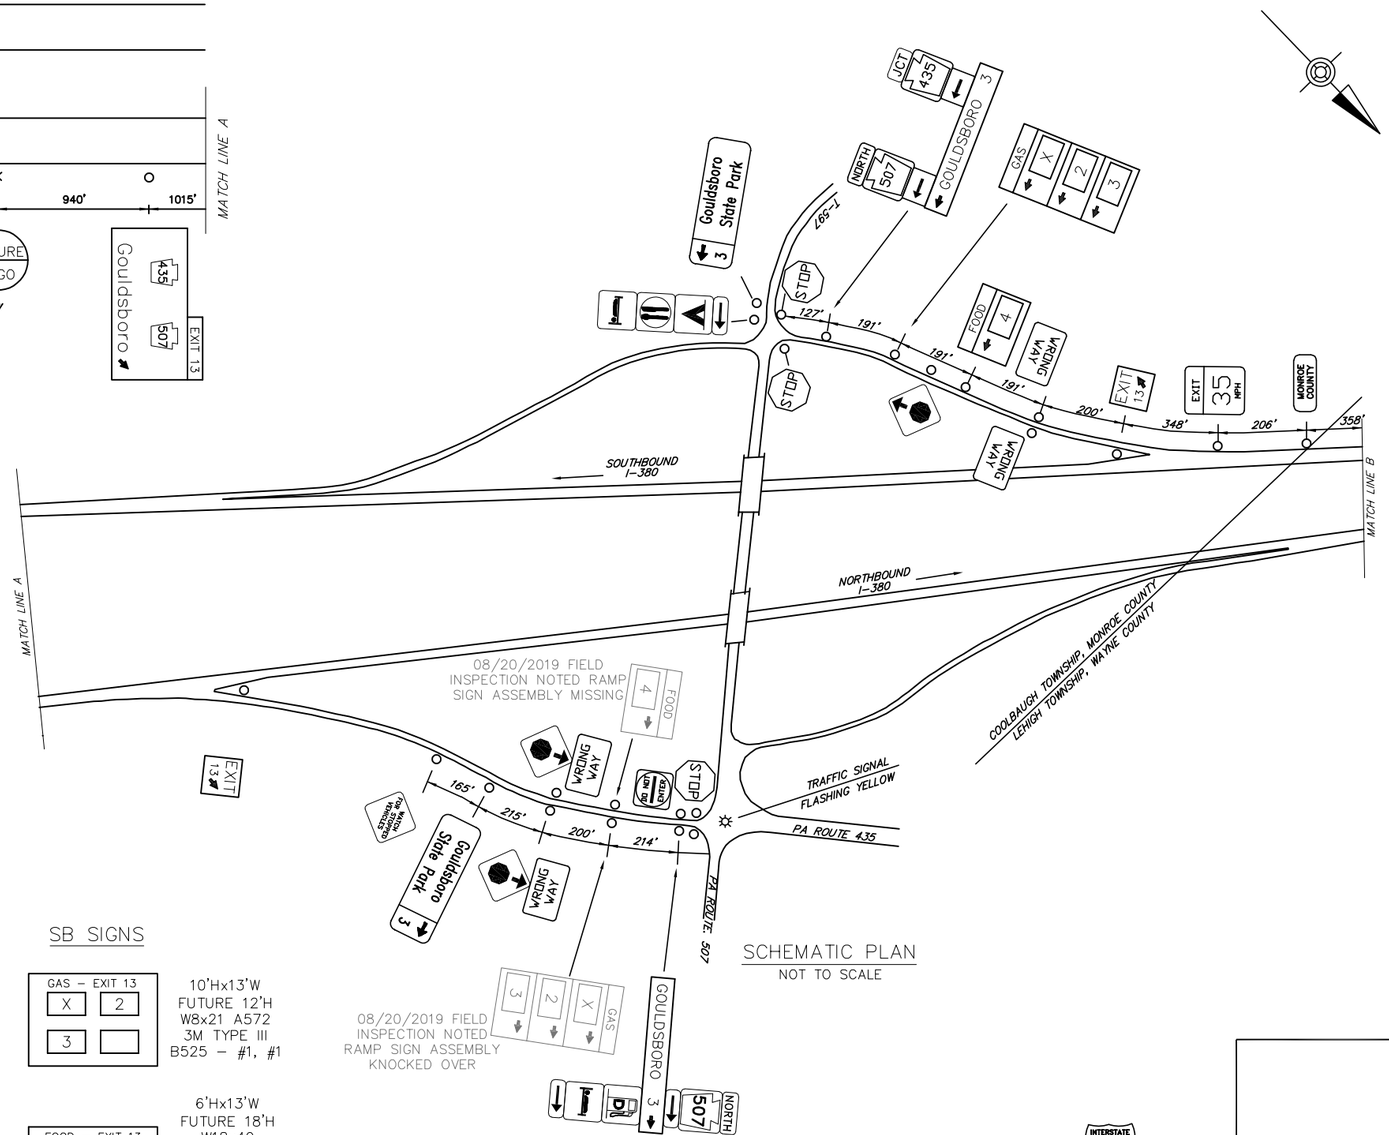

SCHEMATIC PLAN
NOT TO SCALE

LEGEND

2S/2W – GUIDE RAIL

EXIT 13 SPECIFIC INFORMATION PANEL			
LEGEND	DIRECTION	BUSINESS	LOGO NO.
GAS	NB/SB		
		EXXON (24 HRS/DIESEL)	2
		GOULDSBORO TRAVEL PLAZA	3
FOOD	NB/SB	BURGER KING	4

NB SIGNS

10'Hx13'W
FUTURE 16'H
W18x40
TYPE IX LEGEND
TYPE III
BACKGROUND
B650 – #2, #2

GAS – EXIT 13: X | 2 / 3

6'Hx13'W
W6x12 A572
TYPE IX LEGEND
TYPE III
BACKGROUND
B525 – #2, #2

FOOD – EXIT 13: 4

SB SIGNS

GAS – EXIT 13: X | 2 / 3

10'Hx13'W
FUTURE 12'H
W8x21 A572
3M TYPE III
B525 – #1, #1

FOOD – EXIT 13: 4

6'Hx13'W
FUTURE 18'H
W18x40
TYPE IX LEGEND
TYPE III
BACKGROUND
B650 – #2, #1

INTERSTATE 380
GOULDSBORO
EXIT 13

\\DAV2DJCC\DATA\PROJECTS\2015\D3E5\D25076-01\WK\PSE\AS-BUILT DRAWINGS\PENNDOT DISTRICT 05\MONROE - 45\10-XX SHTXX-I380_EXIT 13 PLAN
January/19/2022 2:33 PM