DISTRICT	COUNTY	ROUTE	PROJECT	SHEET
5-0	BERKS	U.S. 422		

BORO OF WEST READING & BORO OF WYOMISSING

REVISIONS

TABULATION OF QUANTITIES		
ITEM	UNIT	QUANTITY
POST MOUNTED SIGNS, TYPE A, LOGO	SQ.FT.	
POST MOUNTED SIGNS, TYPE B, LOGO	SQ.FT.	
POST MOUNTED SIGNS, TYPE C, LOGO	SQ.FT.	
BREAKAWAY SYSTEMS	EACH	
* STEEL S OR W BEAM POSTS	LBS.	
LOGO SIGN MOUNTING	EACH	
REMOVAL OF POST MOUNTED MOTORIST SERVICE SIGNS, TYPES A & E	EACH	
REMOVAL OF POST MOUNTED MOTORIST SERVICE SIGNS, TYPES B, C & F	L.S.	

* APPROXIMATE QUANTITY FOR INFORMATION ONLY

SYMBOLS

- ○ *Existing Sign to Remain*
- △ *Existing Sign to be Removed*
- □ *Existing Sign Reset as Shown*
- ● NEW SIGN
- × FUTURE SIGN
- Ø *Existing Utility Pole*

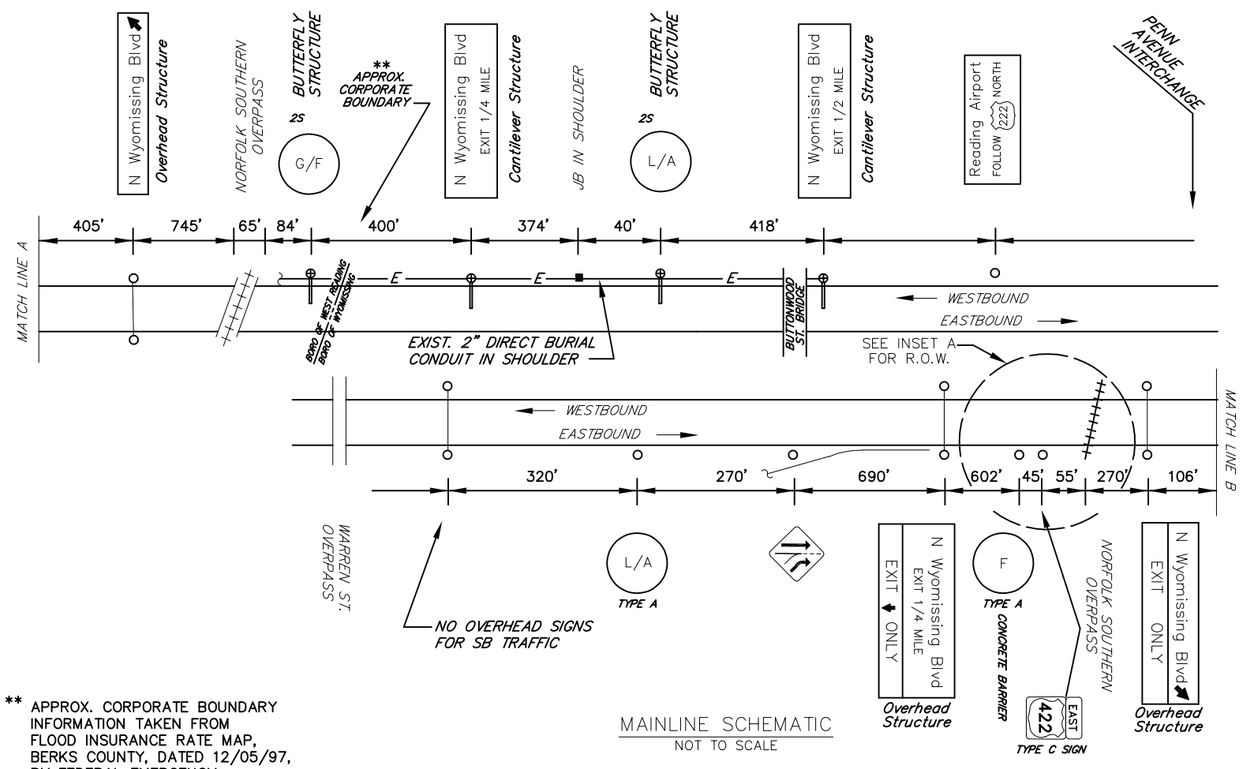

MAINLINE SCHEMATIC
NOT TO SCALE

** APPROX. CORPORATE BOUNDARY INFORMATION TAKEN FROM FLOOD INSURANCE RATE MAP, BERKS COUNTY, DATED 12/05/97, BY FEDERAL EMERGENCY MANAGEMENT AGENCY

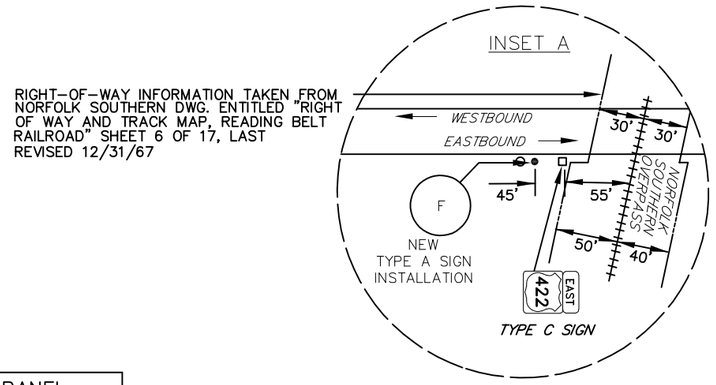

RIGHT-OF-WAY INFORMATION TAKEN FROM NORFOLK SOUTHERN DWG. ENTITLED "RIGHT OF WAY AND TRACK MAP, READING BELT RAILROAD" SHEET 6 OF 17, LAST REVISED 12/31/67

NOTE:

NO LANE RESTRICTIONS PERMITTED MONDAY THRU FRIDAY BETWEEN 6:00 AM TO 9:00 AM AND 3:00 PM TO 6:00 PM.

N WYOMISSING BLVD SPECIFIC INFORMATION PANEL			
LEGEND	DIRECTION	BUSINESS	LOGO NO.
GAS	WB		
FOOD	EB/WB		
LODGING	EB/WB	HOLIDAY IN & SUITES	7
ATTRACTION	EB/WB		

EB SIGN

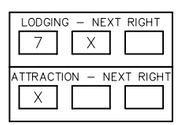

12'Hx19'W
W12x26 A572
3M TYPE III
B650 – #2, #2

WB SIGN

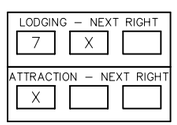

12'Hx19'W
CENTER MOUNTED
SIGN STRUCTURE
3M TYPE III

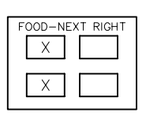

10'Hx13'W
FUTURE 16'H
W14x30 A572
3M TYPE III
B650 – #2, #2

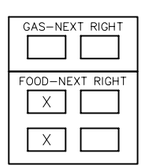

16'Hx13'W
CENTER MOUNTED
SIGN STRUCTURE
3M TYPE III

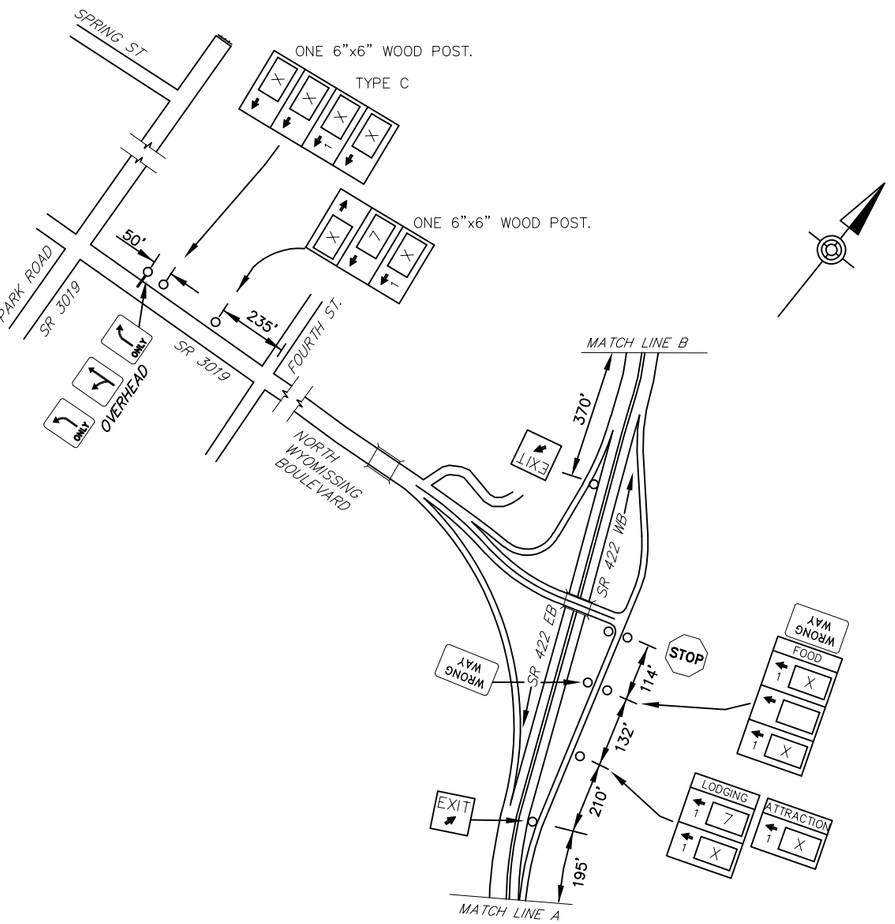

SCHEMATIC PLAN
NOT TO SCALE

422

S.R. 3019

N. WYOMISSING BLVD

\\DAVDDFC\DATA\PROJECTS\2015.0285\2150174-01\HV\PSE\AS-BUILT DRAWINGS\PENNDOT DISTRICT 05\BERKS - 06\10-XX SHTXX-422_EXIT HYDM PLAN
January/19/2022 12:50 PM