DISTRICT	COUNTY	ROUTE	PROJECT	SHEET
12-0	WASHINGTON	I-70	XXX-XX	X OF X
DONEGAL & BUFFALO TOWNSHIPS				
REVISIONS				

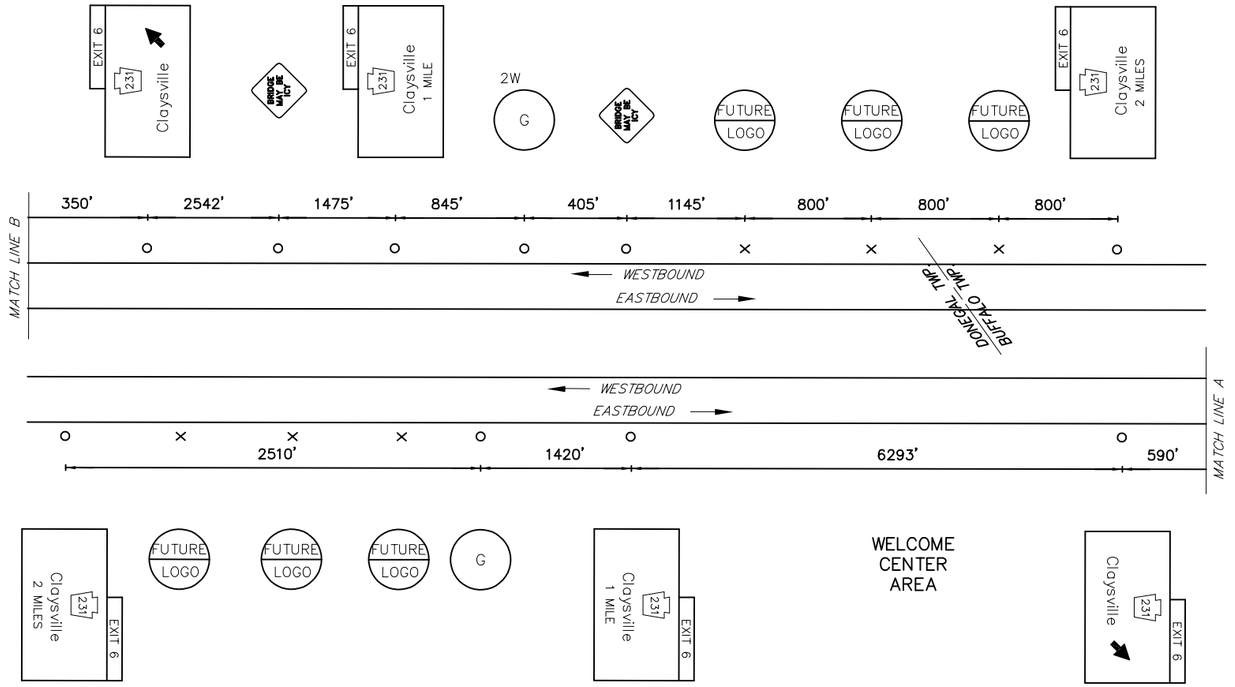

MAINLINE SCHEMATIC
NOT TO SCALE

TABULATION OF QUANTITIES		
ITEM	UNIT	QUANTITY
POST MOUNTED SIGNS, TYPE A, LOGO	SQ.FT.	--
POST MOUNTED SIGNS, TYPE A, LOGO (MODIFIED)	SQ.FT.	--
POST MOUNTED SIGNS, TYPE C, LOGO	SQ.FT.	--
BREAKAWAY SYSTEMS	EACH	--
* STEEL S OR W BEAM POSTS	LBS.	--
LOGO SIGN MOUNTING	EACH	--
LOGO SIGN MOUNTING, RESET	EACH	--
REMOVE POST MOUNTED SIGNS, TYPE A LOGO (MODIFIED)	EACH	--
REMOVE POST MOUNTED SIGNS, TYPE E SERVICE SIGNS, TYPES B, C & F	EACH	--

* APPROXIMATE QUANTITY FOR INFORMATION ONLY

SYMBOLS

- ○ *Existing Sign to Remain*
- △ *Existing Sign to be Removed*
- □ *Existing Sign Reset as Shown*
- ● NEW SIGN
- × FUTURE SIGN
- Ø *Existing Utility Pole*

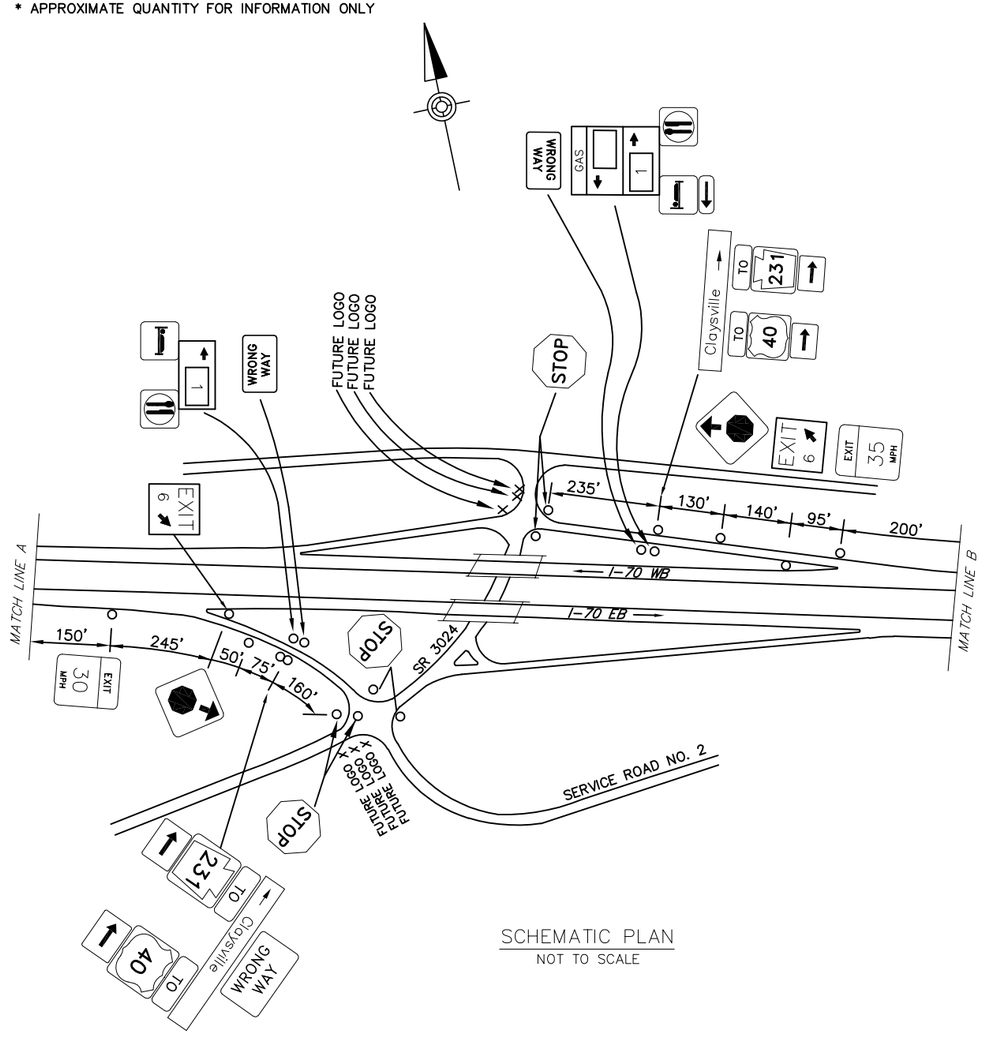

SCHEMATIC PLAN
NOT TO SCALE

LEGEND

2W – GUIDE RAIL

FREEWAY LANE CLOSURES & RESTRICTIONS ONLY PERMITTED BETWEEN 9:00 PM AND 6:00 AM MONDAY THRU FRIDAY.
WORK ALONG FREEWAY PERMITTED BETWEEN 9:00 AM AND 2:30 PM, UNLESS OTHERWISE APPROVED BY ENGINEERING DISTRICT.
DO NOT WORK DURING HOLIDAY PERIODS.
IF APPLICABLE, REINSTALL GUIDERAIL AT END OF EACH DAY.

EB SIGNS

6'Hx13'W
FUTURE 16'H
W10x26 A572
TYPE IV
BACKGROUND
TYPE IX LEGEND
SBM – 650

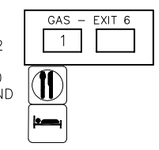

WB SIGNS

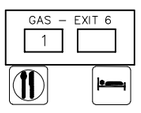

6'Hx13'W
FUTURE 16'H
W10x26 A572
TYPE IV
BACKGROUND
TYPE IX LEGEND
SBM – 650

EXIT 6 SPECIFIC INFORMATION PANEL			
LEGEND	DIRECTION	BUSINESS	LOGO NO.
GAS	EB/WB	AMOCO (DIESEL)	1

INTERSTATE 70
CLAYSVILLE
EXIT 6

\\DMWDDC01\DATA\PROJECTS\2015\085\A05976-01\MVP\PSE\AS-BUILT DRAWINGS\PENNDOT DISTRICT 12\WASHINGTON - 62\10-XX SHTXX-170_EXIT 6 PLAN
January/17/2022 1:12 PM