DISTRICT	COUNTY	ROUTE	PROJECT	SHEET
5-0	LEHIGH	I-78		

WEISENBERG TOWNSHIP
REVISIONS

NOTE: NEW WORK SHOWN WITH A CLOUD.

TABULATION OF QUANTITIES		
ITEM	UNIT	QUANTITY
POST MOUNTED SIGNS, TYPE A, LOGO	SQ.FT.	–
POST MOUNTED SIGNS, TYPE B, LOGO	SQ.FT.	–
POST MOUNTED SIGNS, TYPE C, LOGO	SQ.FT.	–
BREAKAWAY SYSTEMS	EACH	–
* STEEL S OR W BEAM POSTS	LBS.	–
LOGO SIGN MOUNTING	EACH	–
FLAT SHEET PANEL REPLACEMENT	SQ. FT.	
EXTRUDED PANEL REPLACEMENT	SQ. FT.	
REMOVAL OF POST MOUNTED MOTORIST SERVICE SIGNS, TYPES B, C & F	L.S.	–

* APPROXIMATE QUANTITY FOR INFORMATION ONLY

SYMBOLS
- ○ Existing Sign to Remain
- △ Existing Sign to be Removed
- □ Existing Sign Reset as Shown
- ● NEW SIGN
- × FUTURE SIGN
- Ø Existing Utility Pole

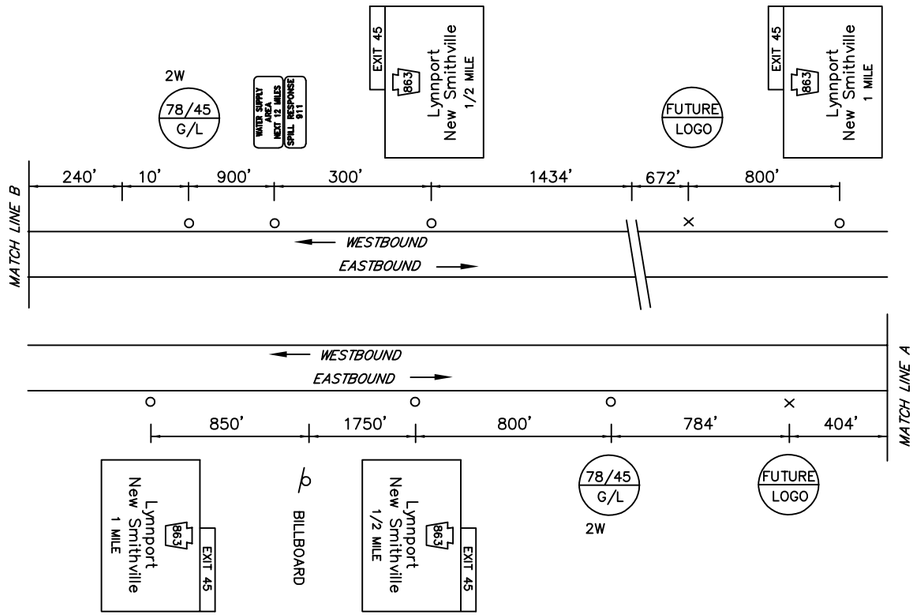

MAINLINE SCHEMATIC
NOT TO SCALE

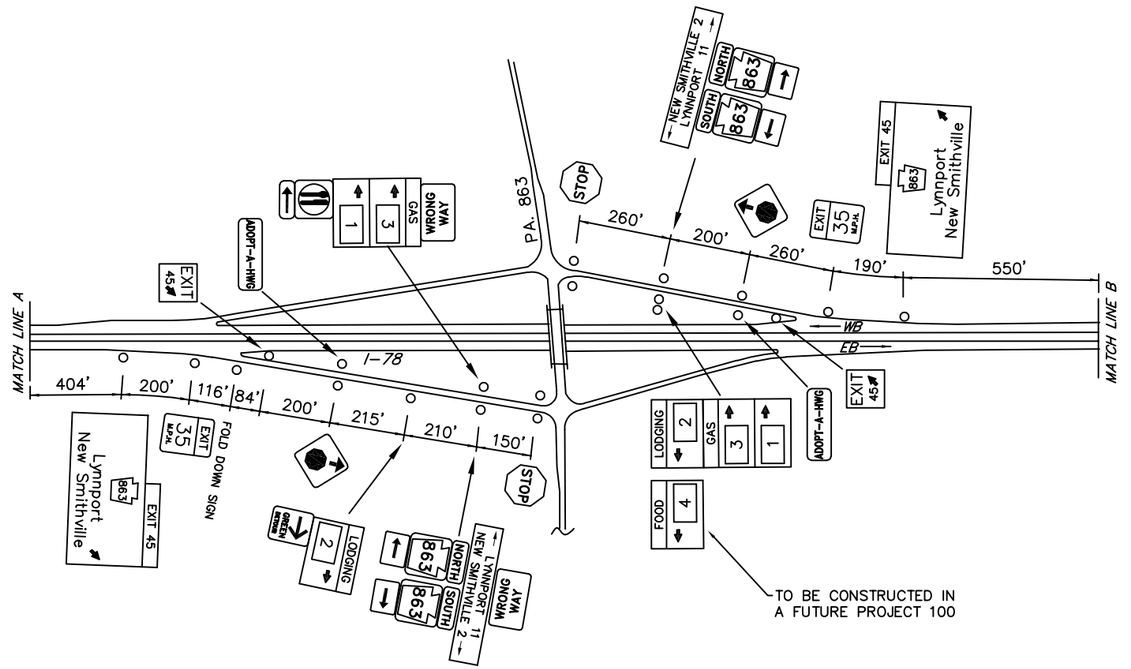

SCHEMATIC PLAN
NOT TO SCALE

DO NOT CLOSE OR RESTRICT TRAVEL LANES
BETWEEN 6:00 AM AND 9:00 AM, AND
BETWEEN 3:00 PM AND 6:00 PM, MONDAY THRU FRIDAY.
DO NOT WORK DURING HOLIDAY PERIODS.

EXIT 45 SPECIFIC INFORMATION PANEL			
LEGEND	DIRECTION	BUSINESS	LOGO NO.
GAS	EB/WB	SUNOCO (24 HRS/DIESEL)	3
		SHEETZ (DIESEL)	1
LODGING	EB/WB	SUPER 8	2
FOOD	EB/WB	DUNKIN	4

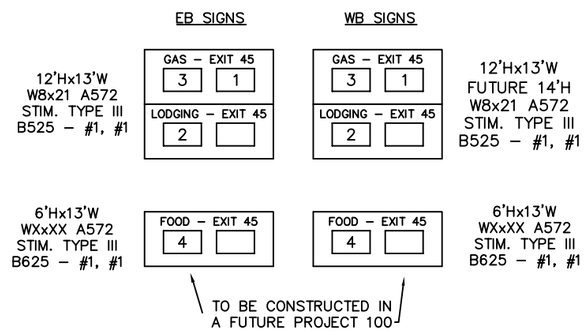

INTERSTATE 78

NEW SMITHVILLE
EXIT 45

\\DAVOSD.CC\DATA\PROJECTS\085.0283\323976-01\V1\PSE\AS-BUILT DRAWINGS\PENNDOT DISTRICT 05\LEHIGH - 13\US-XX SHTXX-176_EXIT 45 PLAN
January/18/2022 4:05 PM