DISTRICT	COUNTY	ROUTE	PROJECT	SHEET
11-0	ALLEGHENY	I-79		

KENNEDY & ROBINSON TOWNSHIPS

REVISIONS

TABULATION OF QUANTITIES		
ITEM	UNIT	QUANTITY
POST MOUNTED SIGNS, TYPE A, LOGO	SQ.FT.	–
POST MOUNTED SIGNS, TYPE B, LOGO	SQ.FT.	–
POST MOUNTED SIGNS, TYPE C, LOGO	SQ.FT.	–
BREAKAWAY SYSTEMS	EACH	–
* STEEL S OR W BEAM POSTS	LBS.	–
LOGO SIGN MOUNTING	EACH	–

* APPROXIMATE QUANTITY FOR INFORMATION ONLY

SYMBOLS

- ○ *Existing Sign to Remain*
- △ *Existing Sign to be Removed*
- □ *Existing Sign Reset as Shown*
- ● NEW SIGN
- × FUTURE SIGN
- Ø *Existing Utility Pole*

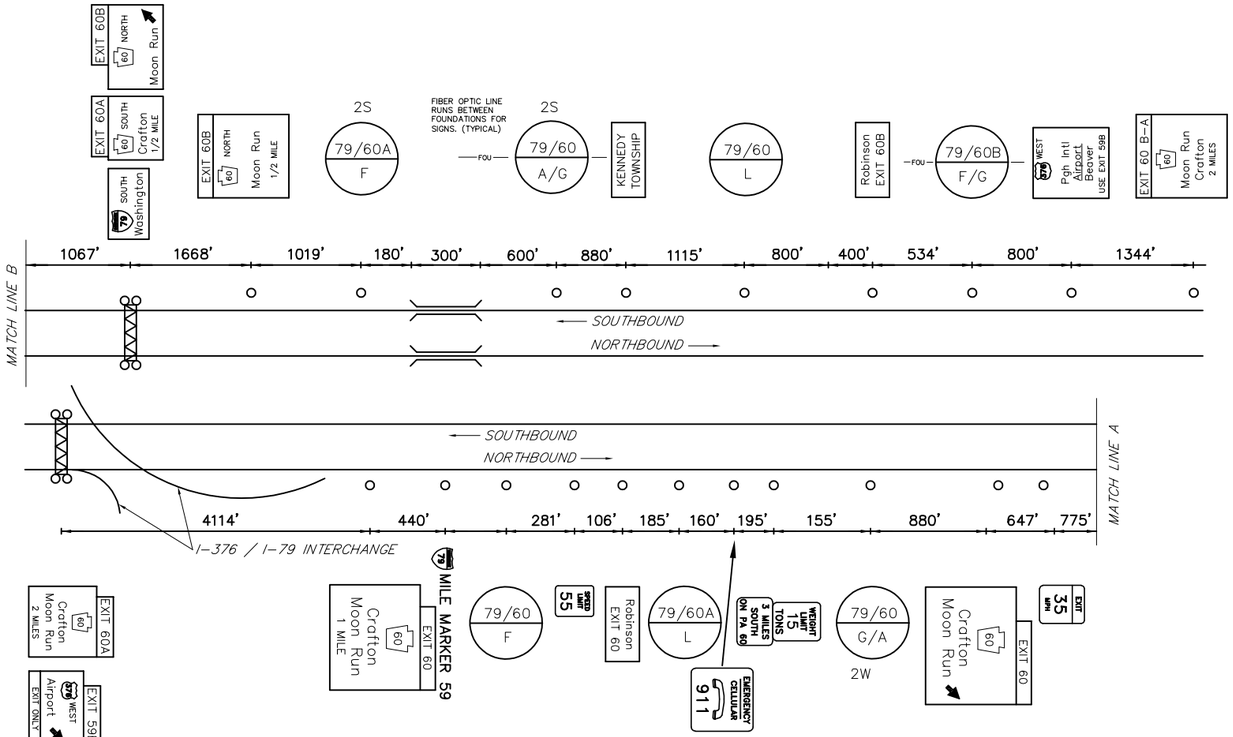

MAINLINE SCHEMATIC
NOT TO SCALE

WORK ONLY BETWEEN 9:00 AM AND 3:00 PM.
CONTACT DISTRICT 11-0
FOR ADDITIONAL TRAFFIC CONTROL REQUIREMENTS.

LEGEND

2S/2W – GUIDE RAIL

EXIT 60/60A/60B SPECIFIC INFORMATION PANEL			
LEGEND	DIRECTION	BUSINESS	LOGO NO.
GAS	NB/60A SB	GETGO	1
	60B SB	SHEETZ	11
FOOD	NB/60A SB	GETGO	2
		PRIMANTI BROS	3
		SPEEDY CAFE	9
	NB/60B SB		
		SHEETZ	10
LODGING	NB/60A SB	MOTEL 6	6
		HILLTOP INN	8
	NB/60B SB		
	NB		
ATTRACTION	NB/60B SB	THE MALL AT ROBINSON	7

NB SIGNS

12'Hx13'W FUTURE 16'H W14x30 3M TYPE III B650 – #1, #1
GAS – EXIT 60: 1
ATTRACTION–EXIT 60: 7

10'Hx19'W W8x18 3M TYPE III B525 – #2, #2
LODGING – EXIT 60: 4 X 6 / 8

10'Hx13'W FUTURE 16'H W10x26 A572 3M TYPE III SBM – 650
FOOD – EXIT 60: 2 3 / 9 10

SB SIGNS

10'Hx13'W FUTURE 16'H W14x30 A572 3M TYPE III SBM – 650
FOOD – EXIT 60A: 2 3 / 9

12'Hx13'W FUTURE 16'H W18x40 A572 3M TYPE III SBM – 650
ATTRACTION–EXIT 60B: 7
GAS – EXIT 60 A: 1

12'Hx19'W W12x26 3M TYPE III B650 – #2, #2
LODGING – EXIT 60 B: X
LODGING – EXIT 60 A: 6 8

12'Hx19'W W14x30 A572 3M TYPE III SBM – 650
FOOD – EXIT 60 B: 10
GAS – EXIT 60 B: 11

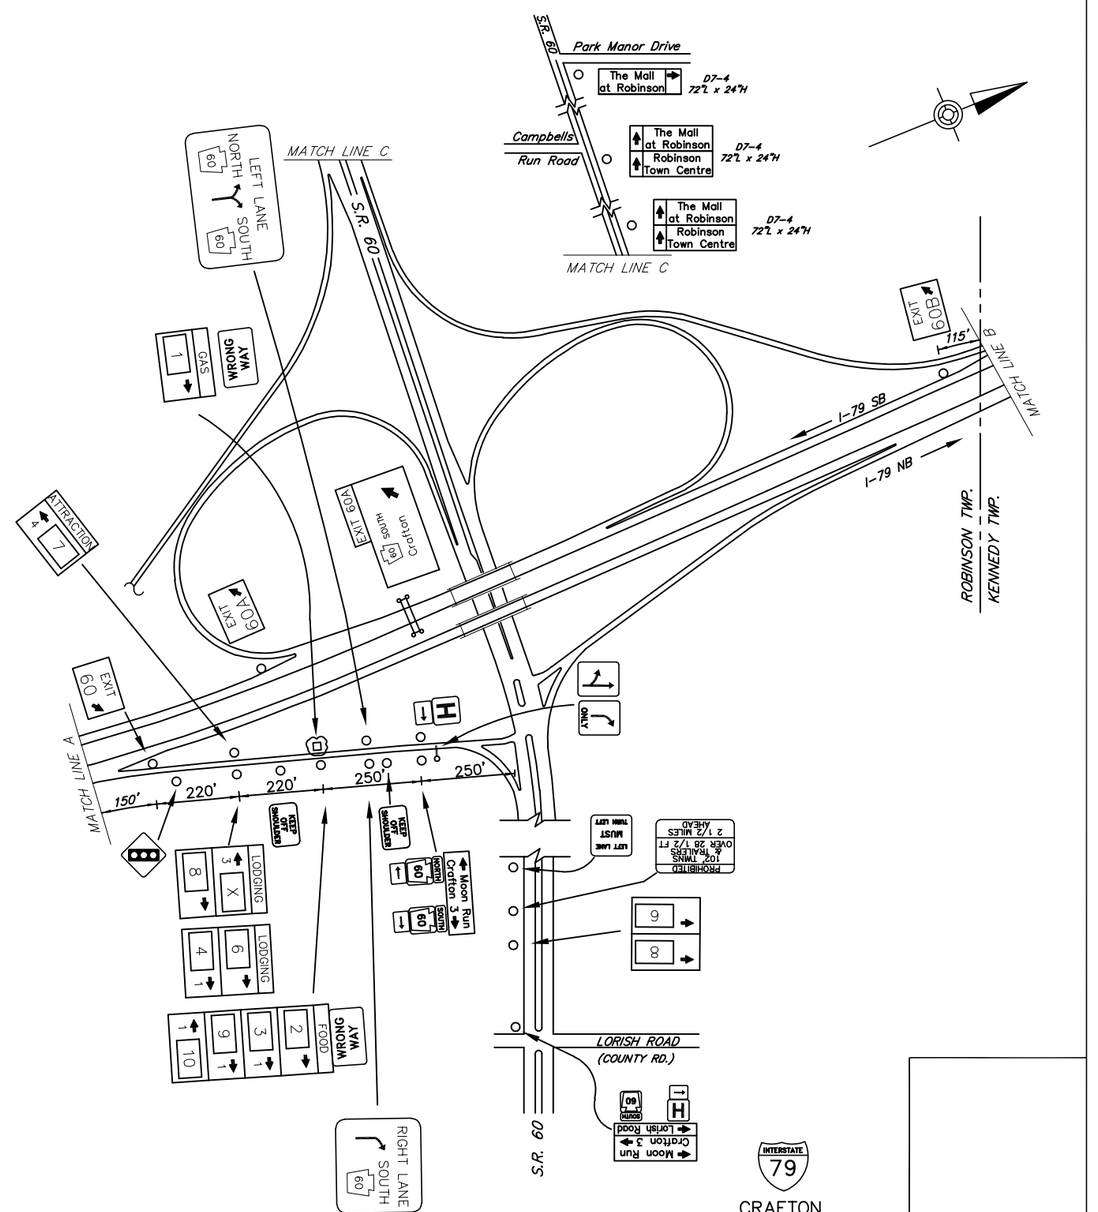

SCHEMATIC PLAN
NOT TO SCALE

INTERSTATE 79
CRAFTON
EXIT 60

\\DAV2016\C:\DATA\PROJECTS\2015_ED85\215076-01\MKV\PSEC\AS-BUILT DRAWINGS\PENNDOT DISTRICT 11\ALLEGHENY - 02\10-XX SHTXX 179_EXIT 60 PLAN
January/19/2022 1:31 PM