DISTRICT	COUNTY	ROUTE	PROJECT	SHEET
4-0	LUZERNE	I-81		
BUTLER, HAZLE & SUGAR LOAF TWPS. & WEST HAZLETON BORO				
REVISIONS				

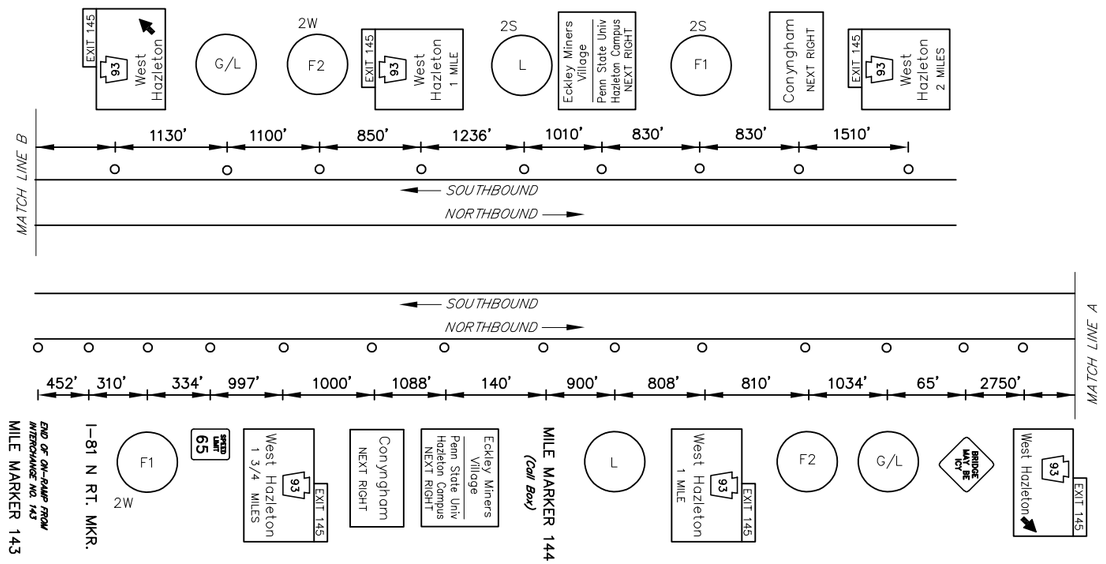

MAINLINE SCHEMATIC
NOT TO SCALE

LEGEND

2S/2W – GUIDE RAIL

FREEWAY LANE CLOSURES & RESTRICTIONS ONLY PERMITTED BETWEEN 9:00 PM AND 6:00 AM MONDAY THRU FRIDAY.
WORK ALONG FREEWAY PERMITTED BETWEEN 9:00 AM AND 2:30 PM, UNLESS OTHERWISE APPROVED BY ENGINEERING DISTRICT.
DO NOT WORK DURING HOLIDAY PERIODS.
IF APPLICABLE, REINSTALL GUIDERAIL AT END OF EACH DAY.

EXIT 145 SPECIFIC INFORMATION PANEL			
LEGEND	DIRECTION	BUSINESS	LOGO NO.
GAS	NB/SB	TURKEY HILL	15
FOOD	NB/SB	McDONALD'S	2
		DAMON'S GRILL	11
		PERKINS FAMILY RESTAURANT	12
		TOM'S KITCHEN	16
		DENNY'S (24 HRS)	6
		WENDY'S	18
		TACO BELL	19
		POPEYE'S	20
		PANERA BREAD CAFE	21
		STARBUCKS	22
LODGING	NB/SB	RED ROOF INN & SUITES	4
		FOREST HILL INN	5
		COMFORT INN	7
		RED CARPET INN	9
		FAIRFIELD INN & SUITES –MARRIOTT	13
		HAMPTON INN	14
		CANDLEWOOD SUITES	17

TABULATION OF QUANTITIES		
ITEM	UNIT	QUANTITY
POST MOUNTED SIGNS, TYPE A, LOGO	SQ.FT.	–
POST MOUNTED SIGNS, TYPE A, LOGO (MODIFIED)	SQ.FT.	–
POST MOUNTED SIGNS, TYPE C, LOGO	SQ.FT.	
BREAKAWAY SYSTEMS	EACH	–
* STEEL S OR W BEAM POSTS	LBS.	–
LOGO SIGN MOUNTING	EACH	–
LOGO SIGN MOUNTING, RESET	EACH	–
REMOVE POST MOUNTED SIGNS, TYPE A, LOGO (MODIFIED)	EACH	–
REMOVAL OF POST MOUNTED MOTORIST SERVICE SIGNS, TYPES B, C & F	L.S.	

* APPROXIMATE QUANTITY FOR INFORMATION ONLY

SYMBOLS
- Existing Sign to Remain
- Existing Sign to be Removed
- Existing Sign Reset as Shown
- Existing Sign Foundation
- NEW SIGN
- FUTURE SIGN
- Existing Utility Pole

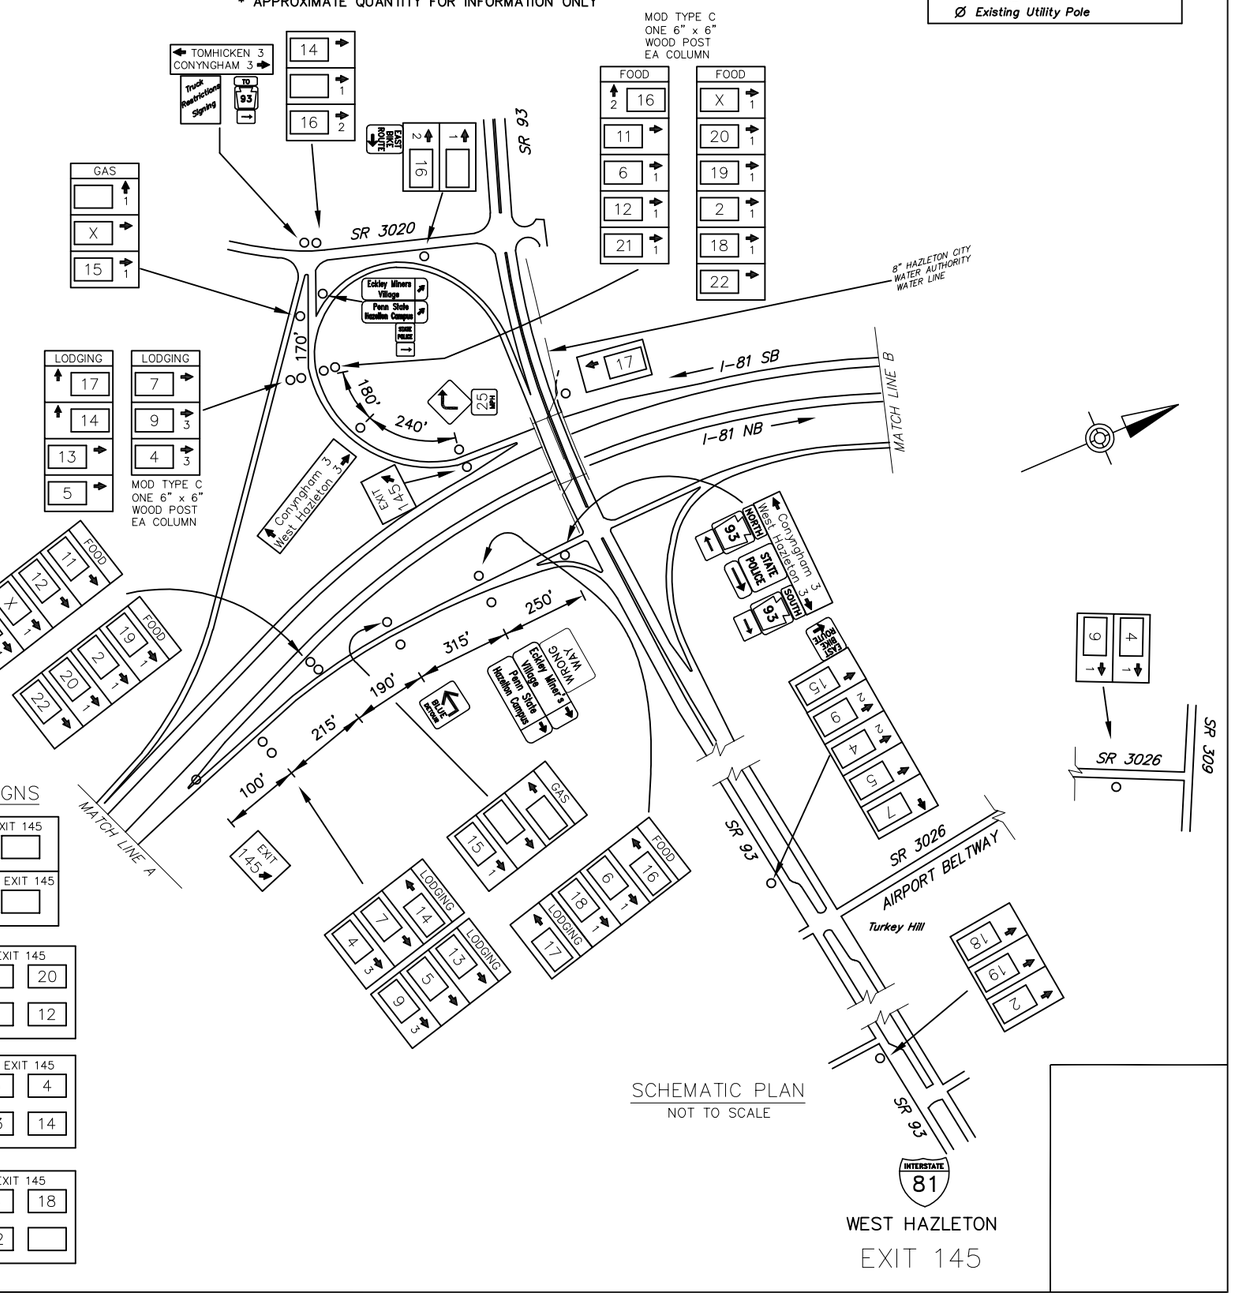

SCHEMATIC PLAN
NOT TO SCALE

NB SIGNS

			SB SIGNS
GAS – EXIT 145: X, 15 LODGING – EXIT 145: 17	12'Hx13'W W8x21 A572 3M TYPE III B525 – #2, #1	12'Hx13'W FUTURE 16'H W18x40 A572 AVERY TYPE IV B650 – #4, #4	GAS – EXIT 145: 15 LODGING – EXIT 145: 17
FOOD – EXIT 145: 16, 6, 18; 21, 22	F2 12'Hx19'W W18x40 A572 3M TYPE III B650 – #2, #1	F2 10'Hx19'W #1 W12x26 #2 W12x22 AVERY TYPE IV B650 – #1, #2	FOOD – EXIT 145: 19, 2, 20; X, 11, 12
LODGING – EXIT 145: 7, 5, 4; 9, 13, 14	10'Hx19'W W12x26 A572 AVERY TYPE IV B650 – #2, #1	10'Hx19'W W12x26 A572 AVERY TYPE IV B650 – #1, #2	LODGING – EXIT 145: 7, 5, 4; 9, 13, 14
FOOD – EXIT 145: 19, 2, 20; X, 11, 12	F1 10'Hx19'W W10x22 A572 3M TYPE III B650 – #2, #2	F1 10'Hx19'W FUTURE 12'H W18x40 A572 3M TYPE III B650 – #2, #2	FOOD – EXIT 145: 16, 6, 18; 21, 22

\\DAWDDFC\DATA\PROJECTS\2015\D3B5-215976-01\WW\PSE\AS-BUILT DRAWINGS\PENNDOT DISTRICT 04\LUZERNE - 40-10-XX SHTXX-I81_EXIT 145 PLAN
January/31/2022 10:33 AM