DISTRICT	COUNTY	ROUTE	PROJECT	SHEET
4-0	LUZERNE	I-81		

CITY OF WILKES-BARRE
PLAINS & WILKES-BARRE TOWNSHIPS

REVISIONS

TABULATION OF QUANTITIES		
ITEM	UNIT	QUANTITY
POST MOUNTED SIGNS, TYPE A, LOGO	SQ.FT.	
POST MOUNTED SIGNS, TYPE A, LOGO (MODIFIED)	SQ.FT.	
POST MOUNTED SIGNS, TYPE C, LOGO	SQ.FT.	
BREAKAWAY SYSTEMS	EACH	–
* STEEL S OR W BEAM POSTS	LBS.	–
LOGO SIGN MOUNTING	EACH	
LOGO SIGN MOUNTING, RESET	EACH	
REMOVAL OF POST MOUNTED MOTORIST SERVICE SIGNS, TYPES A & E	EACH	–
REMOVAL OF POST MOUNTED MOTORIST SERVICE SIGNS, TYPES B, C & F	L.S.	

* APPROXIMATE QUANTITY FOR INFORMATION ONLY

SYMBOLS

- ○ *Existing Sign to Remain*
- △ *Existing Sign to be Removed*
- □ *Existing Sign Reset as Shown*
- ◪ *Existing Sign Foundation*
- ● NEW SIGN
- × FUTURE SIGN
- Ø *Existing Utility Pole*

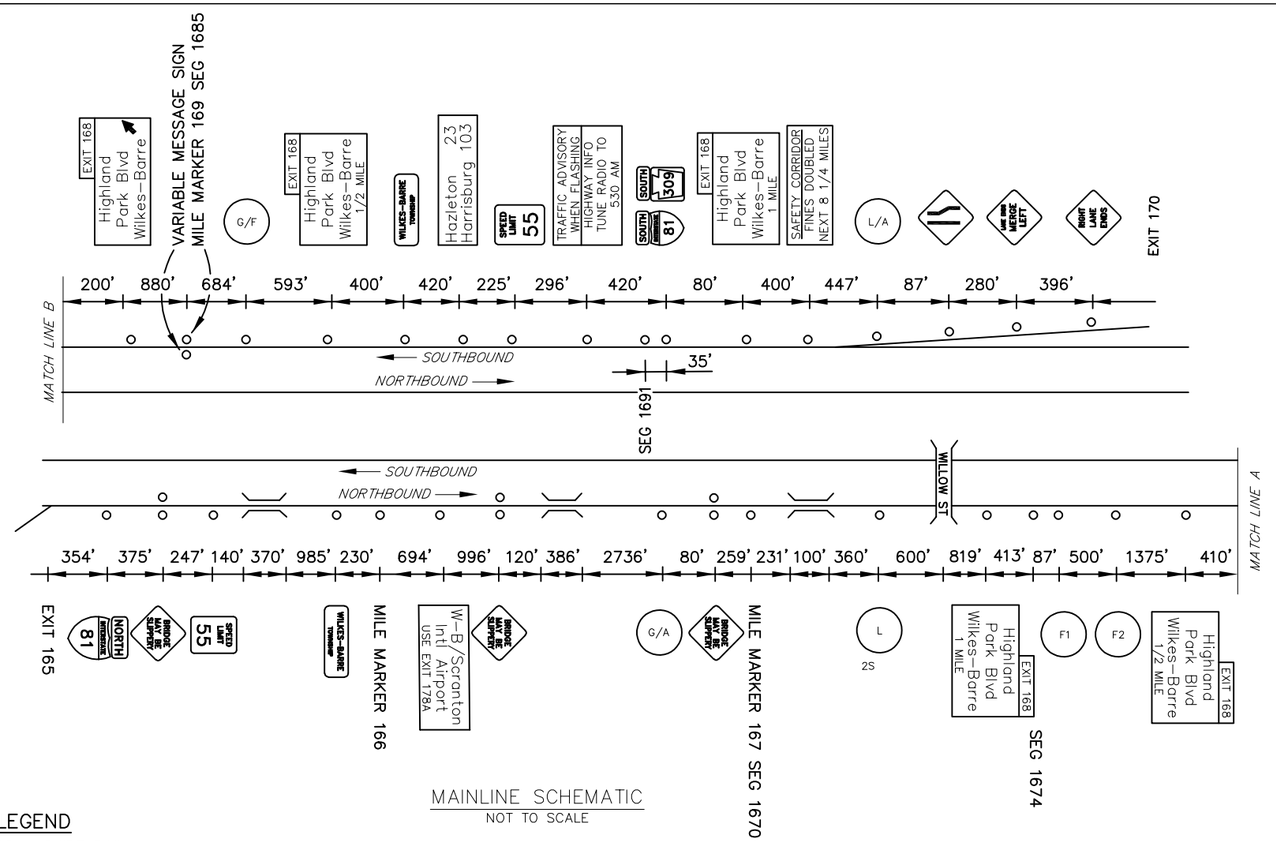

MAINLINE SCHEMATIC
NOT TO SCALE

LEGEND

2S – GUIDE RAIL

FREEWAY LANE CLOSURES & RESTRICTIONS ONLY PERMITTED BETWEEN 9:00 PM AND 6:00 AM MONDAY THRU FRIDAY. WORK ALONG FREEWAY PERMITTED BETWEEN 9:00 AM AND 2:30 PM, UNLESS OTHERWISE APPROVED BY ENGINEERING DISTRICT. DO NOT WORK DURING HOLIDAY PERIODS. IF APPLICABLE, REINSTALL GUIDERAIL AT END OF EACH DAY.

EXIT 168 SPECIFIC INFORMATION PANEL			
LEGEND	DIRECTION	BUSINESS	LOGO NO.
GAS	NB/SB	SHEETZ	1
FOOD	NB	GROTTO PIZZA	4
		PANERA	3
		CHICK-FIL-A (CLOSED SUNDAYS)	14
		WENDY'S	17
	NB/SB	WEGMAN'S MARKET CAFE	2
		RED ROBIN	15
		CRACKER BARREL	18
		APPLEBEE'S	20
LODGING	NB		
		HOME 2 SUITES	12
	NB/SB	COURTYARD – MARRIOTT	6
		MOTEL 6	7
		HILTON GARDEN INN	8
		HAMPTON INN & SUITES	19
		RESIDENCE INN & SUITES	9
ATTRACTION	NB	WYOMING VALLEY MALL	10
		ARENA HUB PLAZA	11
	NB/SB	MOHEGAN SUN ARENA	
			16

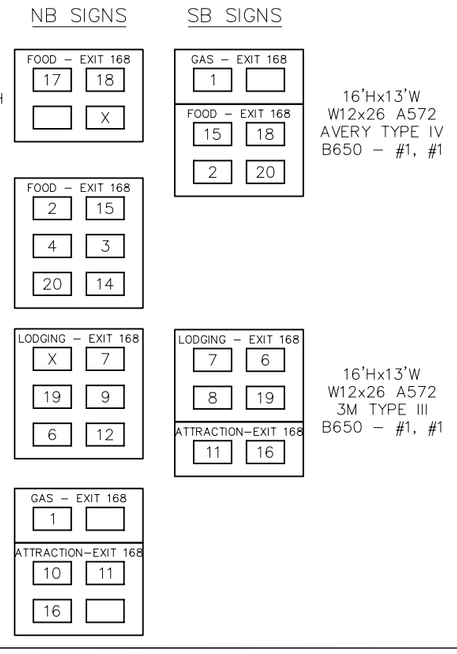

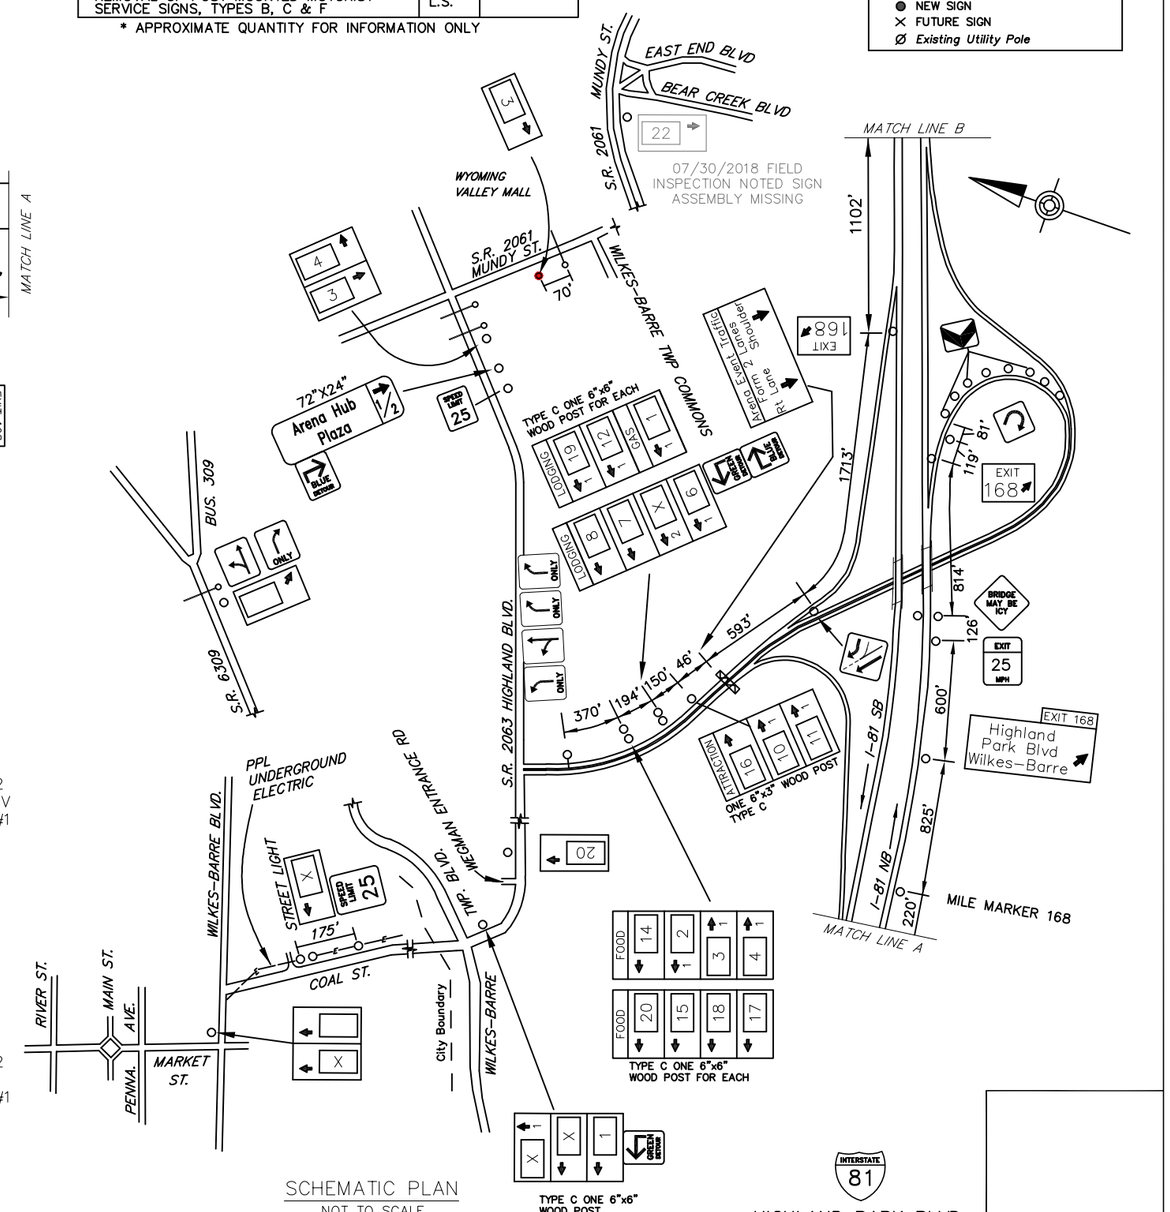

SCHEMATIC PLAN
NOT TO SCALE

INTERSTATE 81

HIGHLAND PARK BLVD
EXIT 168

\\DAVID2\CC\DATA\PROJECTS\0015\DES\315076-GU\WORKFILES\AS-BUILT DRAWINGS\PENNDOT DISTRICT 04\LUZERNE - 40\0-XX SHTXX-IBL_EXIT 168 PLAN
January/19/2022 11:22 AM