DISTRICT	COUNTY	ROUTE	PROJECT	SHEET
8-0	CUMBERLAND	I-81		

MIDDLESEX TOWNSHIP

REVISIONS

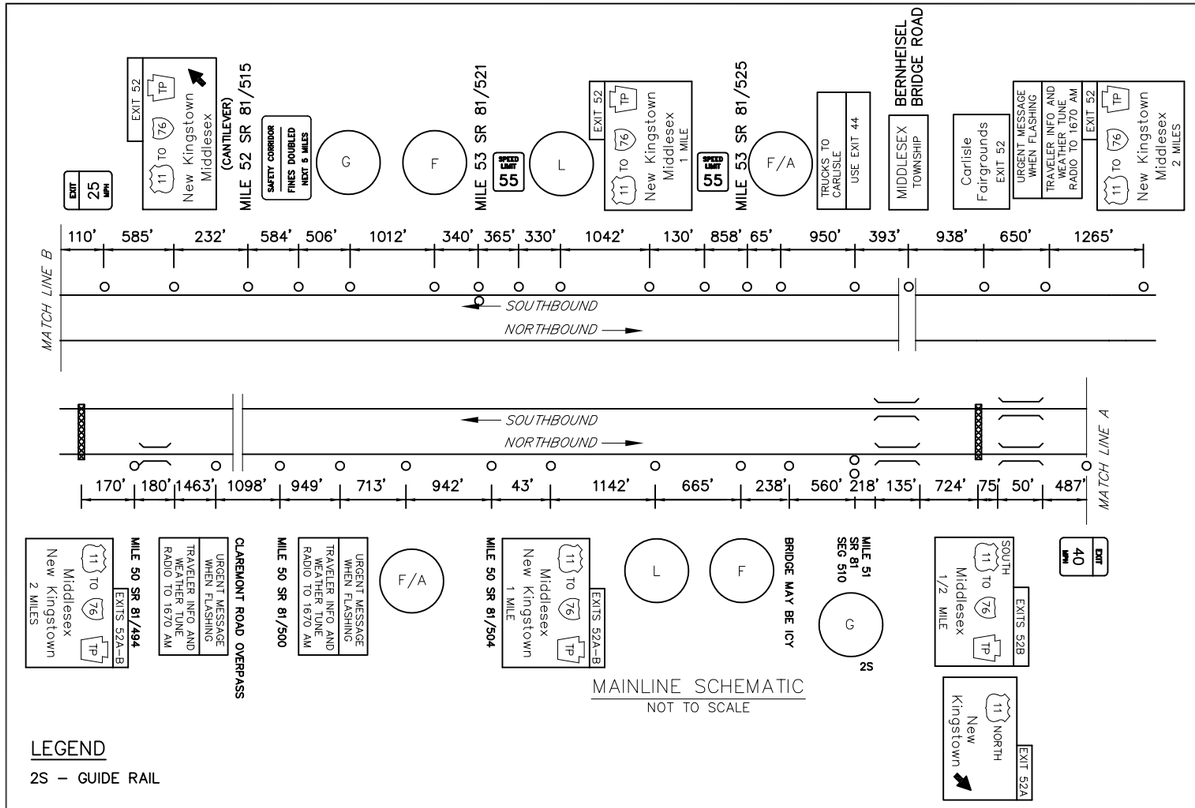

MAINLINE SCHEMATIC

NOT TO SCALE

LEGEND

2S – GUIDE RAIL

FREEWAY LANE CLOSURES & RESTRICTIONS ONLY PERMITTED BETWEEN 9:00 PM AND 6:00 AM MONDAY THRU FRIDAY. WORK ALONG FREEWAY PERMITTED BETWEEN 9:00 AM AND 2:30 PM, UNLESS OTHERWISE APPROVED BY ENGINEERING DISTRICT. DO NOT WORK DURING HOLIDAY PERIODS. IF APPLICABLE, REINSTALL GUIDERAIL AT END OF EACH DAY.

EXIT 52 SPECIFIC INFORMATION PANEL			
LEGEND	DIRECTION	BUSINESS	LOGO NO.
GAS	NB/SB	GULF (DIESEL)	1
		SUNOCO (24HRS/DIESEL)	2
		FLYING J (24 HRS)	5
		LOVE TRAVEL STOPS	3
		SHEETZ (DIESEL)	25
FOOD	NB/SB	DUNKIN'	6
		SUBWAY	13
		DENNY'S	14
		WAFFLE HOUSE (24 HRS)	22
		McDONALD'S	23
		HICKORY RIDGE RESTAURANT	27
	SB	MIDDLESEX DINER (24 HRS)	7
		ARBY'S	12
LODGING	NB/SB	MOTEL 6	28
		DAYS INN – WYNDHAM	18
		ECONO LODGE	19
		RED ROOF	24
		COMFORT INN	11
	SB	SUPER 8	21
ATTRACTION	NB/SB	SPORTS EMPORIUM	4

TABULATION OF QUANTITIES		
ITEM	UNIT	QUANTITY
POST MOUNTED SIGNS, TYPE A, LOGO	SQ.FT.	–
POST MOUNTED SIGNS, TYPE A, LOGO (MODIFIED)	SQ.FT.	–
POST MOUNTED SIGNS, TYPE C, LOGO	SQ.FT.	–
BREAKAWAY SYSTEMS	EACH	–
* STEEL S OR W BEAM POSTS	LBS.	–
LOGO SIGN MOUNTING	EACH	–
LOGO SIGN MOUNTING, RESET	EACH	–
REMOVAL OF POST MOUNTED MOTORIST SERVICE SIGNS, TYPES A & E	EACH	–
REMOVAL OF POST MOUNTED MOTORIST SERVICE SIGNS, TYPES B, C & F	L.S.	–

* APPROXIMATE QUANTITY FOR INFORMATION ONLY

SYMBOLS

- ○ *Existing Sign to Remain*
- △ *Existing Sign to be Removed*
- □ *Existing Sign Reset as Shown*
- ● NEW SIGN
- × FUTURE SIGN
- Ø *Existing Utility Pole*

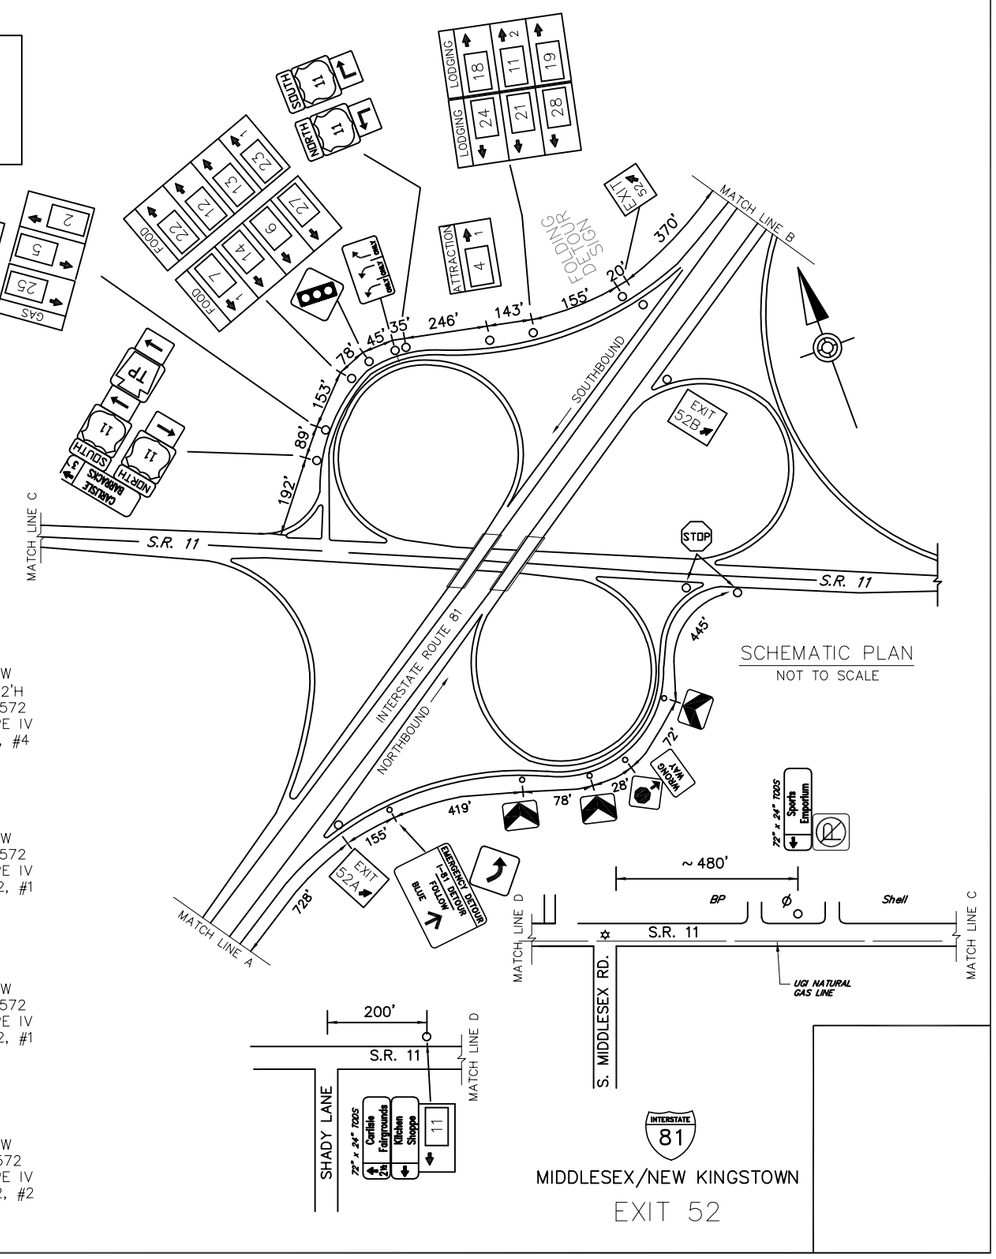

SCHEMATIC PLAN

NOT TO SCALE

MIDDLESEX/NEW KINGSTOWN

EXIT 52

NB SIGNS

SB SIGNS

16'Hx13'W W14x30 A572 STIM. TYPE IV B650 – #1, #1

GAS – EXIT 52A: 25 5

GAS – EXIT 52B: 2 1 / 3

GAS – EXIT 52: 2 1 5 / 25 3

10'Hx19'W FUTURE 12'H W14x30 A572 AVERY TYPE IV B650– #4, #4

12'Hx19'W FUTURE 16'H W14x30 AVERY TYPE IV B650 – #2, #2

FOOD – EXIT 52A: 27 14

FOOD – EXIT 52B: 13 22 23

FOOD – EXIT 52: 13 22 6 / 14 12 7

10'Hx19'W W10x26 A572 AVERY TYPE IV B650 – #2, #1

16'Hx13'W W10x26 AVERY TYPE IV B650 – #1, #1

LODGING – EXIT 52A: 28 24

LODGING – EXIT 52B: 18 19 / 11

LODGING – EXIT 52: 18 19 11 / 24 21 28

10'Hx19'W W10x26 A572 AVERY TYPE IV B650 – #2, #1

12'Hx13'W W8x21 AVERY TYPE IV B525 – #1, #1

FOOD–EXIT 52B: X

ATTRACTION–EXIT 52B: 4

FOOD–EXIT 52: 23 27

ATTRACTION–EXIT 52: 4

12'Hx13'W W8x18 A572 AVERY TYPE IV B525 – #2, #2

\\DAVID2\CC\DATA\PROJECTS\2015\08\D0815205\26976-01\WH\PSE\AS-BUILT DRAWINGS\PENNDOT DISTRICT 08\CUMBERLAND - 21\10-XX SHTX IBL_EXIT 52 PLAN
January/17/2022 11:21 AM