DISTRICT	COUNTY	ROUTE	PROJECT	SHEET
8-0	DAUPHIN	I-81	XXX-XX	X OF X
LOWER PAXTON & WEST HANOVER TOWNSHIPS				
REVISIONS				

TABULATION OF QUANTITIES		
ITEM	UNIT	QUANTITY
POST MOUNTED SIGNS, TYPE A, LOGO	SQ.FT.	–
POST MOUNTED SIGNS, TYPE B, LOGO	SQ.FT.	–
POST MOUNTED SIGNS, TYPE C, LOGO	SQ.FT.	–
BREAKAWAY SYSTEMS	EACH	–
* STEEL S OR W BEAM POSTS	LBS.	–
LOGO SIGN MOUNTING	EACH	–
EXTRUDED PANEL REPLACEMENT	SQ.FT.	
REMOVAL OF POST MOUNTED MOTORIST SERVICE SIGNS, TYPES B, C & F	L.S.	

* APPROXIMATE QUANTITY FOR INFORMATION ONLY

SYMBOLS

- ○ *Existing Sign to Remain*
- △ *Existing Sign to be Removed*
- □ *Existing Sign Reset as Shown*
- ● NEW SIGN
- × FUTURE SIGN
- Ø *Existing Utility Pole*

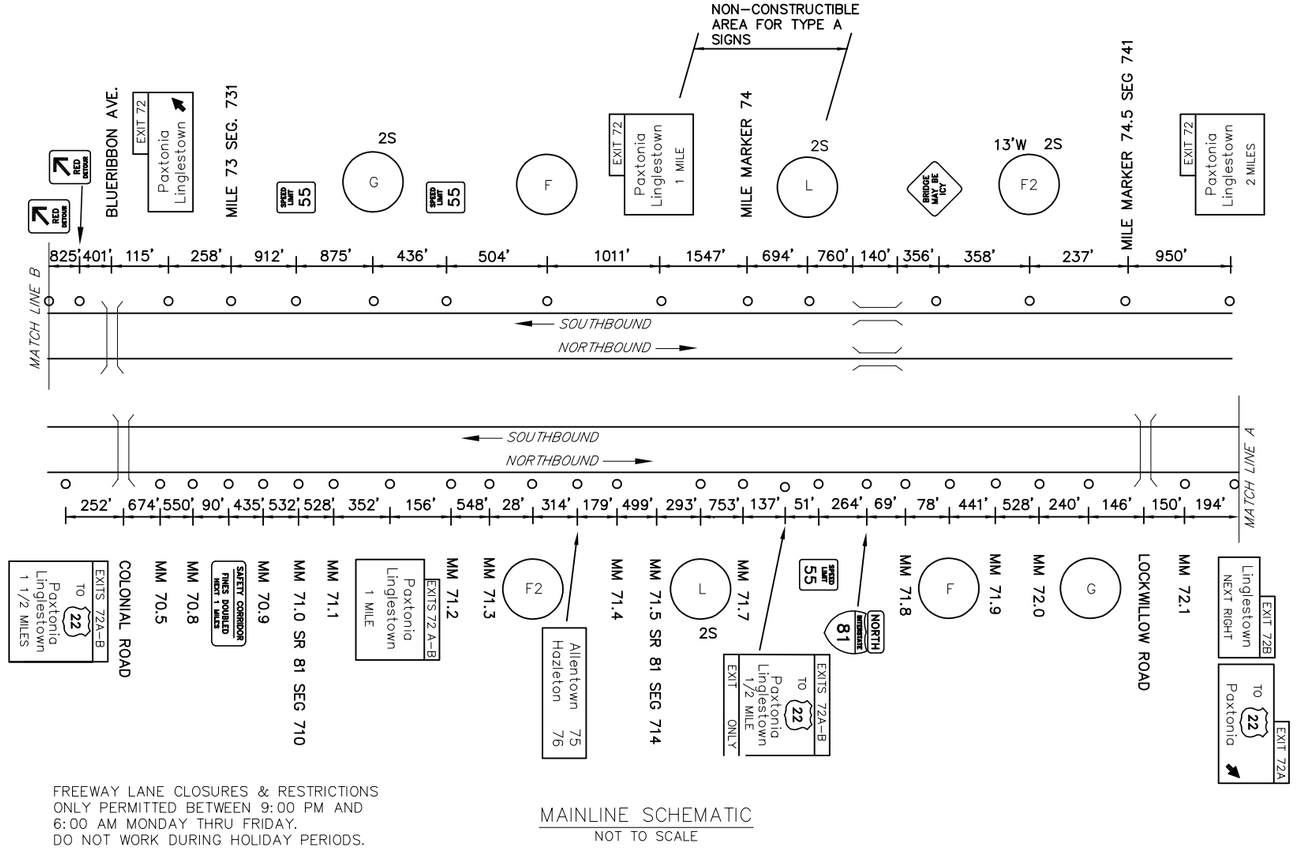

MAINLINE SCHEMATIC
NOT TO SCALE

FREEWAY LANE CLOSURES & RESTRICTIONS
ONLY PERMITTED BETWEEN 9:00 PM AND
6:00 AM MONDAY THRU FRIDAY.
DO NOT WORK DURING HOLIDAY PERIODS.

EXIT 72 SPECIFIC INFORMATION PANEL			
LEGEND	DIRECTION	BUSINESS	LOGO NO.
GAS	72A NB/SB	SUNOCO (24 HRS/DIESEL)	12
		SHEETZ (DIESEL)	11
	72B NB/SB	TURKEY HILL	9
FOOD	72A NB/SB	McDONALD'S	2
		ARBY'S	4
		RED ROBIN	14
		WENDY'S	3
		STARBUCKS	1
		GRILL 22	16
		MISSION BBQ	18
LODGING	72A NB/SB	BAYMONT INN & SUITES BY WYNDHAM	7
		QUALITY INN	8
		SLEEP INN & SUITES	13
	72B NB/SB	RAMADA	5
		CANDLEWOOD SUITES	6

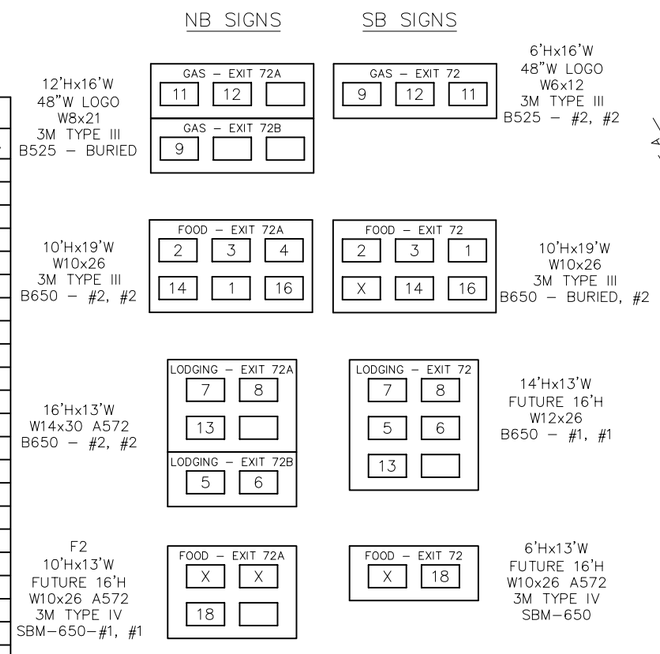

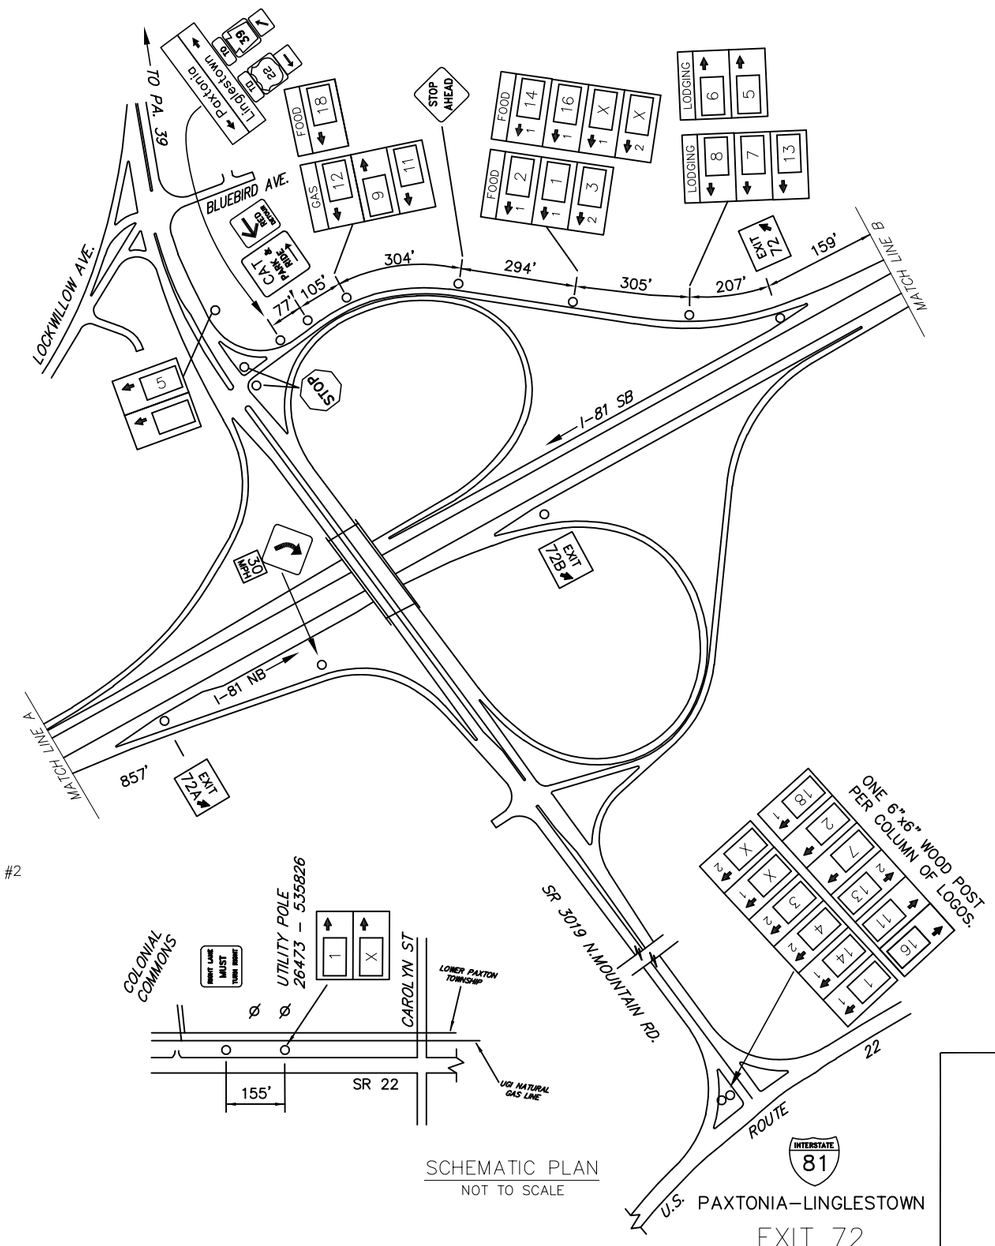

SCHEMATIC PLAN
NOT TO SCALE

\\DAVIDDC\DATA\PROJECTS\0015\0285\215976-R1\PW\PSE\AS-BUILT DRAWINGS\PENNDOT DISTRICT 08\DAUPHIN - 22\SHTXX-I81_EXIT 72 PLAN
January/19/2022 11:19 AM