DISTRICT	COUNTY	ROUTE	PROJECT	SHEET
2-0	CENTRE	I-99		1 OF 2
COLLEGE AND PATTON TOWNSHIP				
REVISIONS				

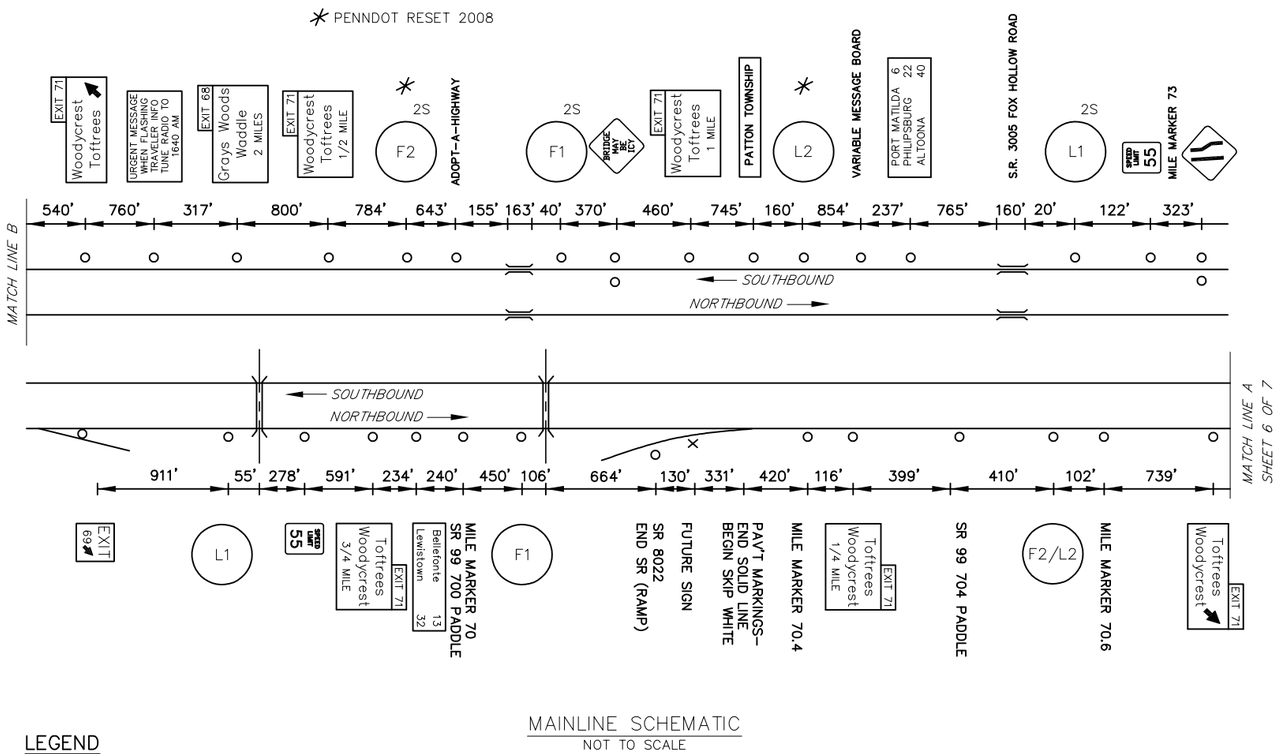

MAINLINE SCHEMATIC
NOT TO SCALE

TABULATION OF QUANTITIES		
ITEM	UNIT	QUANTITY
POST MOUNTED SIGNS, TYPE A, LOGO	SQ.FT.	–
POST MOUNTED SIGNS, TYPE B, LOGO	SQ.FT.	–
POST MOUNTED SIGNS, TYPE C, LOGO	SQ.FT.	–
BREAKAWAY SYSTEMS	EACH	–
* STEEL S OR W BEAM POSTS	LBS.	–
LOGO SIGN MOUNTING	EACH	–
EXTRUDED PANEL REPLACEMENT	SQ.FT.	
REMOVAL OF POST MOUNTED MOTORIST SERVICE SIGNS, TYPES B, C & F	L.S.	

* APPROXIMATE QUANTITY FOR INFORMATION ONLY

SYMBOLS

- ○ *Existing Sign to Remain*
- △ *Existing Sign to be Removed*
- □ *Existing Sign Reset as Shown*
- ● NEW SIGN
- × FUTURE SIGN
- Ø *Existing Utility Pole*

LEGEND

2S – GUIDE RAIL

WORK ALONG FREEWAY PERMITTED BETWEEN 9:00 AM AND 2:30 PM, UNLESS OTHERWISE APPROVED BY ENGINEERING DISTRICT. DO NOT WORK DURING HOLIDAY PERIODS. IF APPLICABLE, REINSTALL GUIDERAIL AT END OF EACH DAY.

EXIT 71 SPECIFIC INFORMATION PANEL			
LEGEND	DIRECTION	BUSINESS	LOGO NO.
FOOD	NB/SB	SHEETZ	22
		McDONALD'S (24 HRS)	3
		OLIVE GARDEN	5
		WEGMAN'S MARKET CAFE	13
		APPLEBEE'S	14
		CRACKER BARREL	16
		PANERA BREAD	21
	SB	HOSS'S FAMILY STEAK & SEA HOUSE	4
		THE FIELD RESTAURANT	8
		CHICK-FIL-A (CLOSED SUNDAY)	15
		STARBUCKS	17
LODGING	NB/SB	HAMPTON INN & SUITES	11
		SPRINGHILL SUITES-MARRIOTT	12
		TOFTREES RESORT	1
		CARNEGIE INN & SPA	7
		HOLIDAY INN EXPRESS	9
		QUALITY INN	10
		COMFORT SUITES	18
		SLEEP INN	19
		FAIRFIELD INN & SUITES-MARRIOTT	20
	SB		

NB SIGNS

16'Hx13'W W10x26 TYPE IX LEGEND TYPE III BACKGROUND B650 – #1, #1 F2/L2

FOOD – EXIT 71	
16	21
LODGING – EXIT 71	
20	18
19	

14'Hx13'W W10x22 A572 AVERY TYPE III B650 – #1, #1 F1

FOOD–NEXT RIGHT	
13	22
3	X
14	5

14'Hx13'W W10x22 A572 AVERY TYPE III B650 – #1, #2 L1

LODGING–NEXT RIGHT	
9	11
12	1
7	10

SB SIGNS

FOOD–NEXT RIGHT	
13	3
4	5
X	8

14'Hx13'W W8x21 B525 – #1, #2 F2

FOOD – EXIT 71	
15	16
17	14
21	22

14'Hx13'W FUTURE 16'H W10x26 A572 TYPE IX LEGEND TYPE III BACKGROUND B650 – #1, #1 F1

LODGING–NEXT RIGHT	
1	7
9	10
11	12

14'Hx13'W W10x22 A572 3M TYPE III B650 – #1, #1 L2

LODGING – EXIT 71	
18	19
20	

14'Hx13'W FUTURE 16'H W18x40 A572 TYPE IX LEGEND TYPE III BACKGROUND B650 – #2, #2 L1

INTERSTATE 99
TOFTREES
EXIT 71
SHEET 1 OF 2

\\DAWDIDC\DATA\PROJECTS\2015\D2015-215976-01\MW\PSE\AS-BUILT DRAWINGS\PENNDOT DISTRICT 02\CENTRE - 1410-XX SHTXX-I99_EXIT 71 PLAN
January/19/2022 2:46 PM

DISTRICT	COUNTY	ROUTE	PROJECT	SHEET
2-0	CENTRE	I-99		2 OF 2
COLLEGE AND PATTON TOWNSHIP				
REVISIONS				

SYMBOLS

- ○ *Existing Sign to Remain*
- △ *Existing Sign to be Removed*
- □ *Existing Sign Reset as Shown*
- ● NEW SIGN
- × FUTURE SIGN
- Ø *Existing Utility Pole*

EXIT 71 SPECIFIC INFORMATION PANEL			
LEGEND	DIRECTION	BUSINESS	LOGO NO.
FOOD	NB/SB	SHEETZ	22
		McDONALD'S (24 HOURS)	3
		OLIVE GARDEN	5
		WEGMAN'S MARKET CAFE	13
		APPLEBEE'S	14
		CRACKER BARREL	16
		PANERA BREAD	21
	SB	HOSS'S FAMILY STEAK & SEA HOUSE	4
		THE FIELD RESTAURANT	8
		CHICK-FIL-A (CLOSED SUNDAY)	15
		STARBUCKS	17
LODGING	NB/SB	HAMPTON INN & SUITES	11
		SPRINGHILL SUITES-MARRIOTT	12
		TOFTREES RESORT	1
		CARNEGIE INN & SPA	7
		HOLIDAY INN EXPRESS	9
		QUALITY INN	10
		COMFORT SUITES	18
		SLEEP INN	19
		FAIRFIELD INN & SUITES-MARRIOTT	20
	SB		

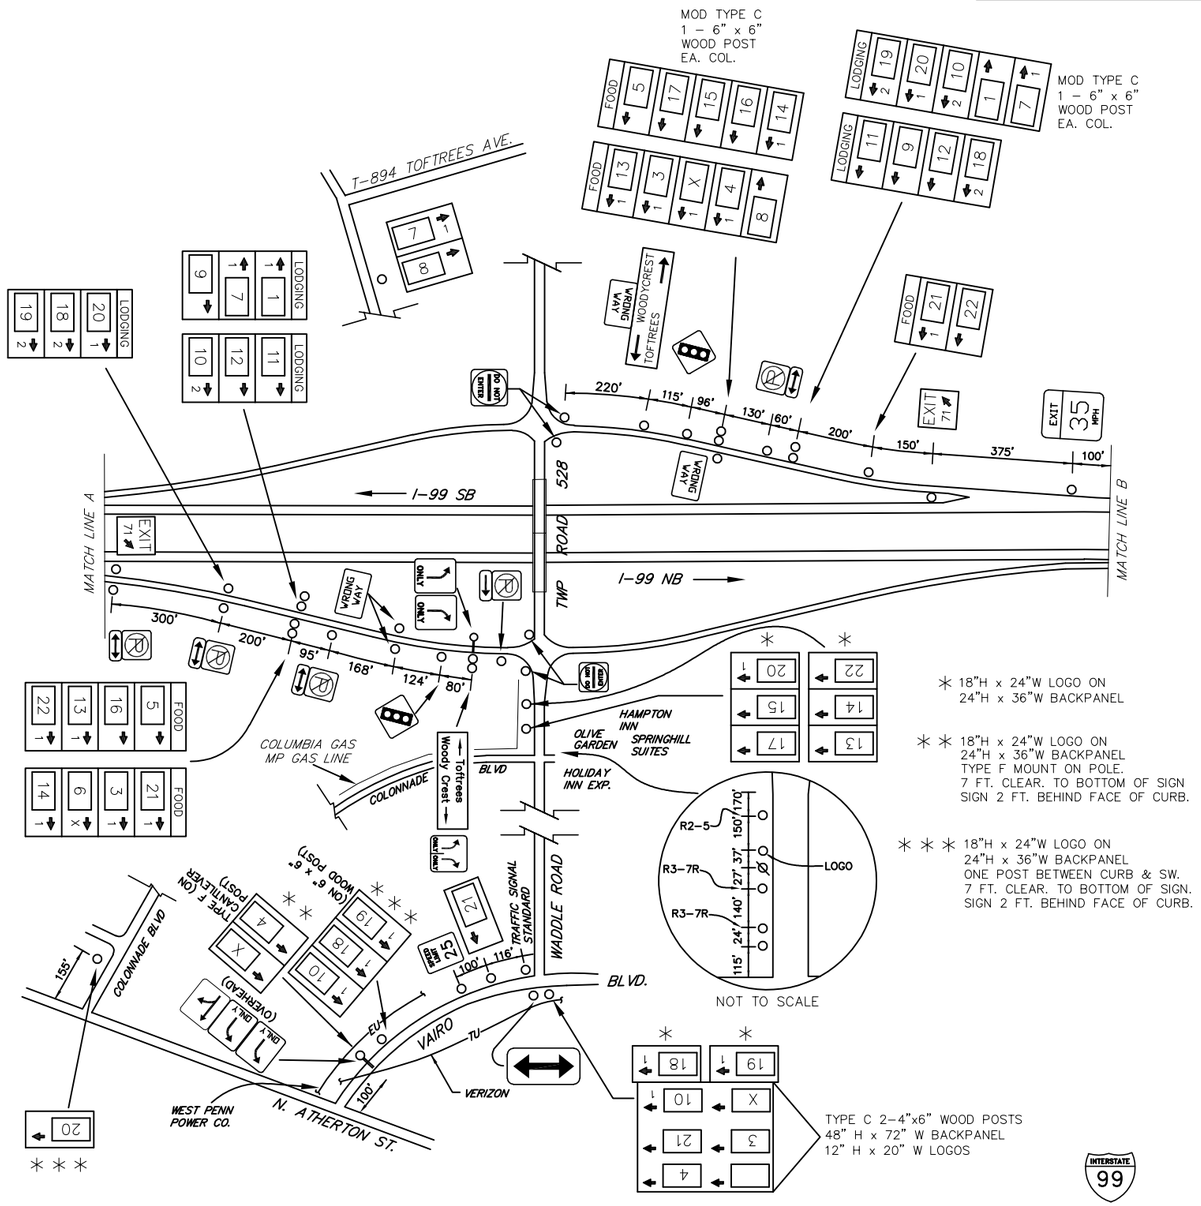

SCHEMATIC PLAN
NOT TO SCALE

INTERSTATE 99
TOFTREES
EXIT 71
SHEET 2 OF 2

\\DAWDIDC\DATA\PROJECTS\2015\D2015-215976-01\MW\PSE\AS-BUILT DRAWINGS\PENNDOT DISTRICT 02\CENTRE - 1410-XX SHTXX-199_EXIT 71 PLAN
January/19/2022 2:47 PM